

S/L #2
 Gethurst
 Sub Div
 113-Pg 24

155.00
 124.07
 279.07 ✓


155.00
 123.34
 278.34 ✓

from Old
 Tax Map BK4-Pg4


6405

VOID THIS COPY

~~POPLAR~~

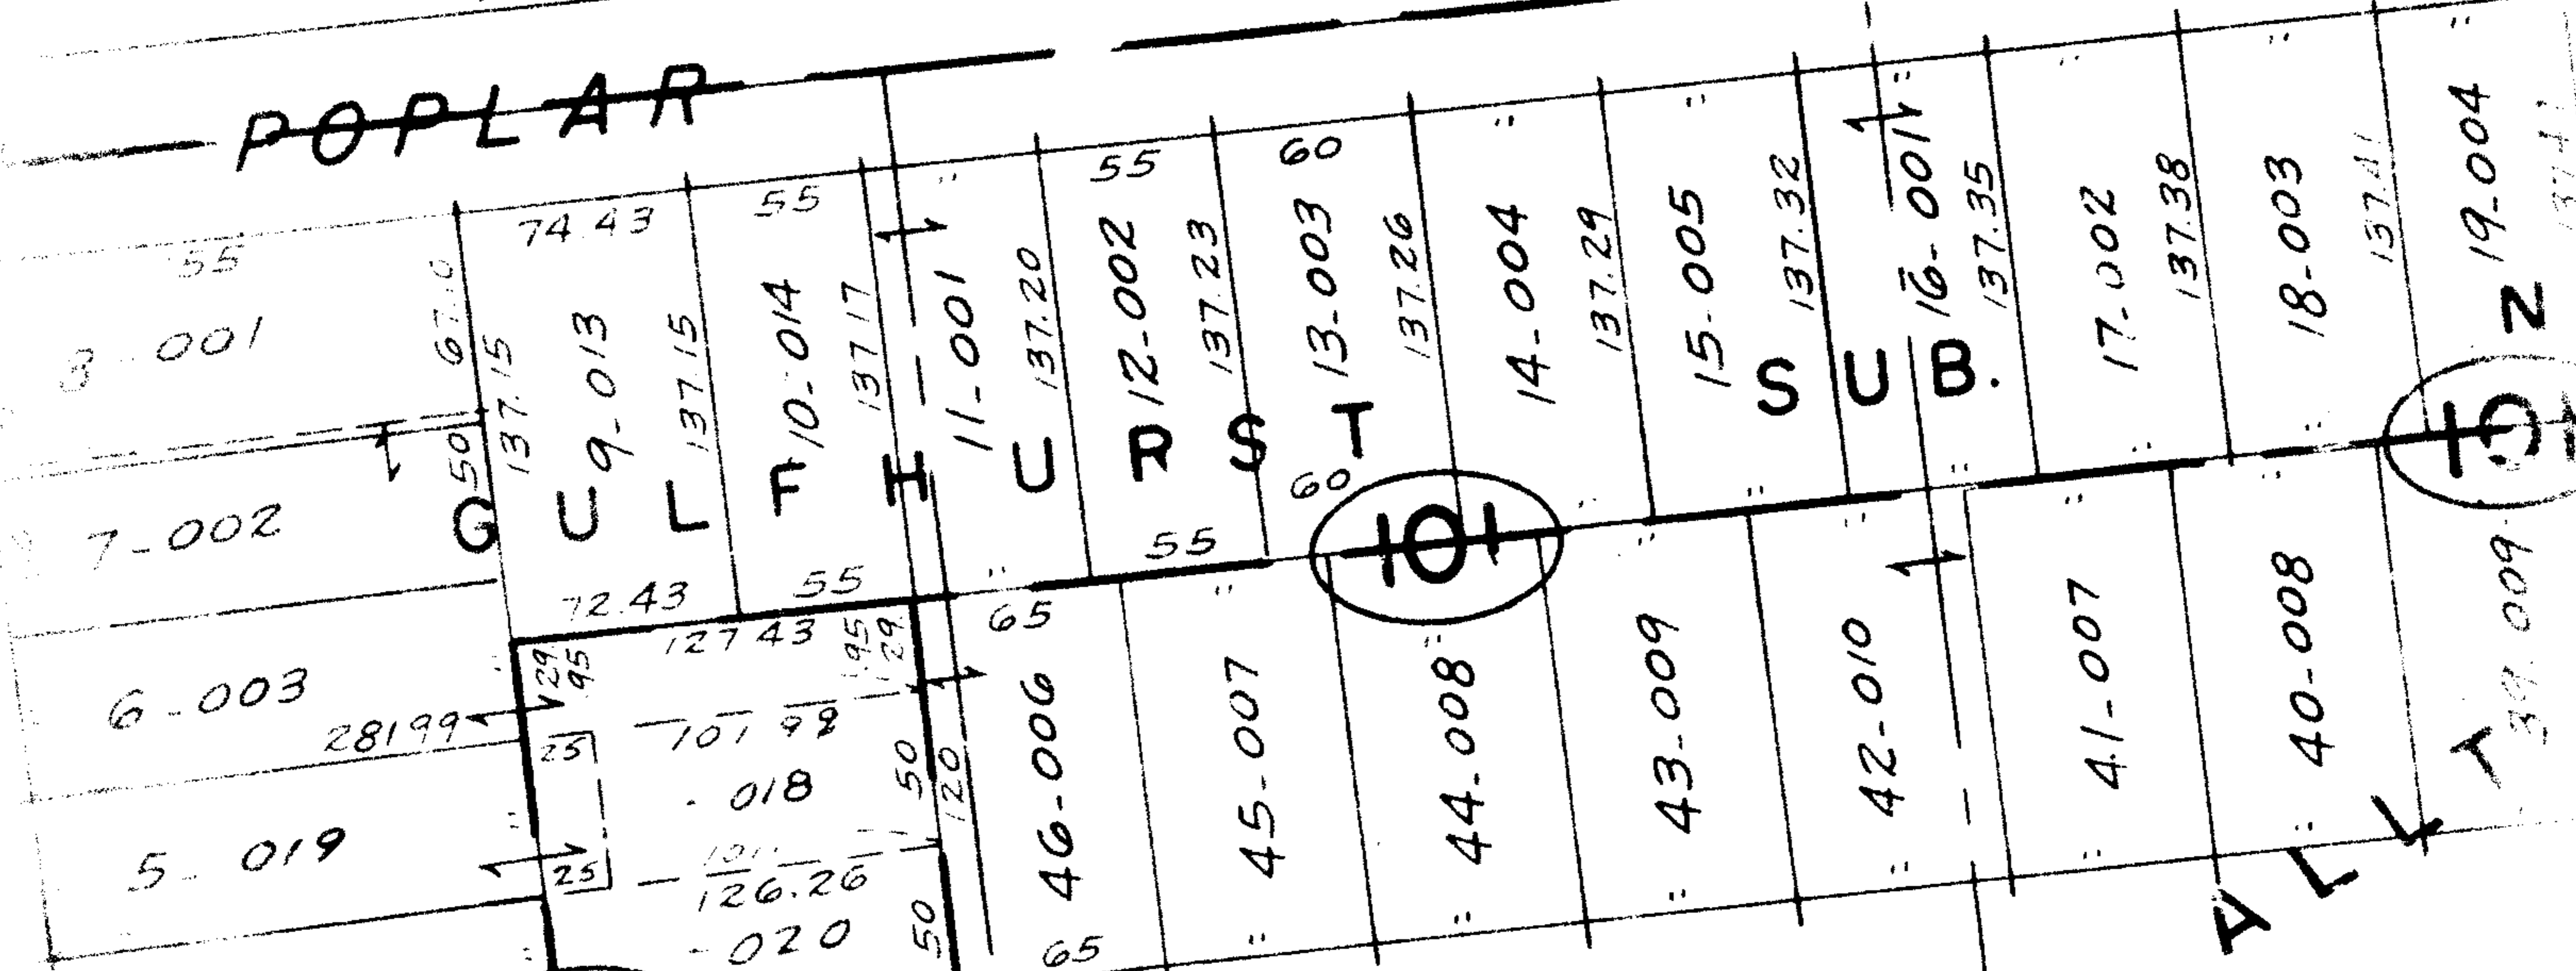

GELMA

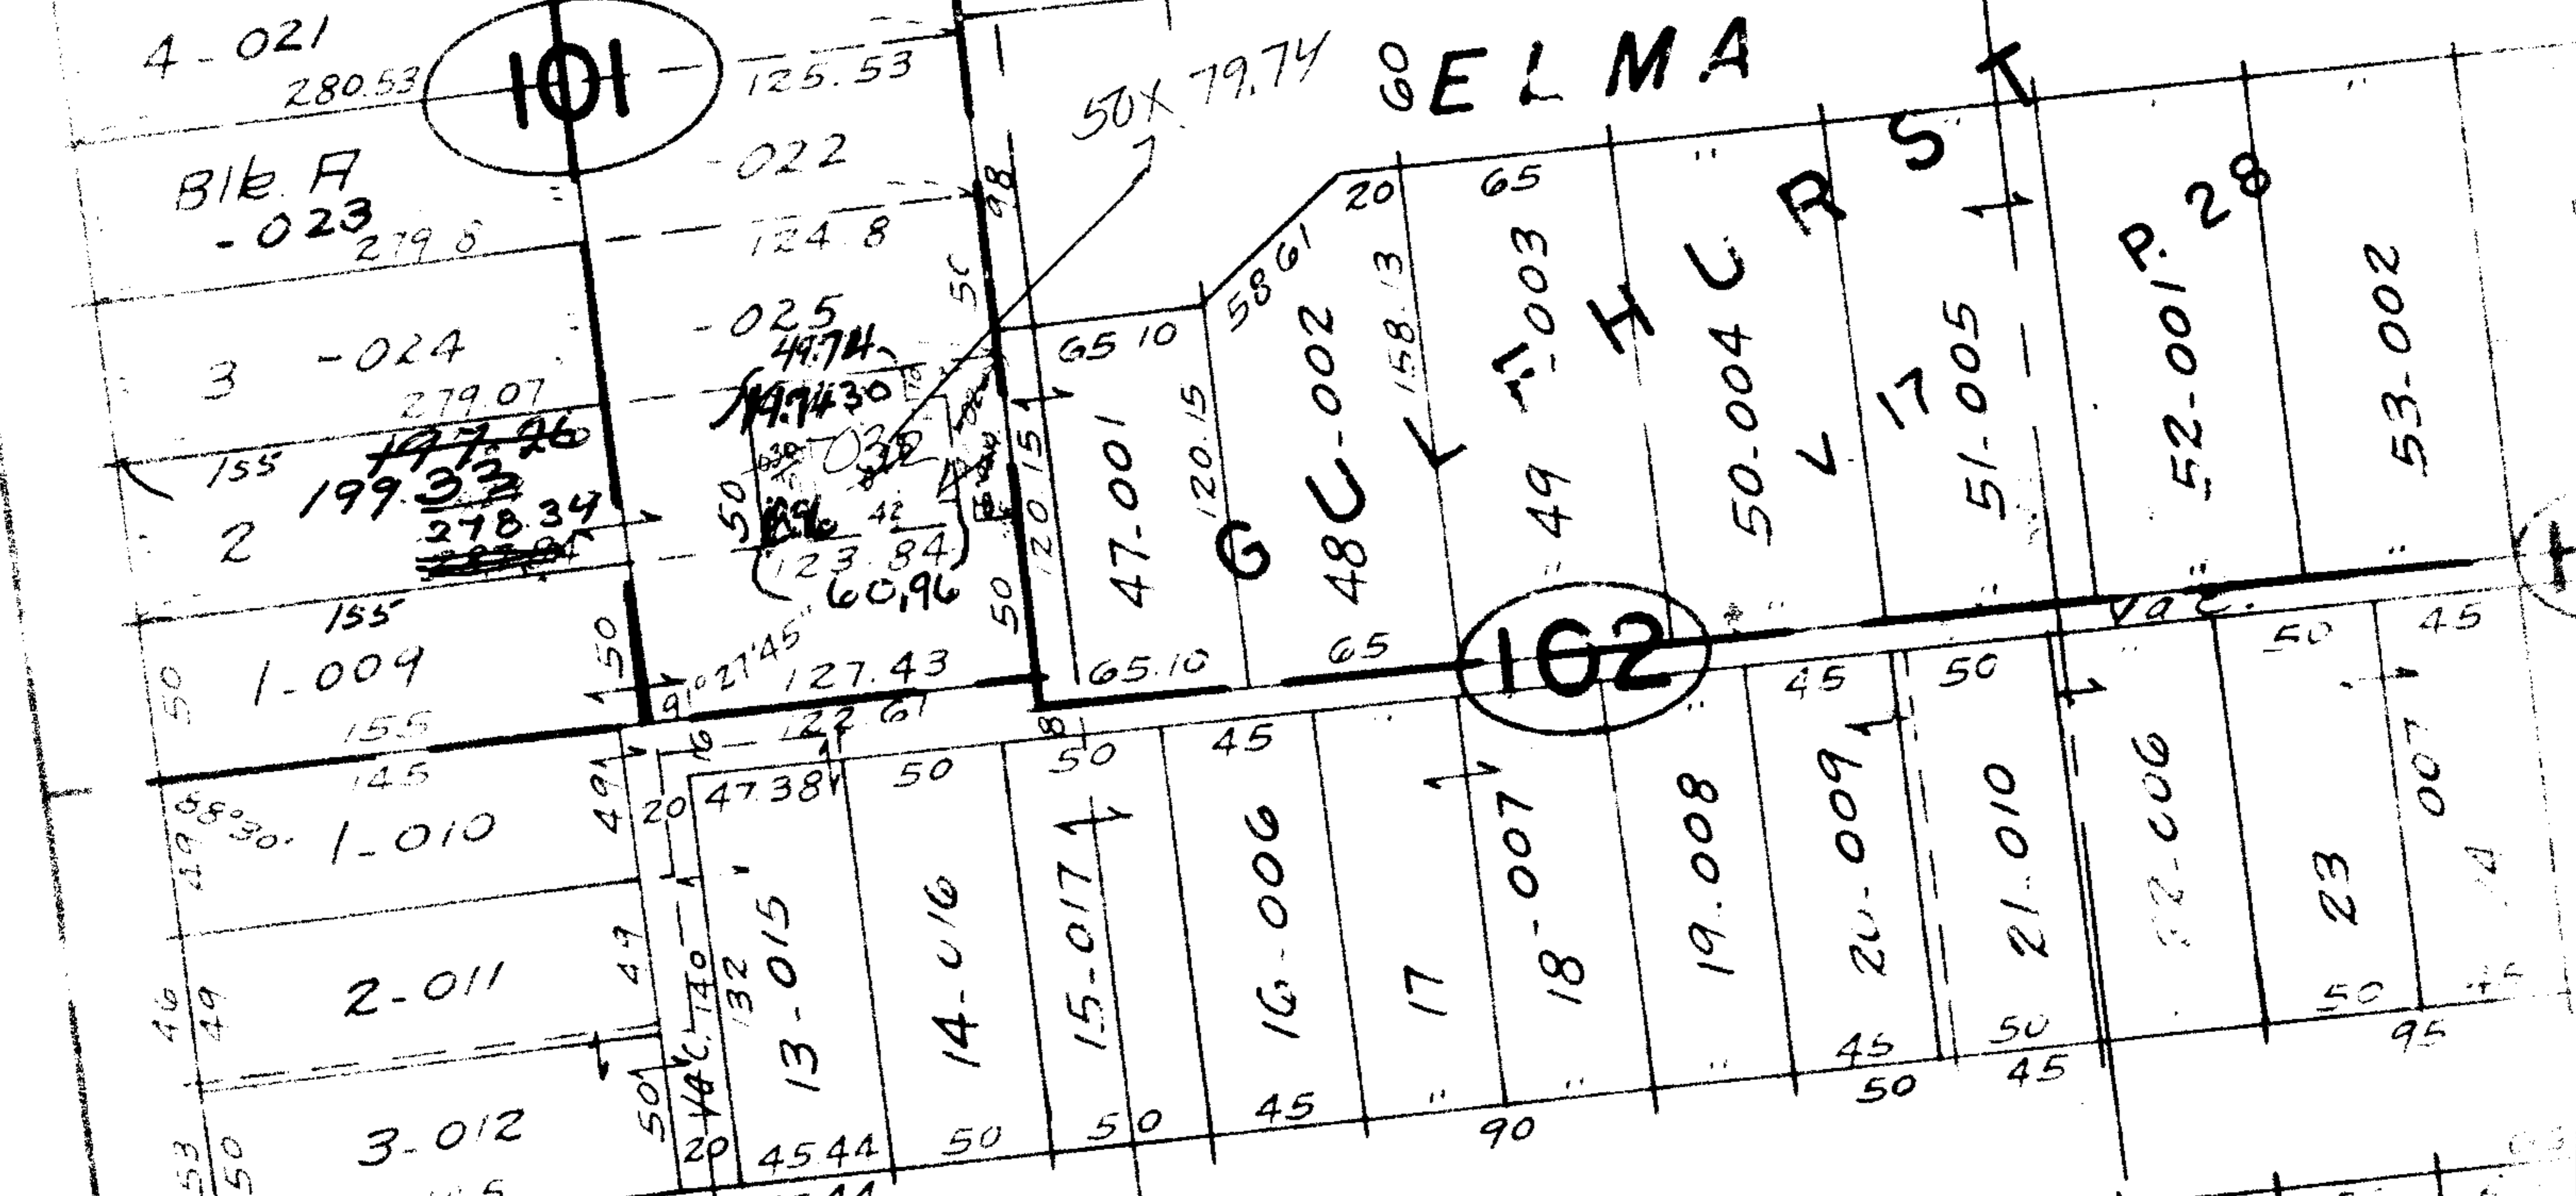

DILWORTH

