


RD 6418

18

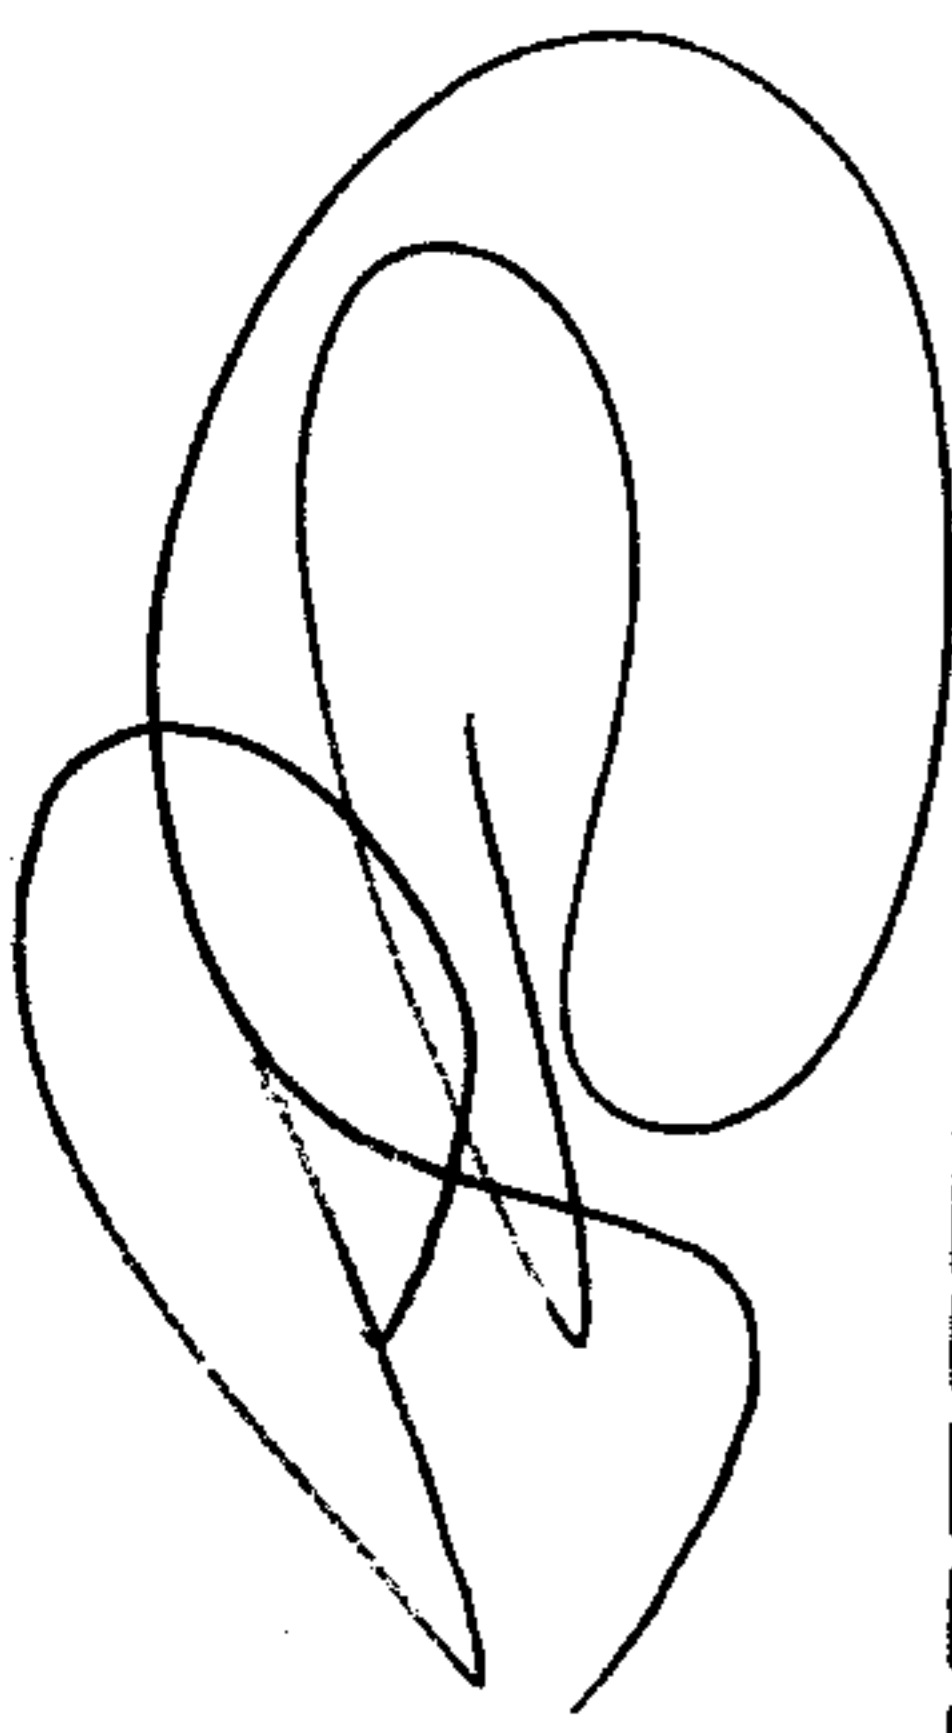

67.00

2

3931.62
-008
18.13A.

-009 - 3931.62 8.81A.

-007
~~51.88A.~~
46.07A.
3931.62

-002
32.00A




6418

APPROVED
LORAIN CO.
MAP DEPT.
DATE 10-16-72
19-E
BY <i>[Signature]</i>

332.37

464.31

1956.90

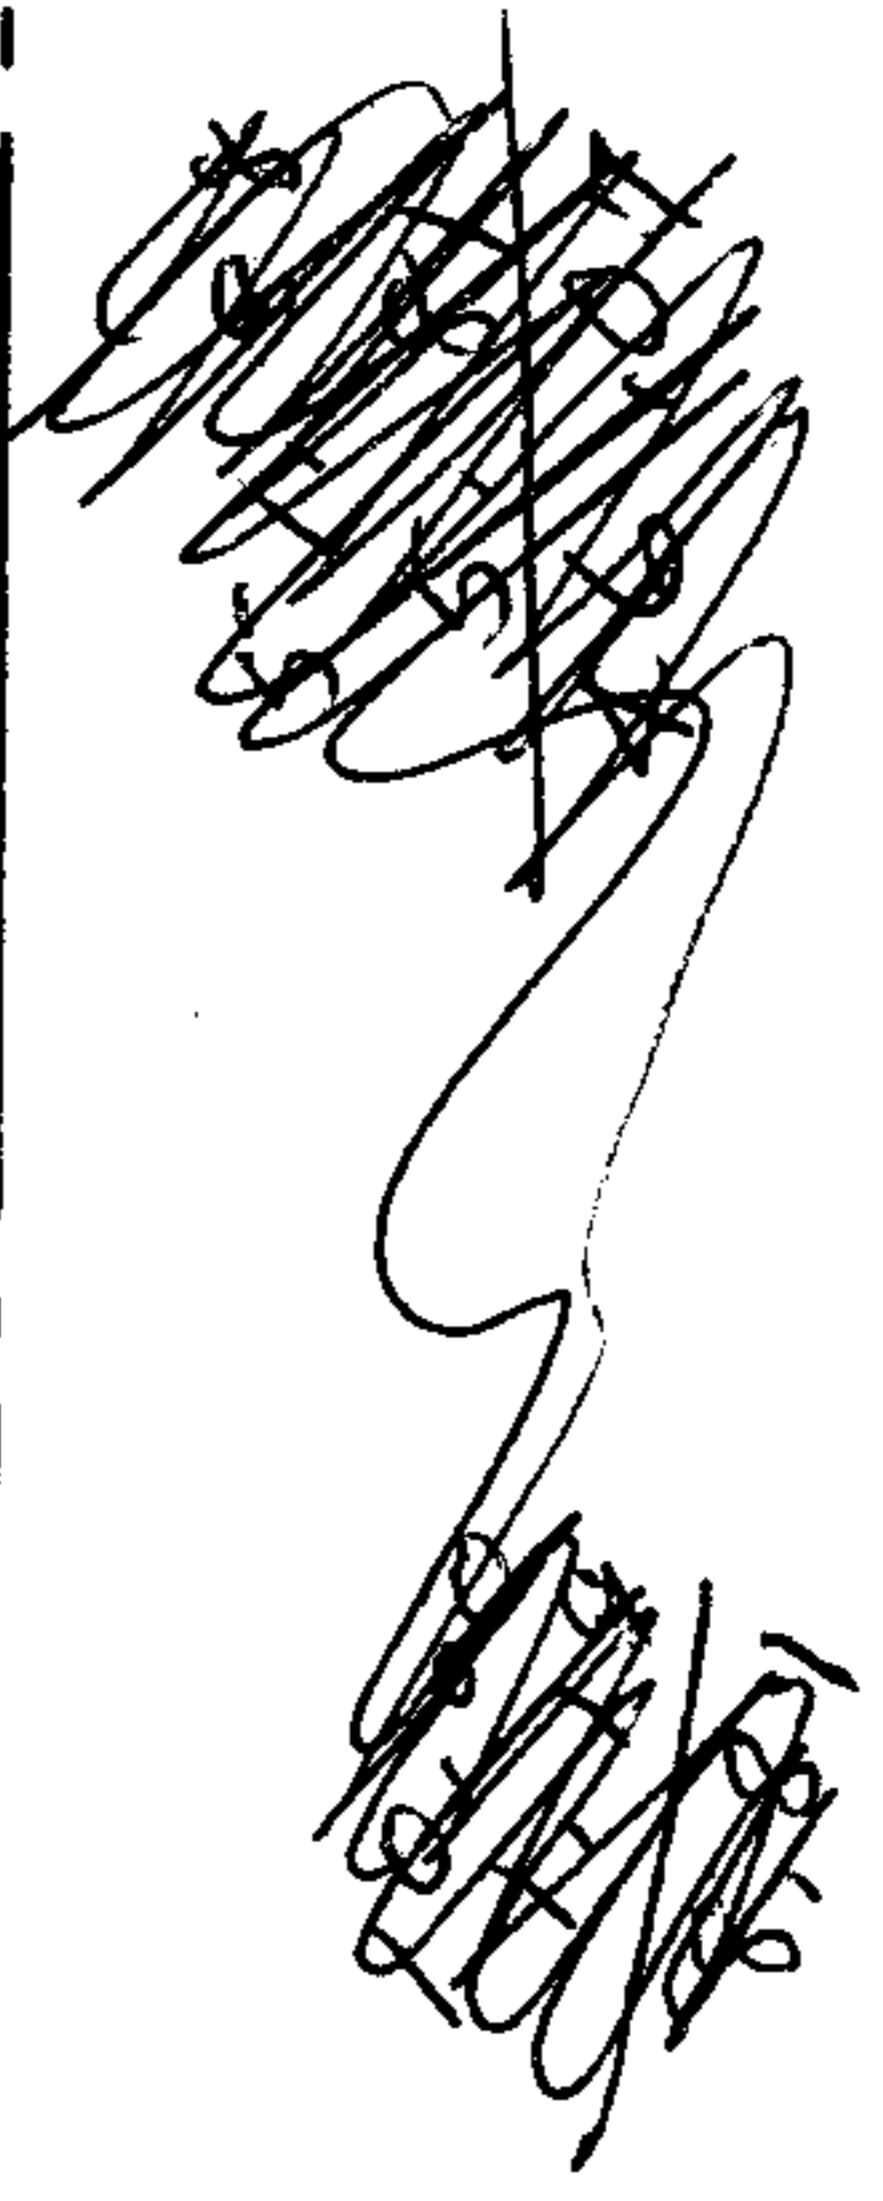

-002
43.00A.

661.65

8

-004
18.00A.

1968.78

-001
20.00A.

1934.42

810.84
-003
5.00A.
810.84

268.60
268.0

3

-006
7.00A. 8.81A.
896.82

896.82

653.40
-002
3.00A.
653.40

200 332.57

200 253.70
-007
72.95
243.95

149.55

(60)