


6424

~~038~~  
45.21 Ac.

-070  
42.88

-029  
1.47 A.

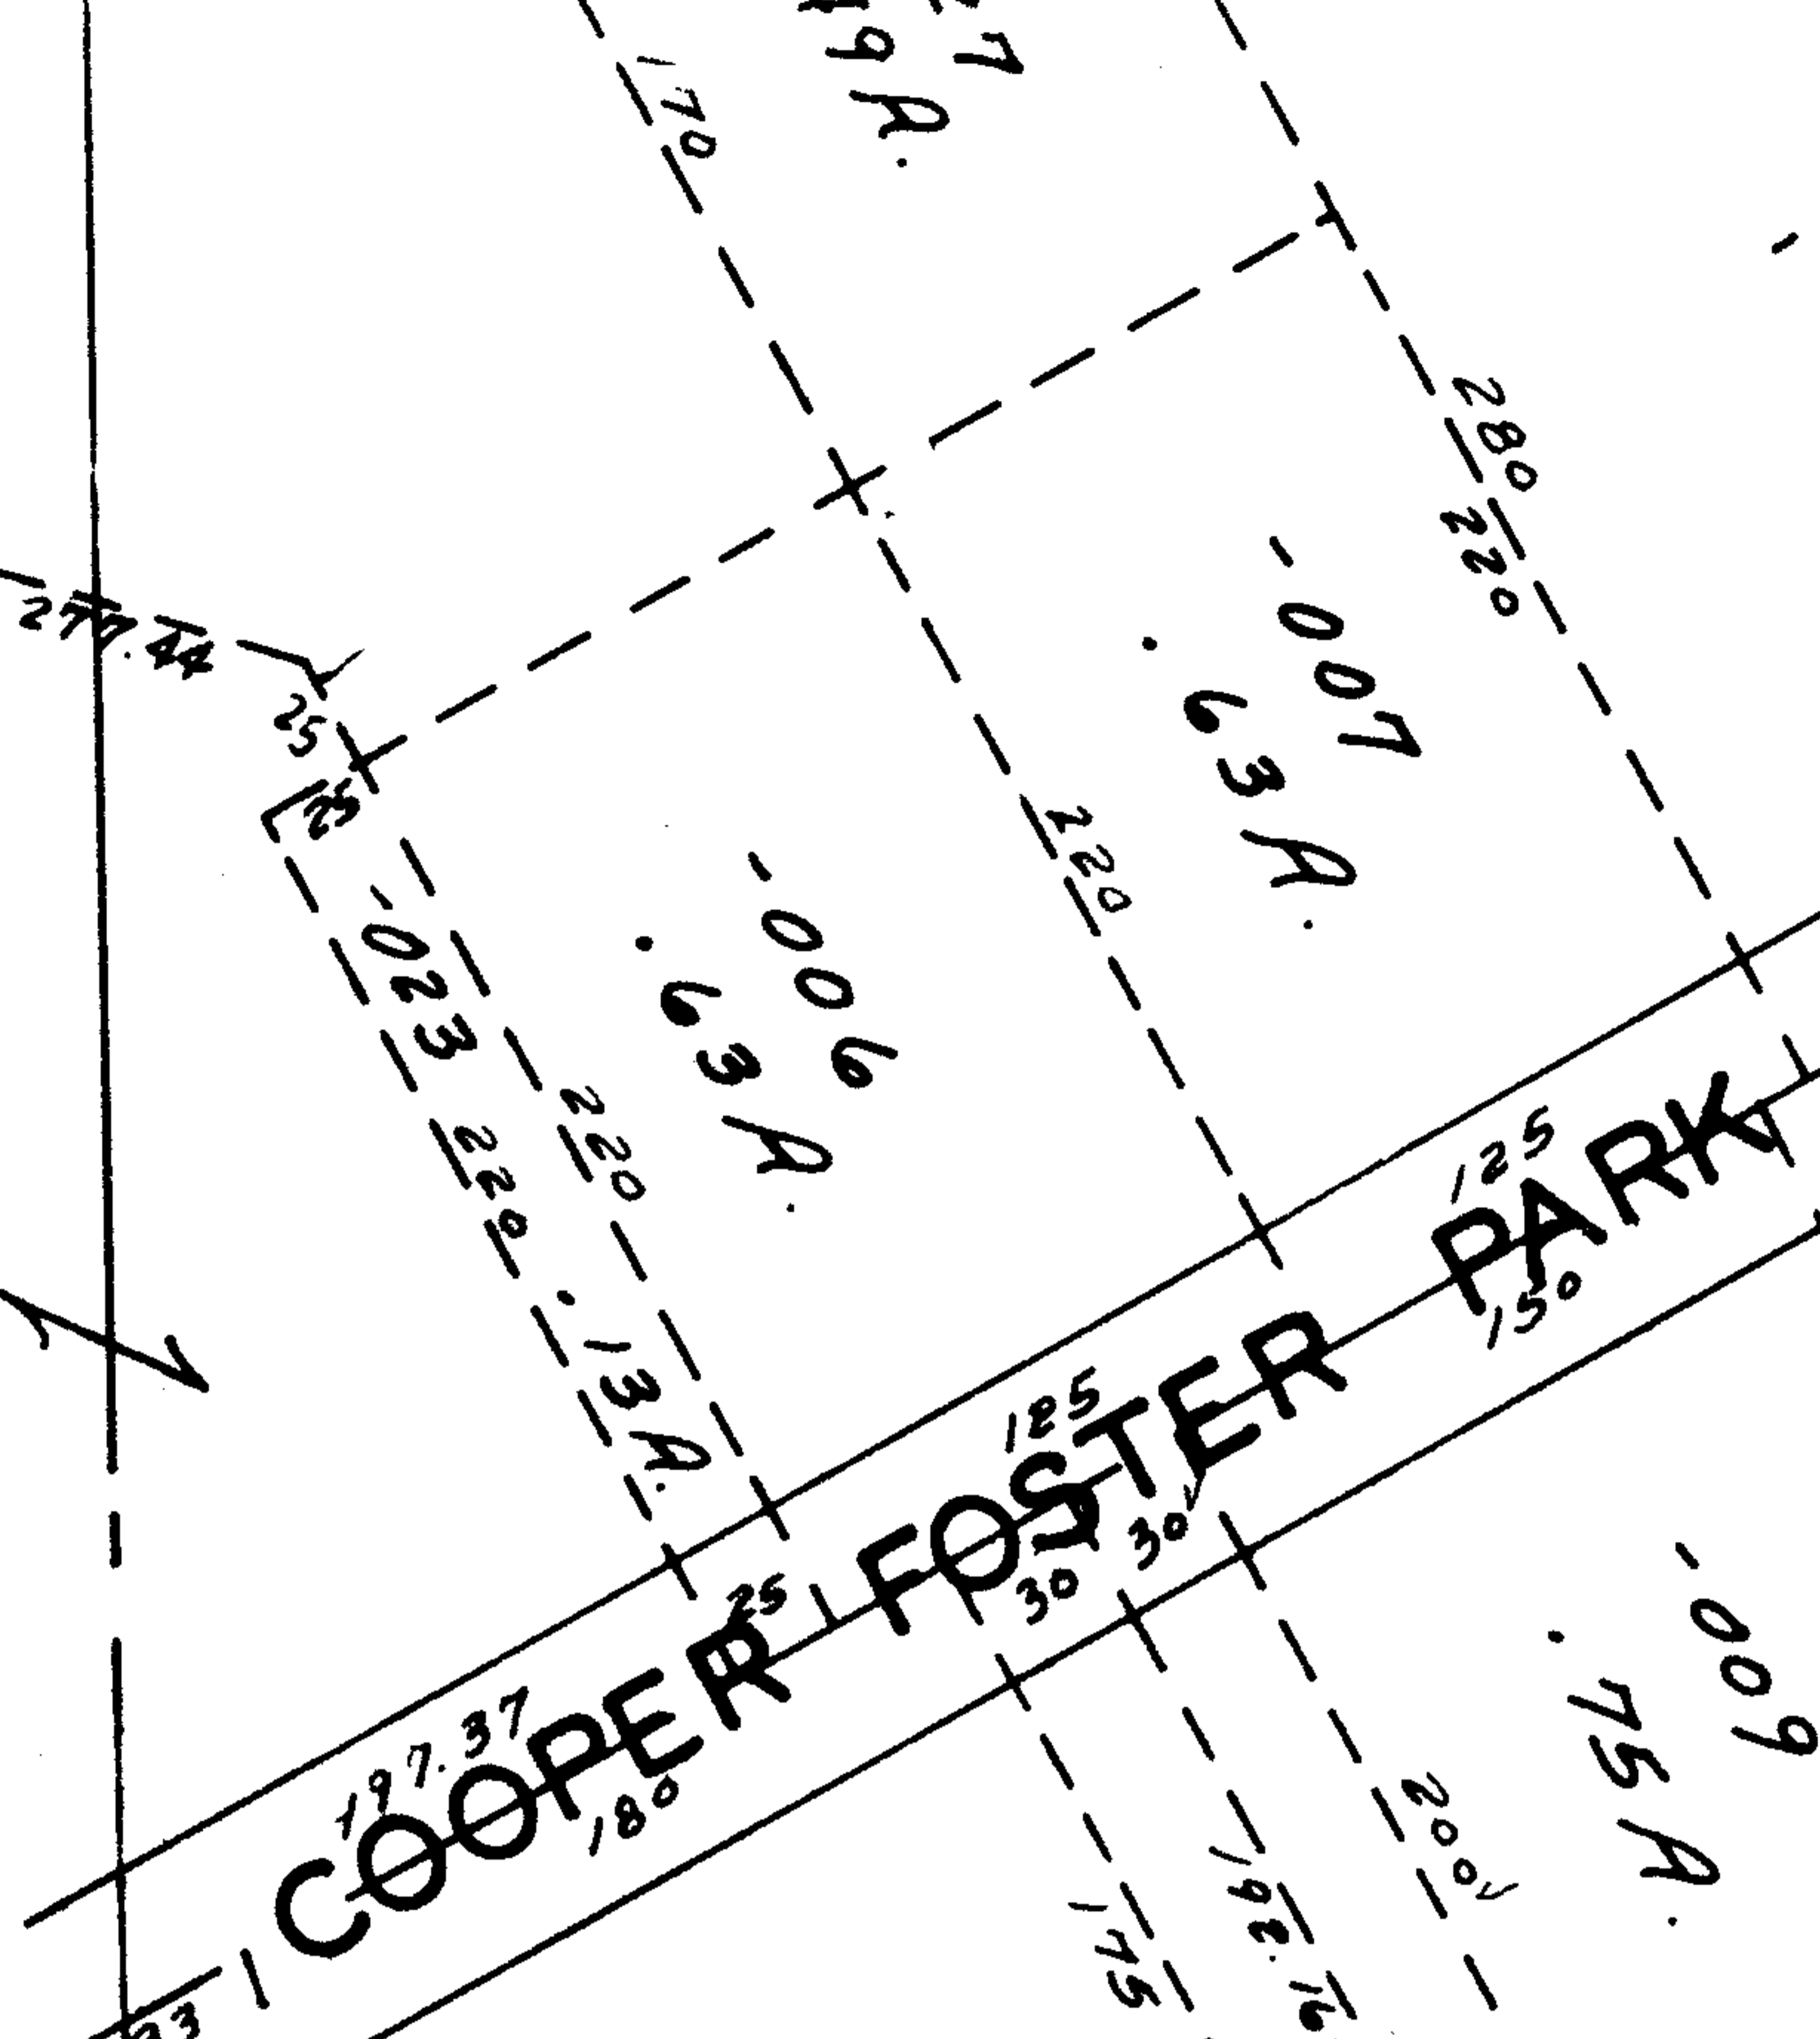

# COOPER FOSTER PARK

6424

APPROVED  
LORAIN CO.  
MAP DEPT.  
DATE 10-17-72  
1-00-027-A  
BY *[Signature]*

45.21  
2.33  
42.88

SEE 1-00-038-A

6424