


6443



RD 301 (LAGRANGE RD.)

RD 301

Indian Hollow Rd

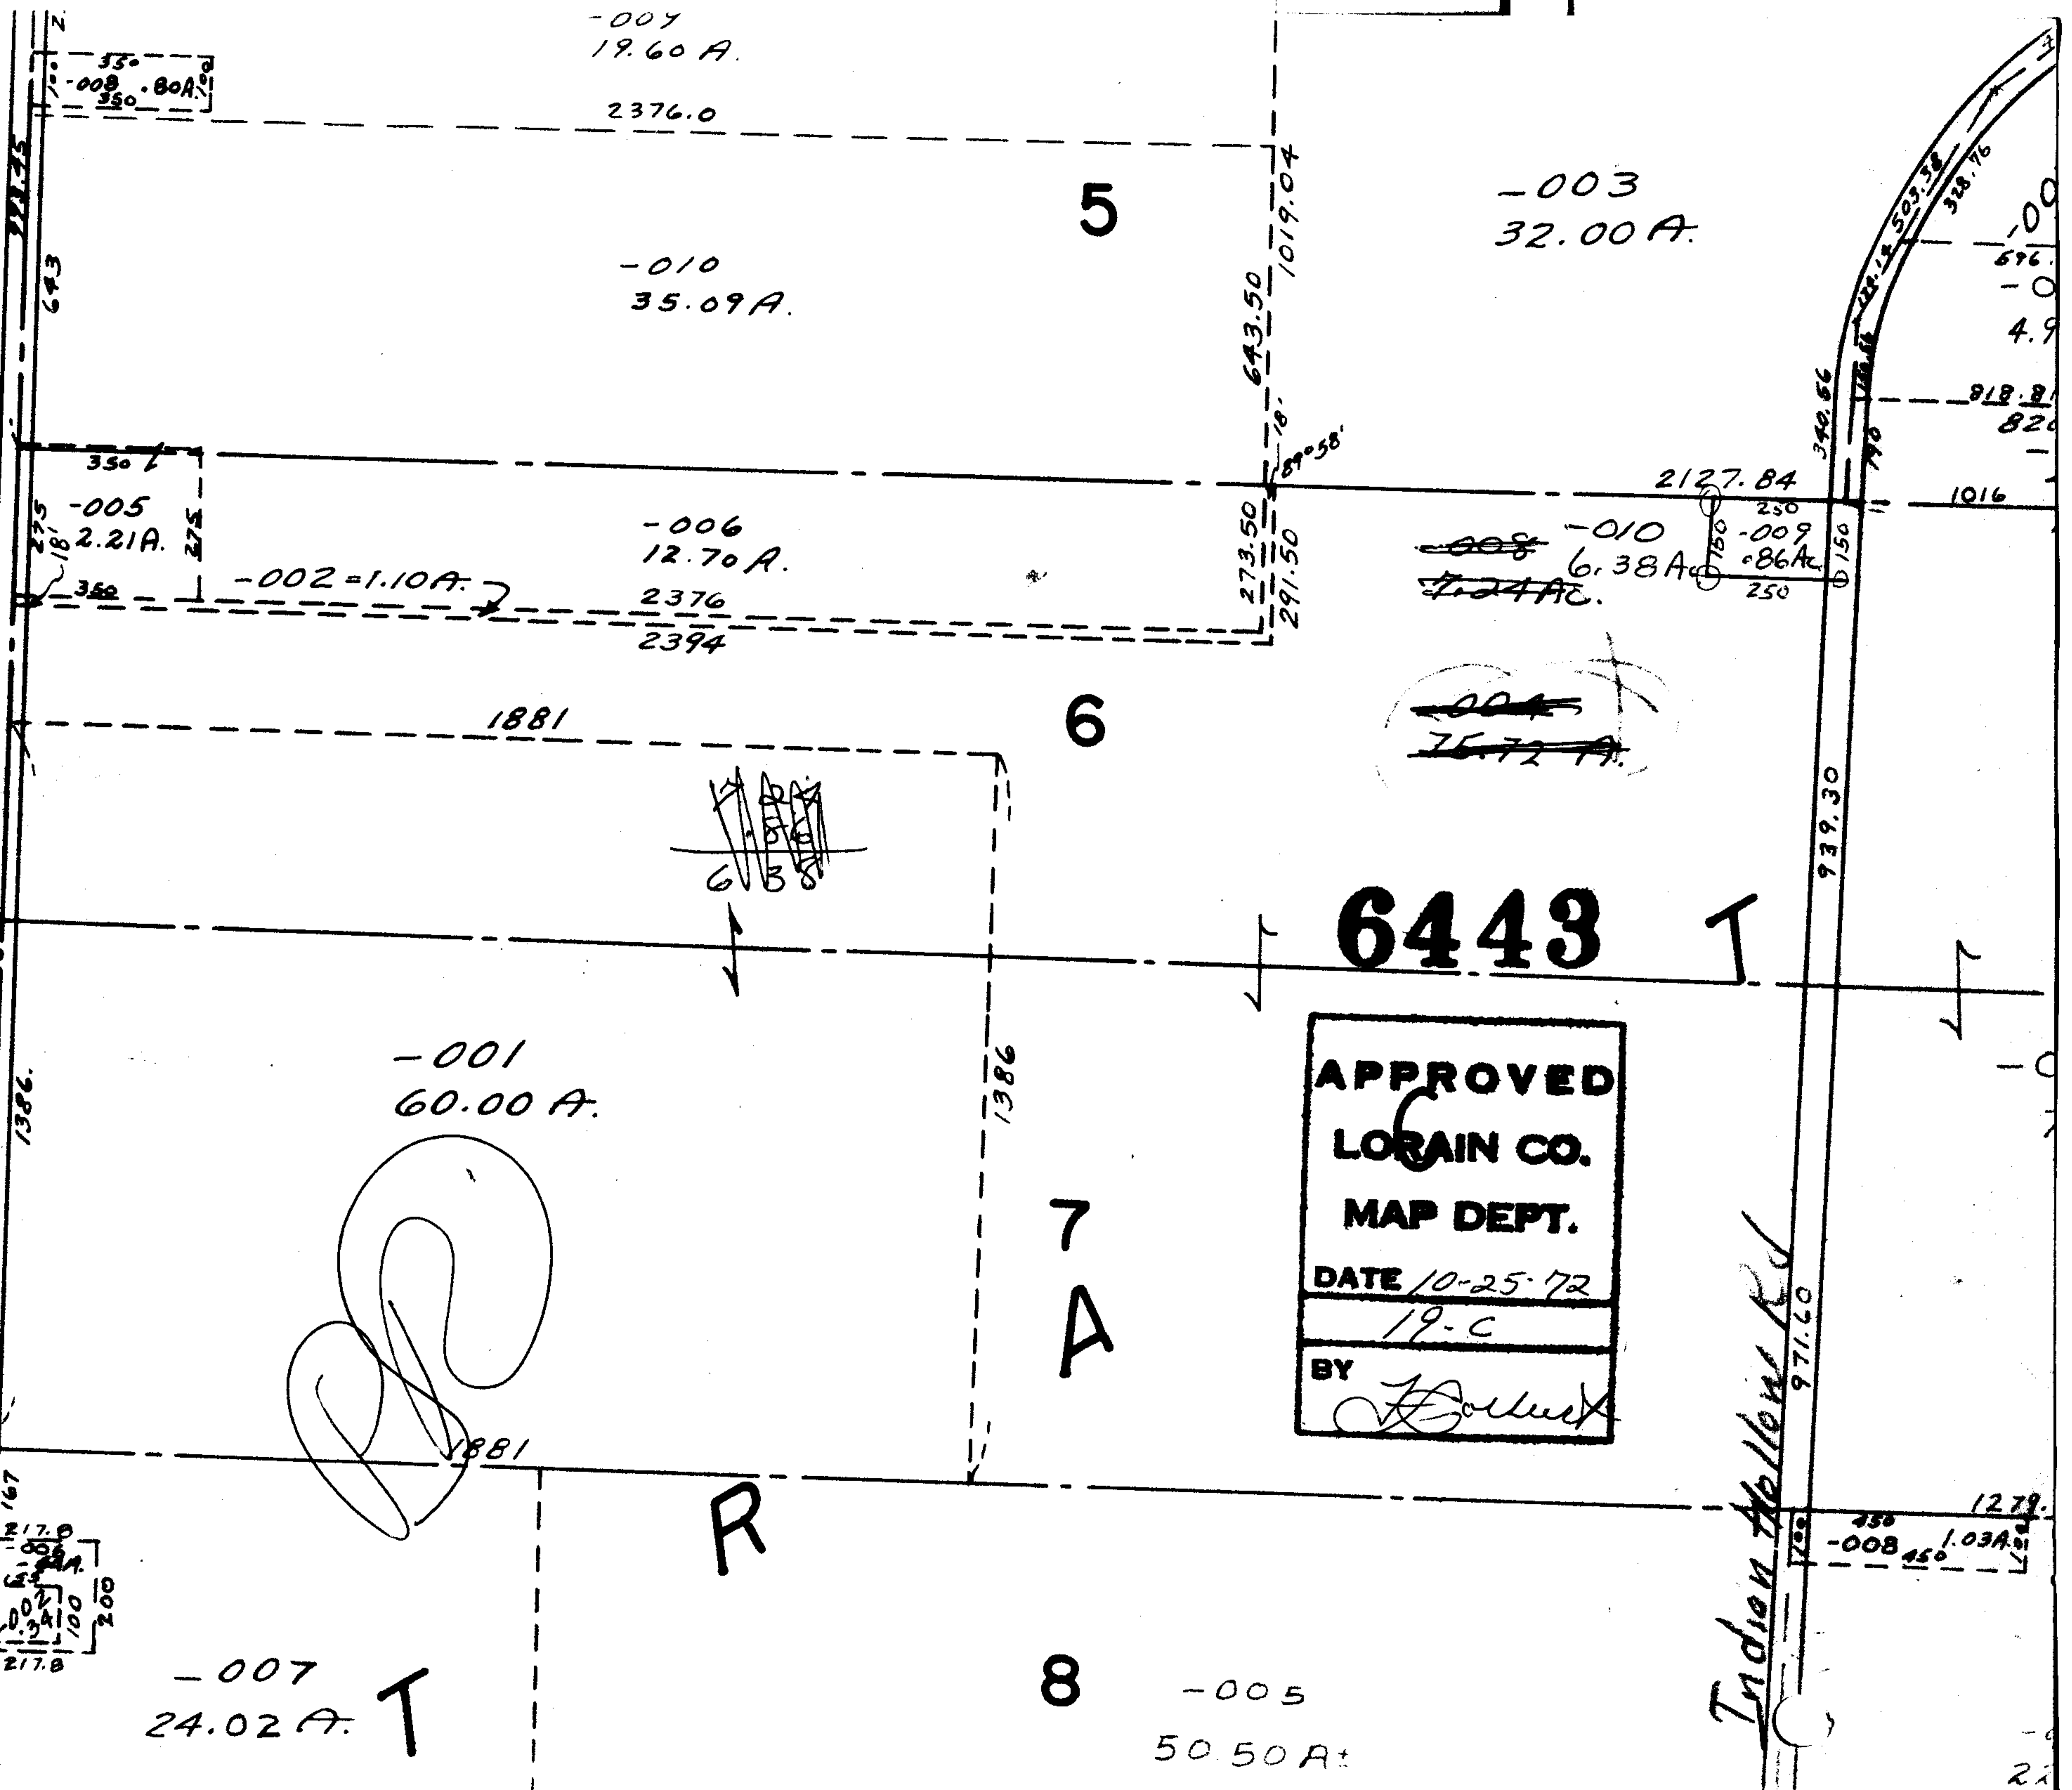

-004
19.60 A.

2376.0

5

-003
32.00 A.

-010
35.09 A.

643.50
1019.04

350

-005
2.21 A.

-006
12.70 A.

2127.84

-002 = 1.10 A.


2376
2394

~~008~~ -010
6.38 A.
-009
0.86 A.

1881

6

~~004~~
75.72 A.

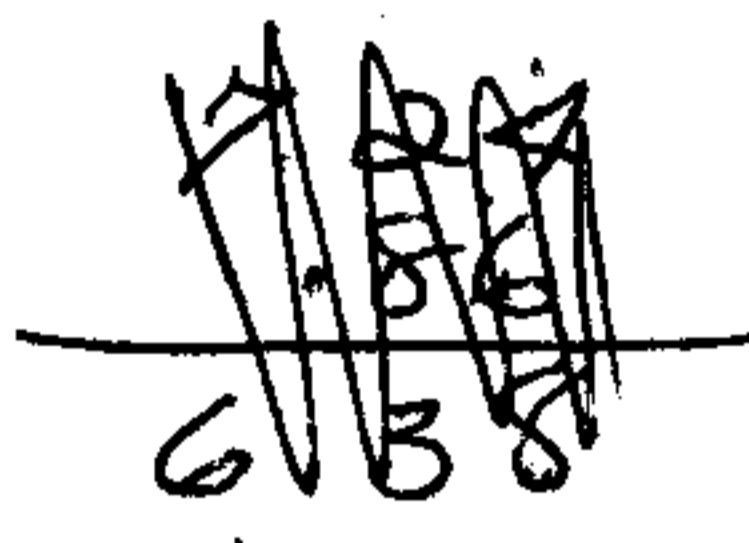


6443 T

-001
60.00 A.

1386

APPROVED
LORAIN CO.
MAP DEPT.
DATE 10-25-72
19-C
BY *H. D. ...*


7
A

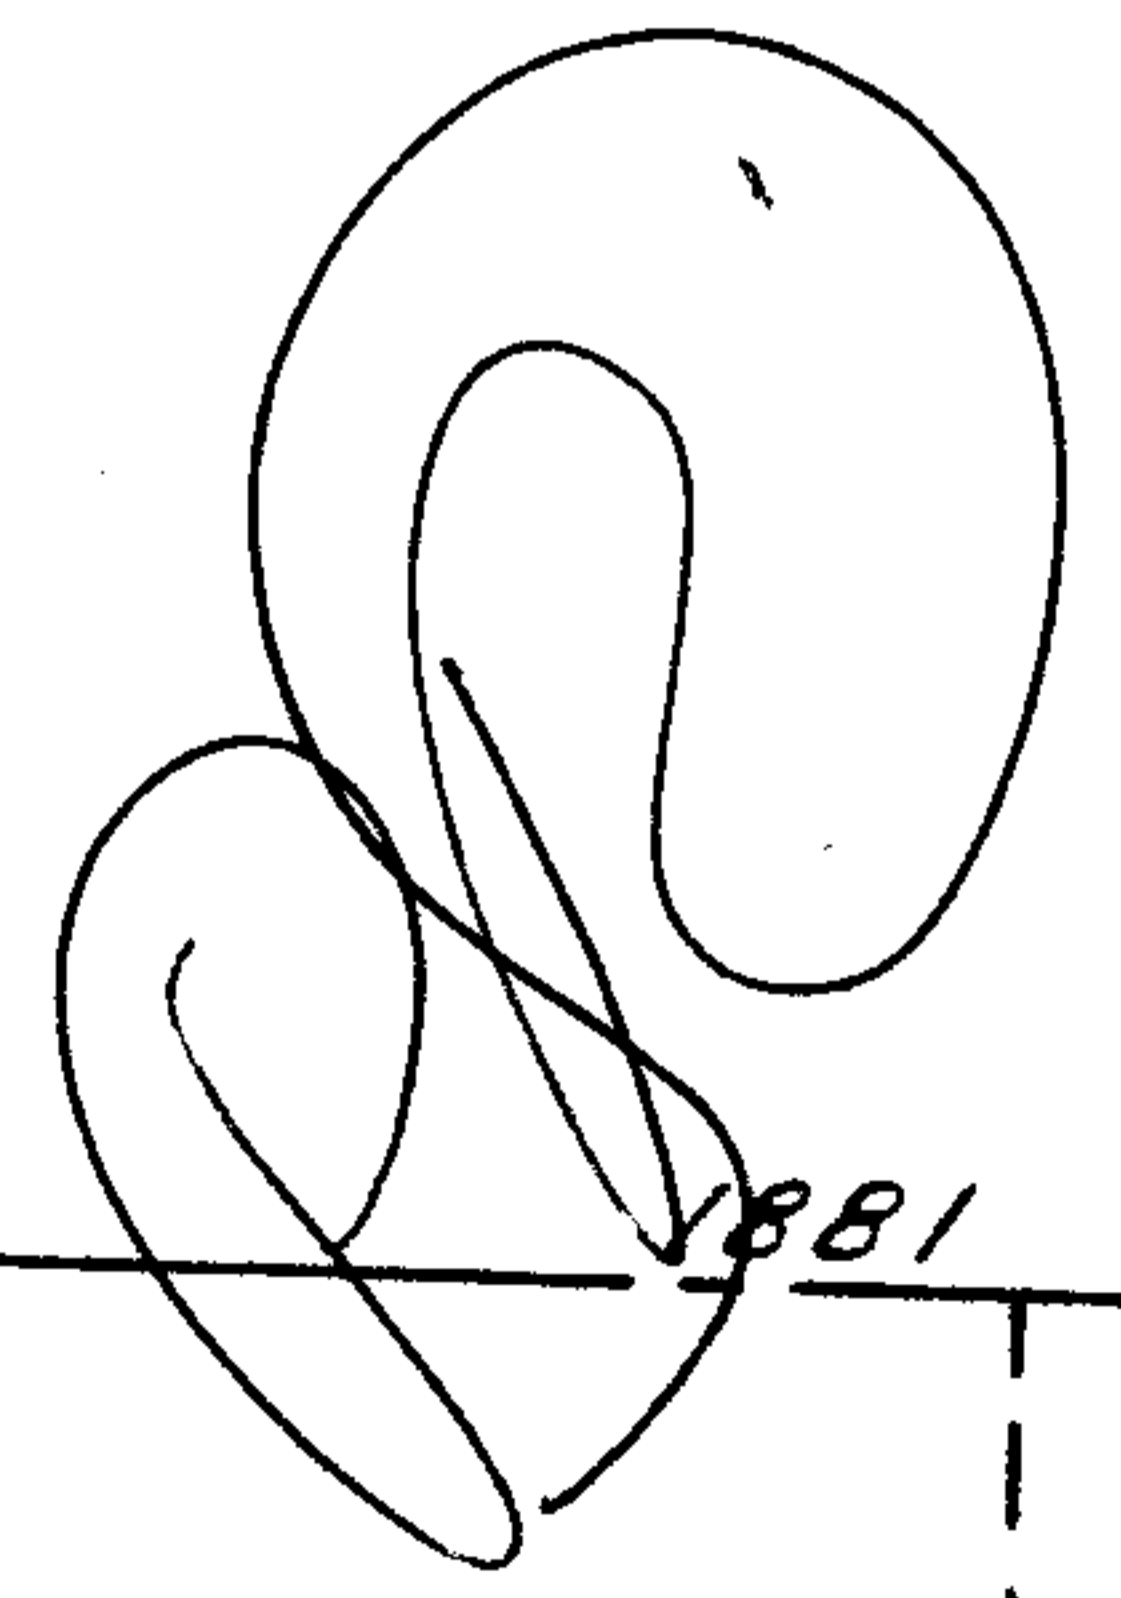

1386

1881

R

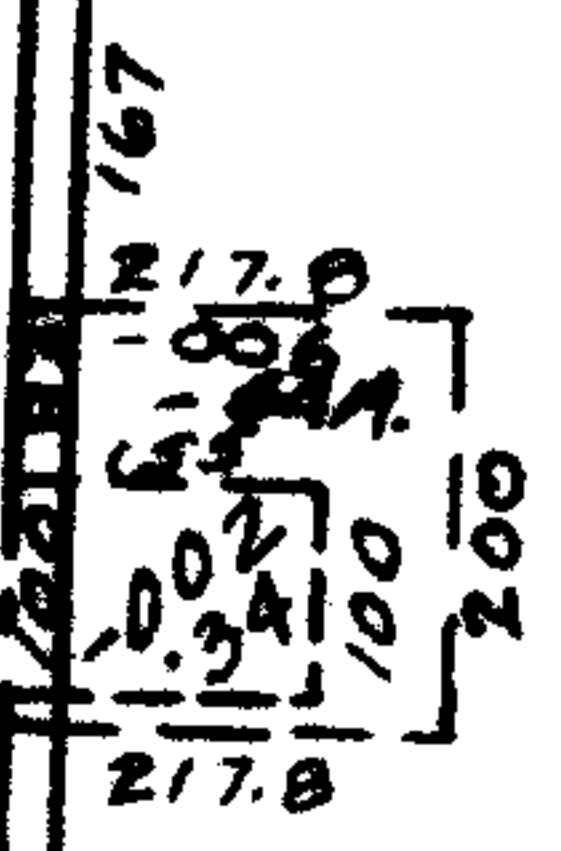

-007
24.02 A. T

8

-005
50.50 A.

971.60

939.30

340.66

221.4
503.38
328.76

790

150

150

1279.
-008
1.03 A.