

73

6449

-011
2.48A.



-013
5.00A.


1083
210.03

-043
0.77Ac.

210.03

1118.02

-016
5.69A.

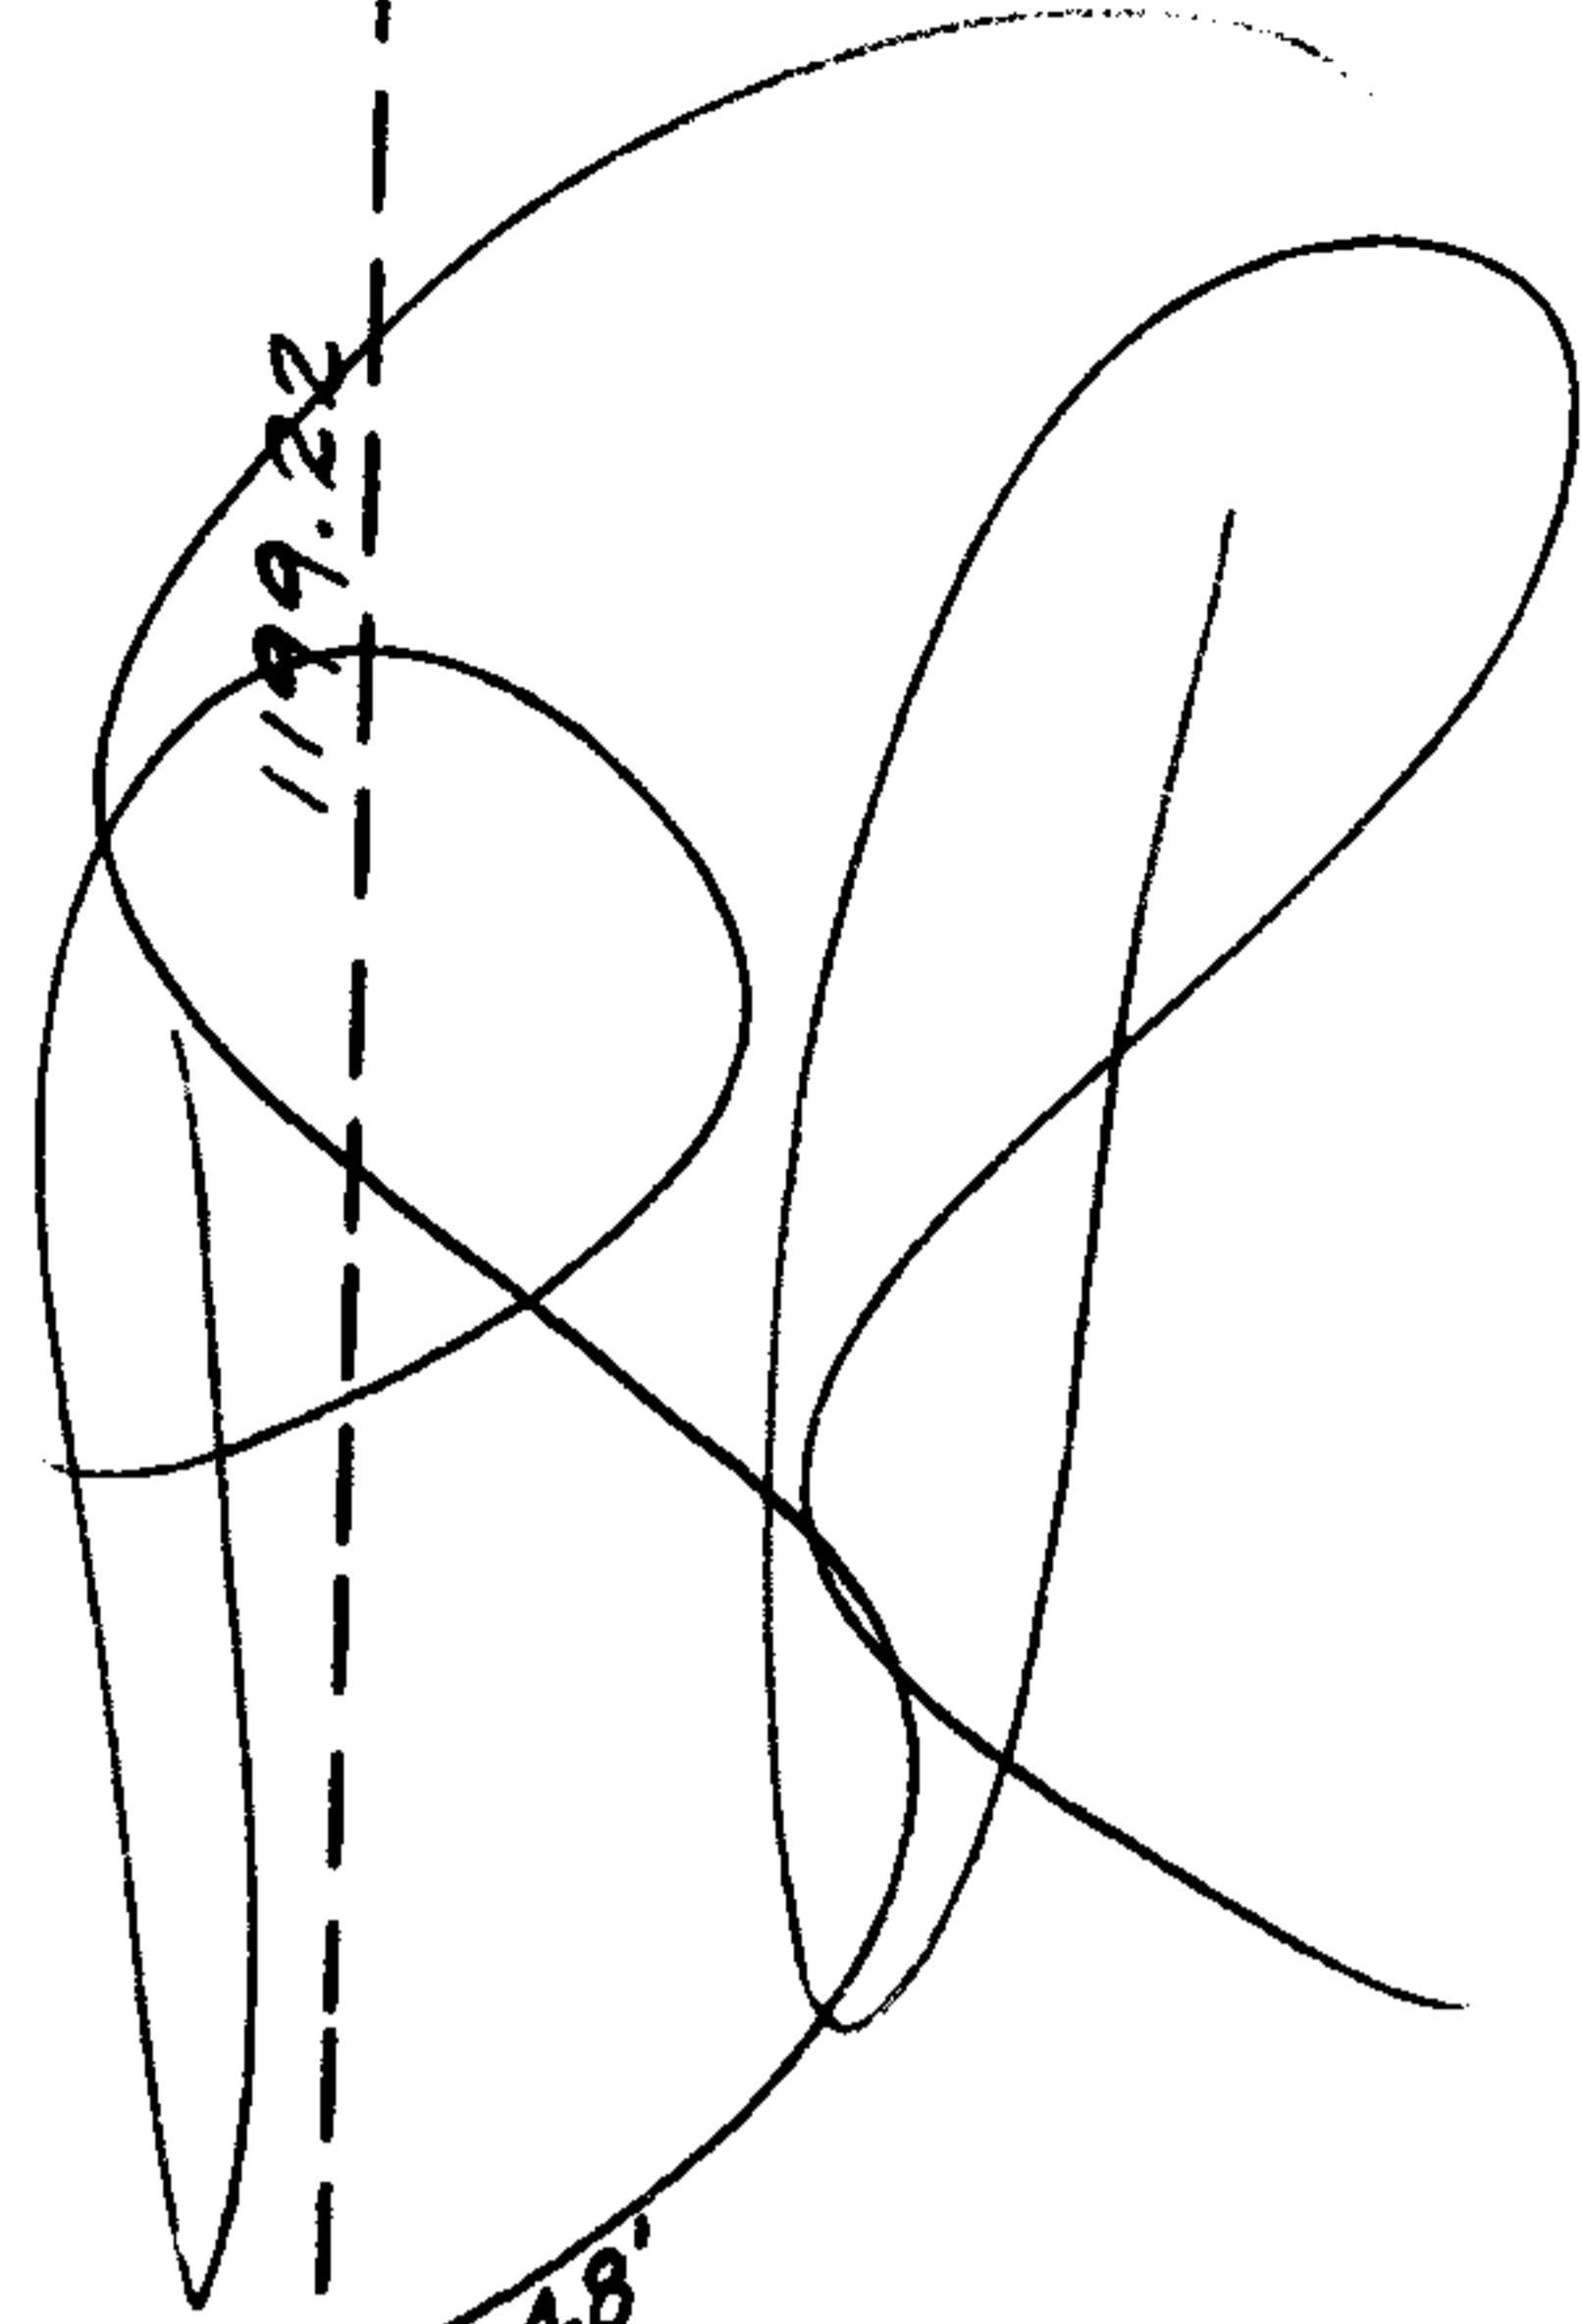

6449

APPROVED
LORAIN CO.
MAP DEPT.
DATE 10-25-72
3-00-073-B
BY *Delbert*

102.03

-012
81A.

349.61

1049.71

52.78

159.68

~~181A~~
~~4.54A.~~

-044
0.77Ac.

528.95

312.92

APPROVED
LORAIN CO.
MAP DEPT.
DATE 10-25-72
3-00-073-B
BY *Delbert*

63.39

282

-018
50A.

246.30

76°06'

Rd

175.20

-016
116.20

357.57

74°15'

N Ridge
248

164.31
81.4

88

82.601

78

88.66

194.75

186.84

-020
34

-028
37

-027
37A

-030
64A.

73.77

91.73

45.45