


6451



(LAGRANGE RD.) R# 301

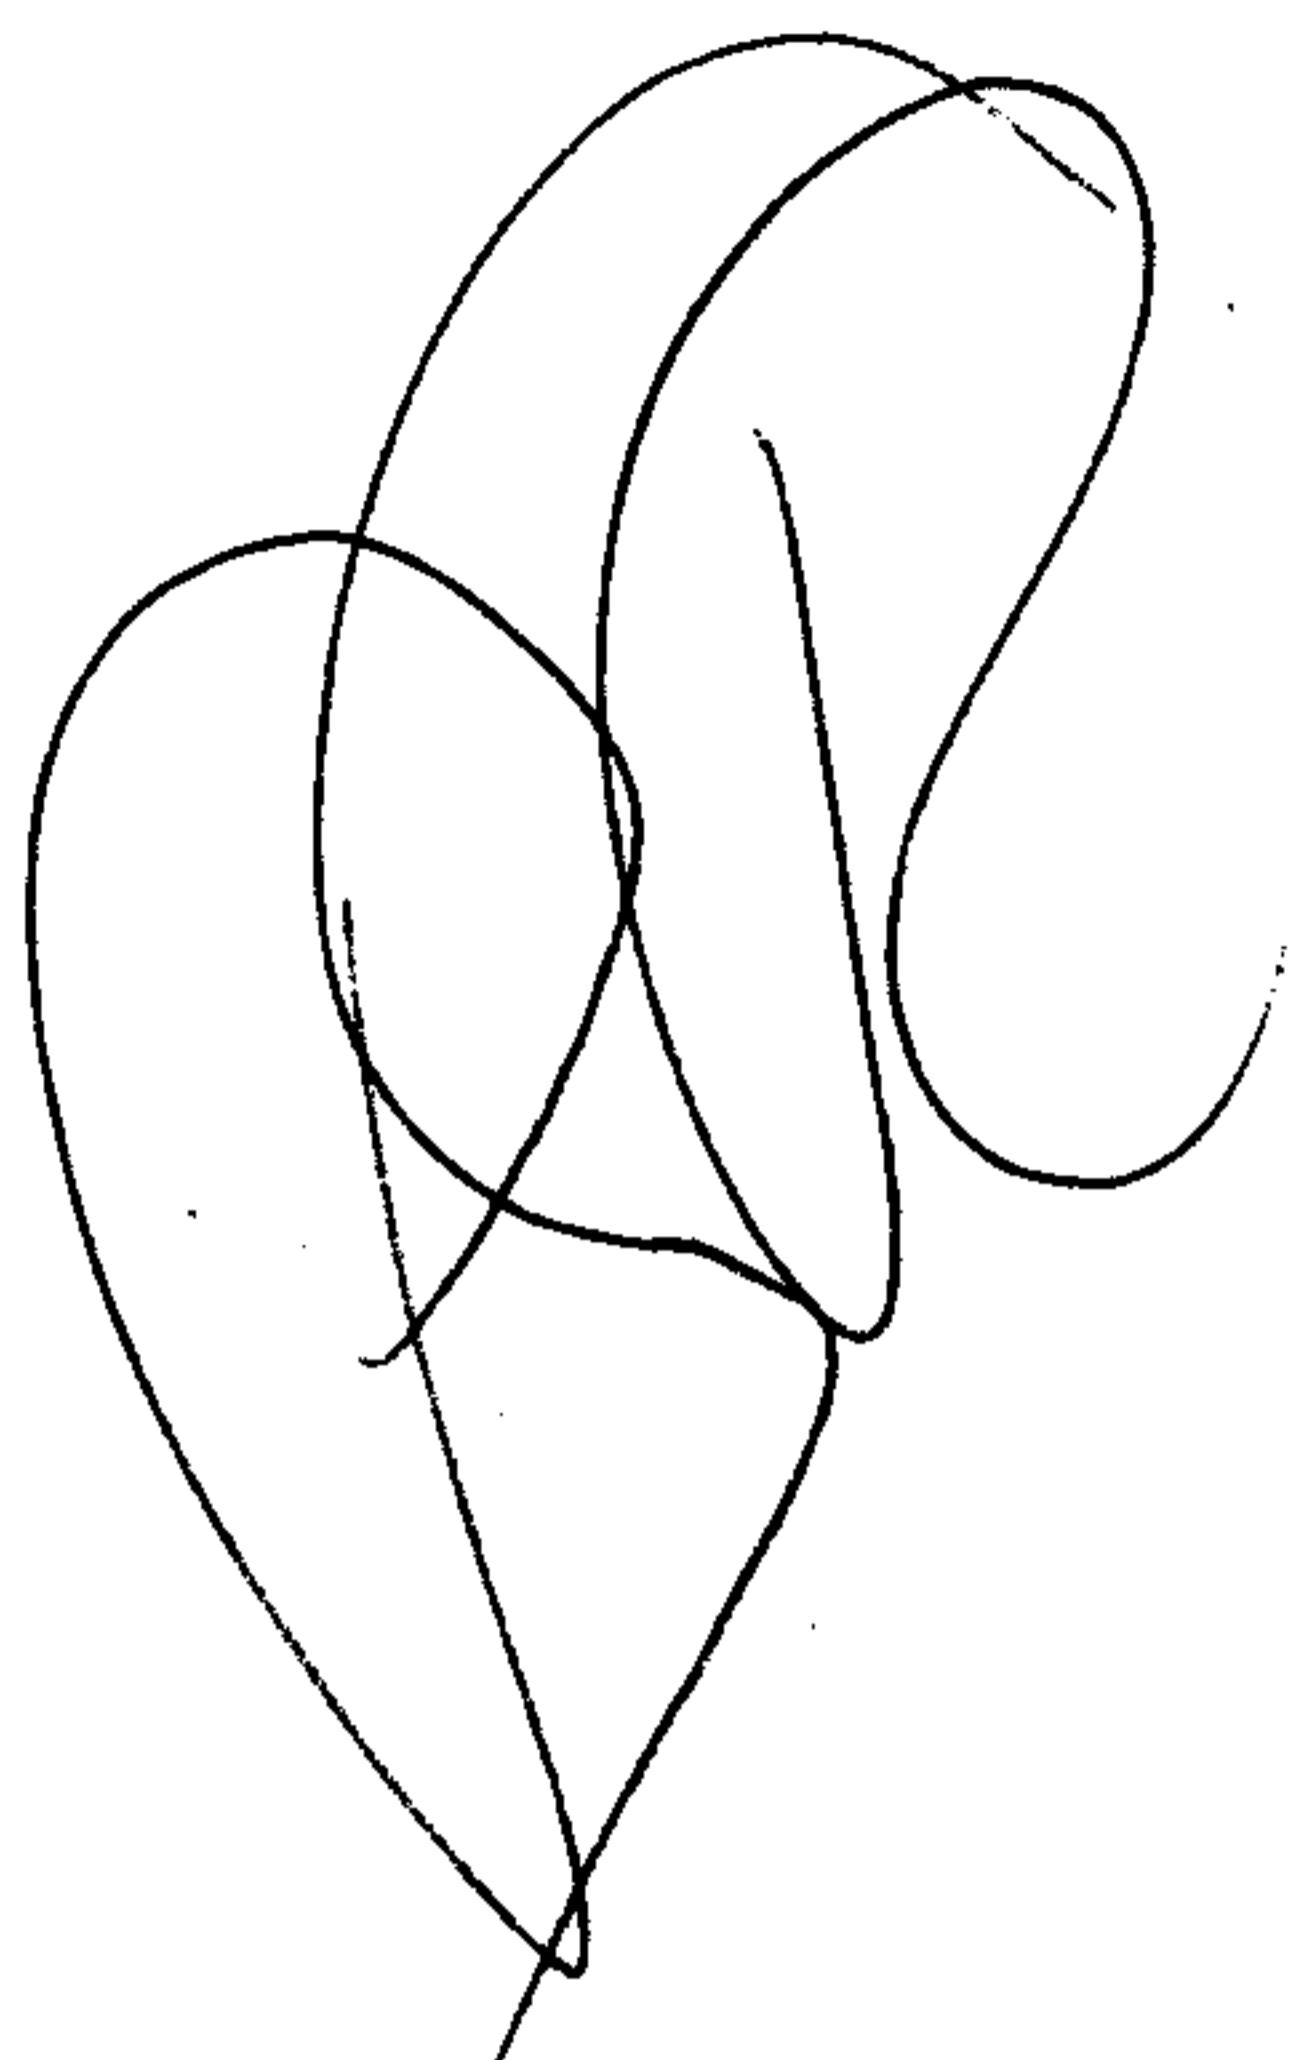

- 001  
80.00 A.

26 2626.8

6451

APPROVED  
LORAIN CO.  
MAP DEPT.

DATE 10-25-72

15-C

BY

*[Signature]*

- 004  
~~- 002~~  
~~80.00 A.~~  
71.56 Ac.

1322.64  
1030.79

1320.68  
- 003  
**BIGGS** 8.44 Ac.  
1318.35

1269.56  
48.79  
1318.35  
80.00  
8.44  
71.56

(60) 1269.56

- 001

2626.8

619.12

625.85

644.97

1275.7

1322.64

89°47'

89°57'

- 00  
50.54

90°00'

169

430

11.88

23.84

273.45

90°32'

A.