


6459



RD

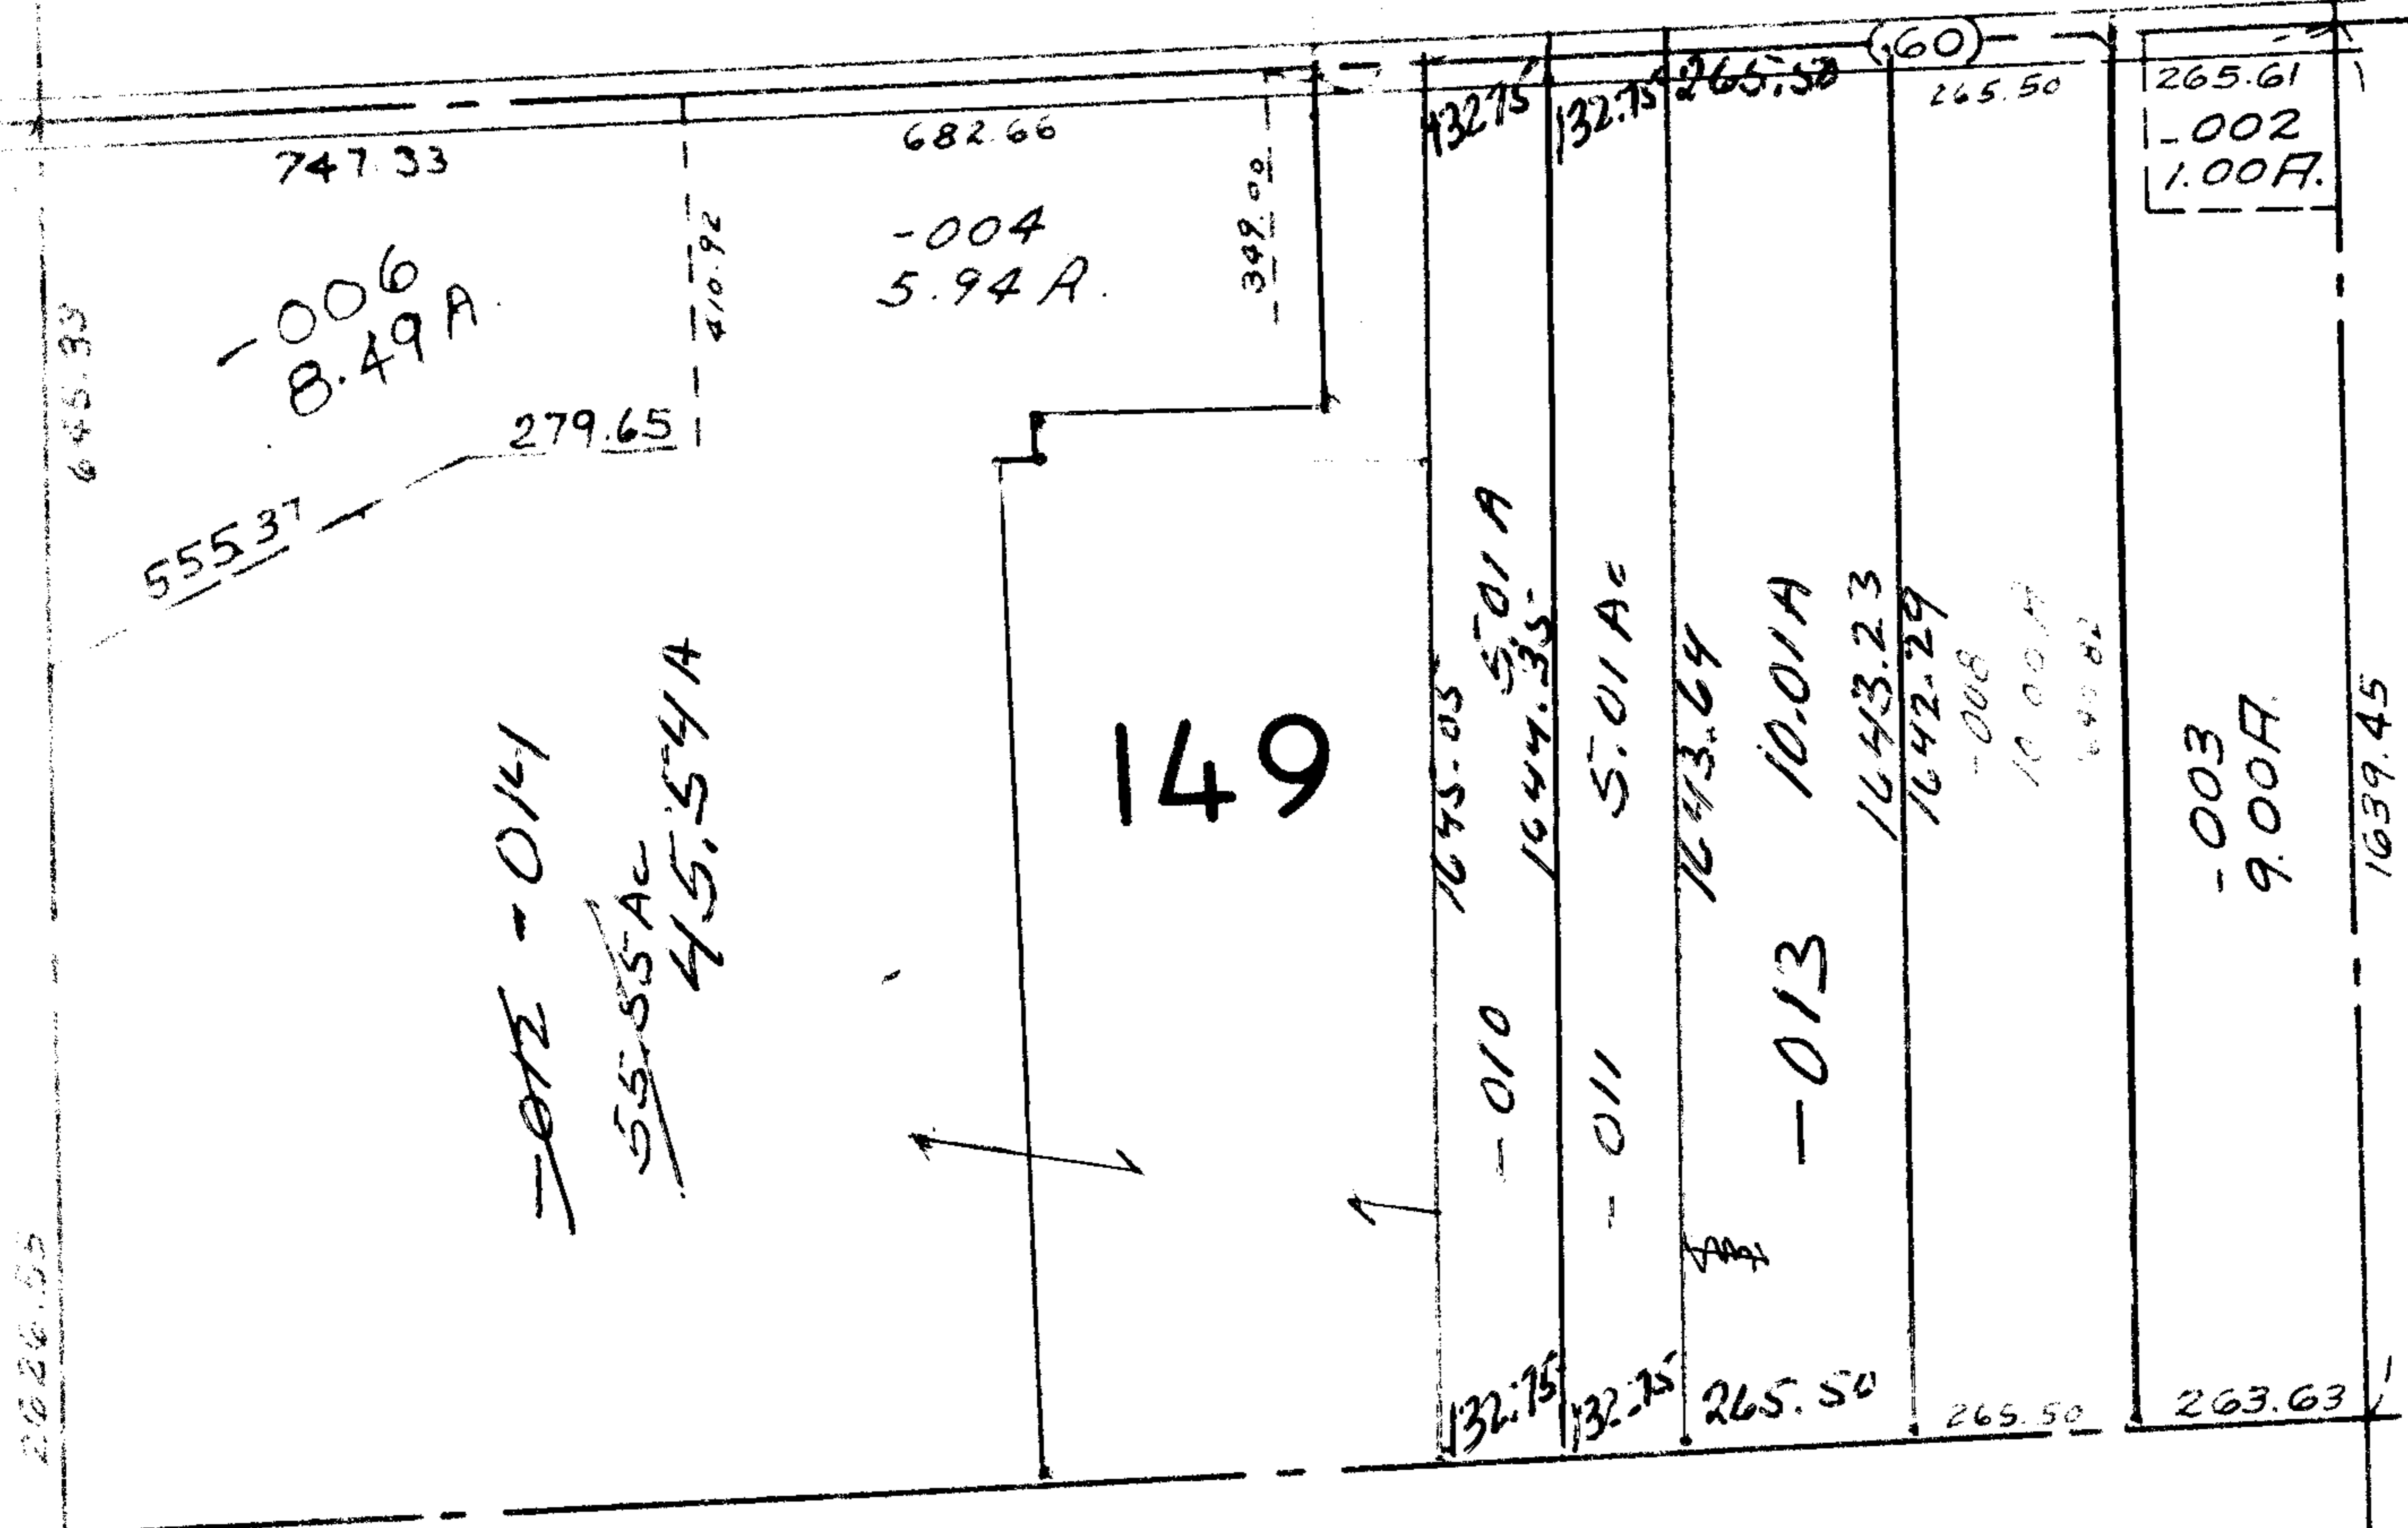

-001  
32.89 A.

152

-002  
79.50 A.

6459

**APPROVED**  
**LORAIN CO.**  
**MAP DEPT.**  
 DATE 10-26-72  
 14 E  
 BY L.W. Hall

See 5878

14 E