

6464

4 C

181.5
-003 3.22
775.5
775.5

2177.34

A


-005
49.57 A.

1025
993.3

993.3

2177.34

765

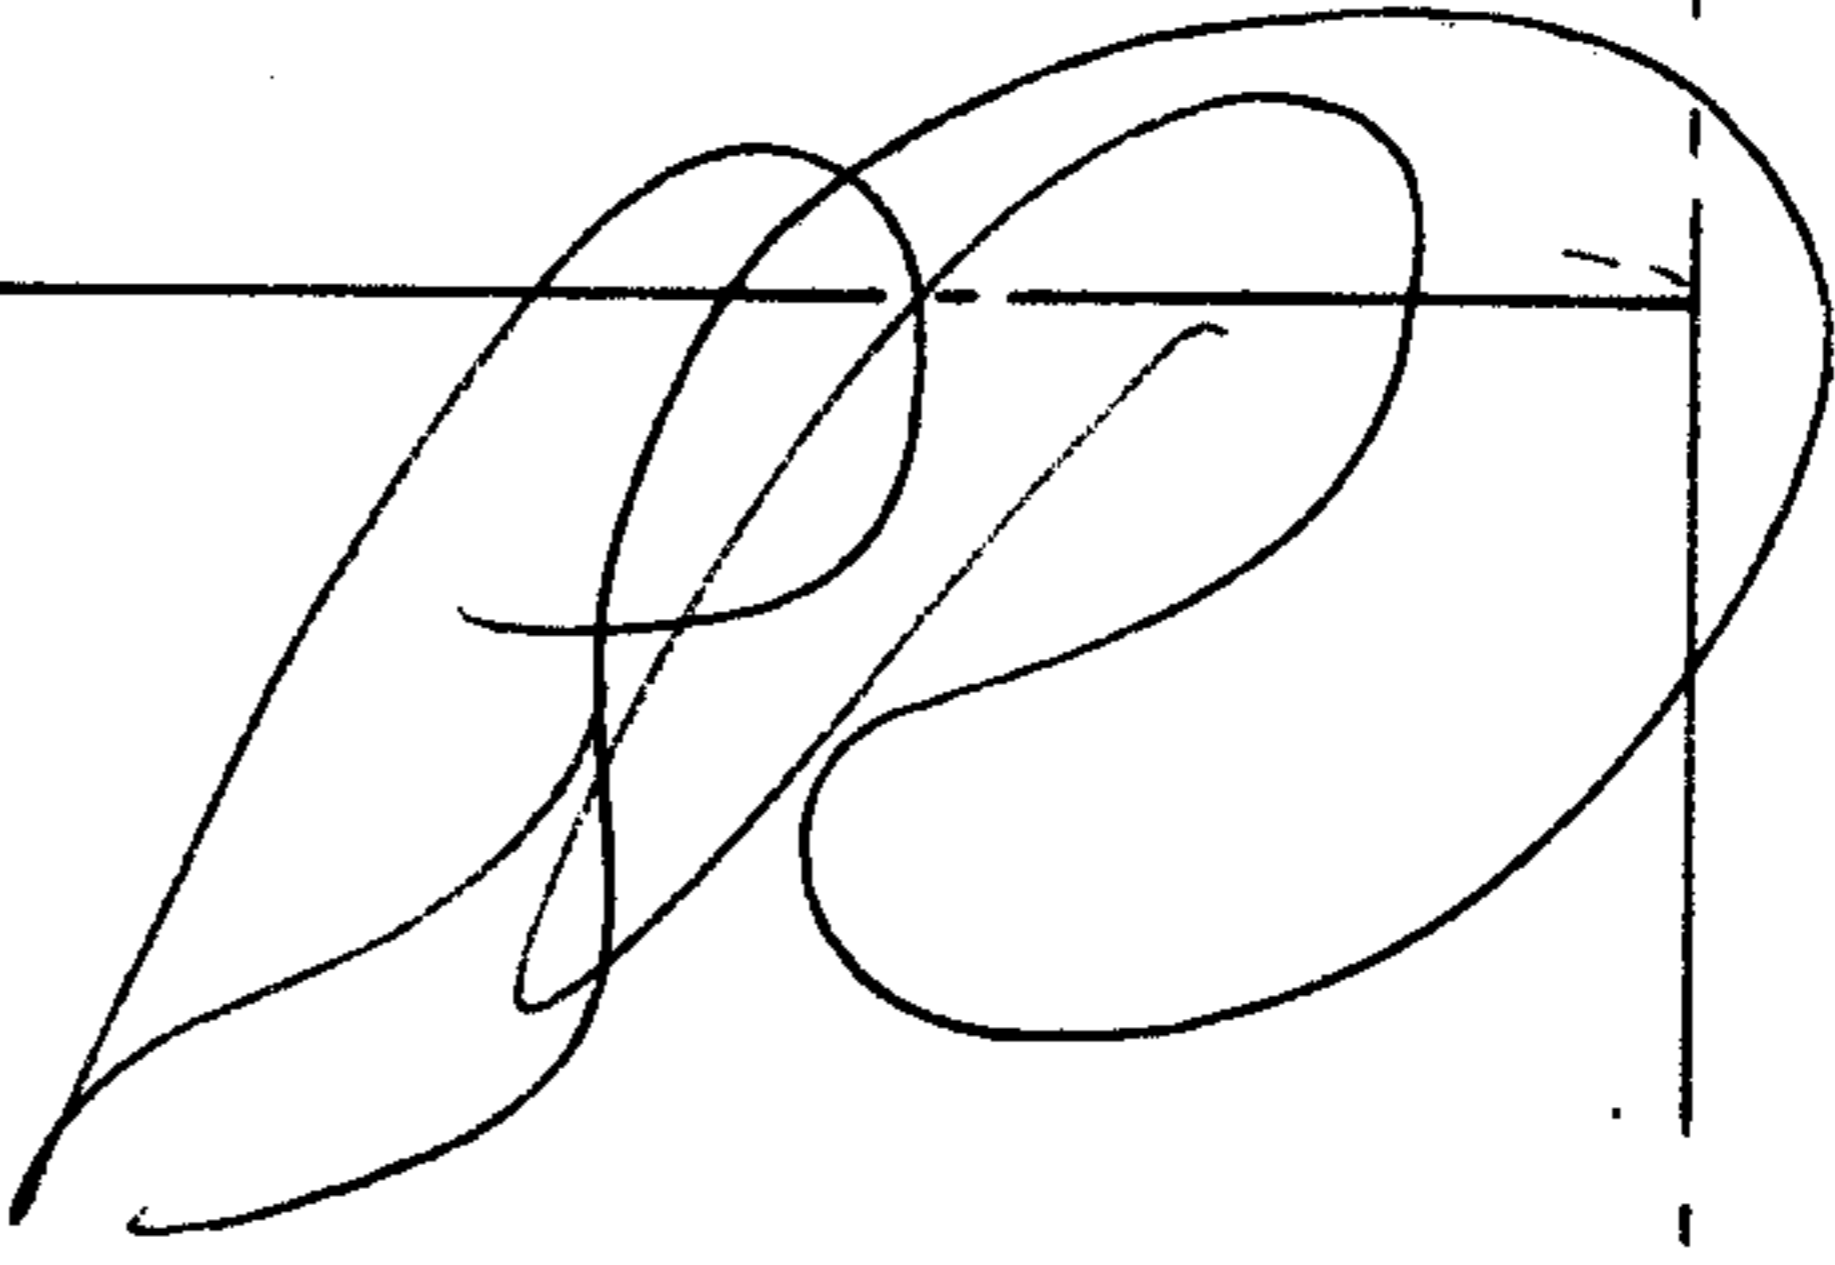

R

-009
~~-003~~
~~44.53 A.~~
36.04 AC

-007
84.68 A


6464

APPROVED
LORAIN CO.
MAP DEPT.
DATE 10-31-72
21C
BY L.V. Hall

8.9.
8-4-86

21C

Howley Rd

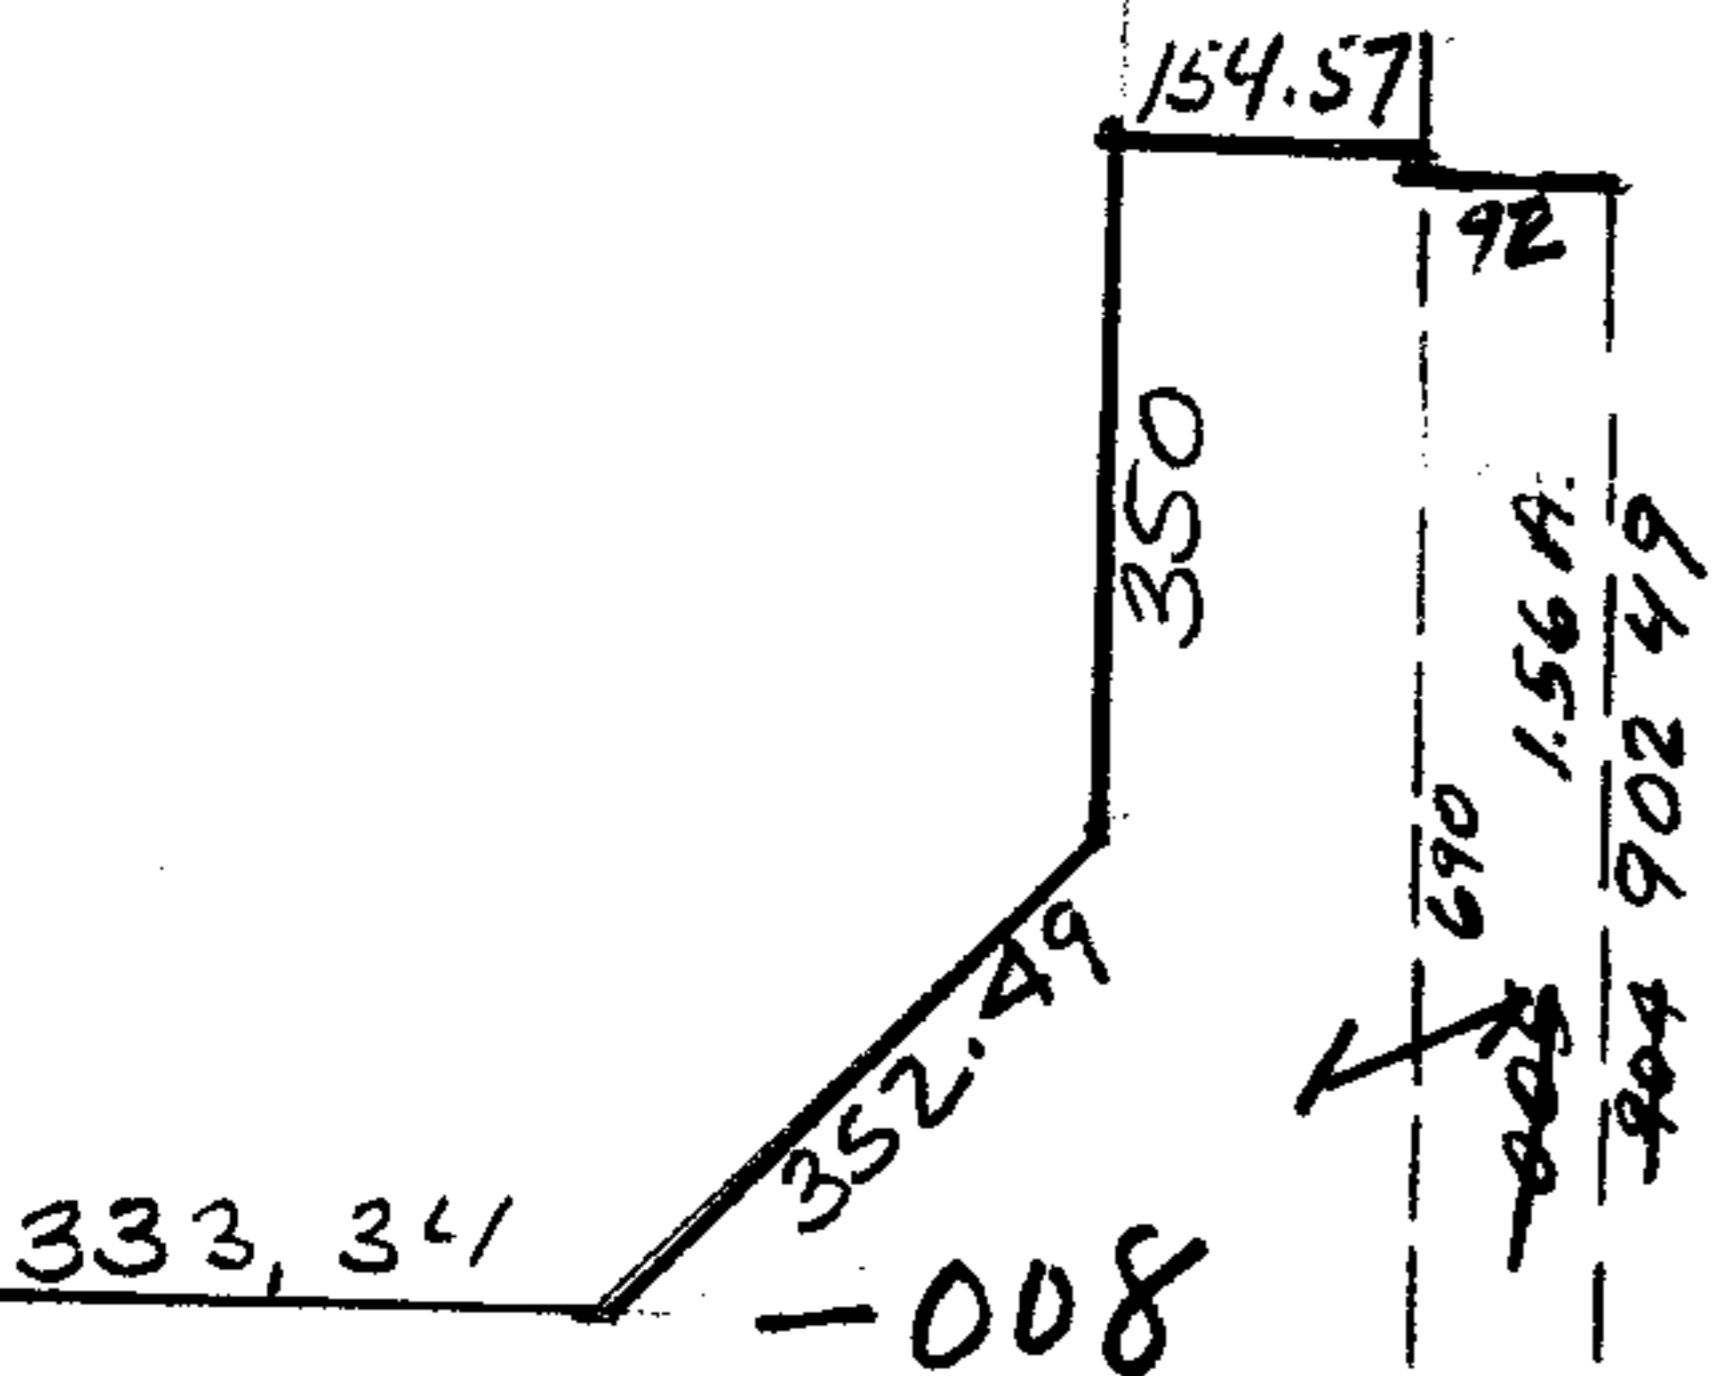

217.80
-006
1.00 A.
217.80

1575
838.66

RD.

1028.20
Bursley Rd

200
217
50A
5.70