


SEE 11

6471

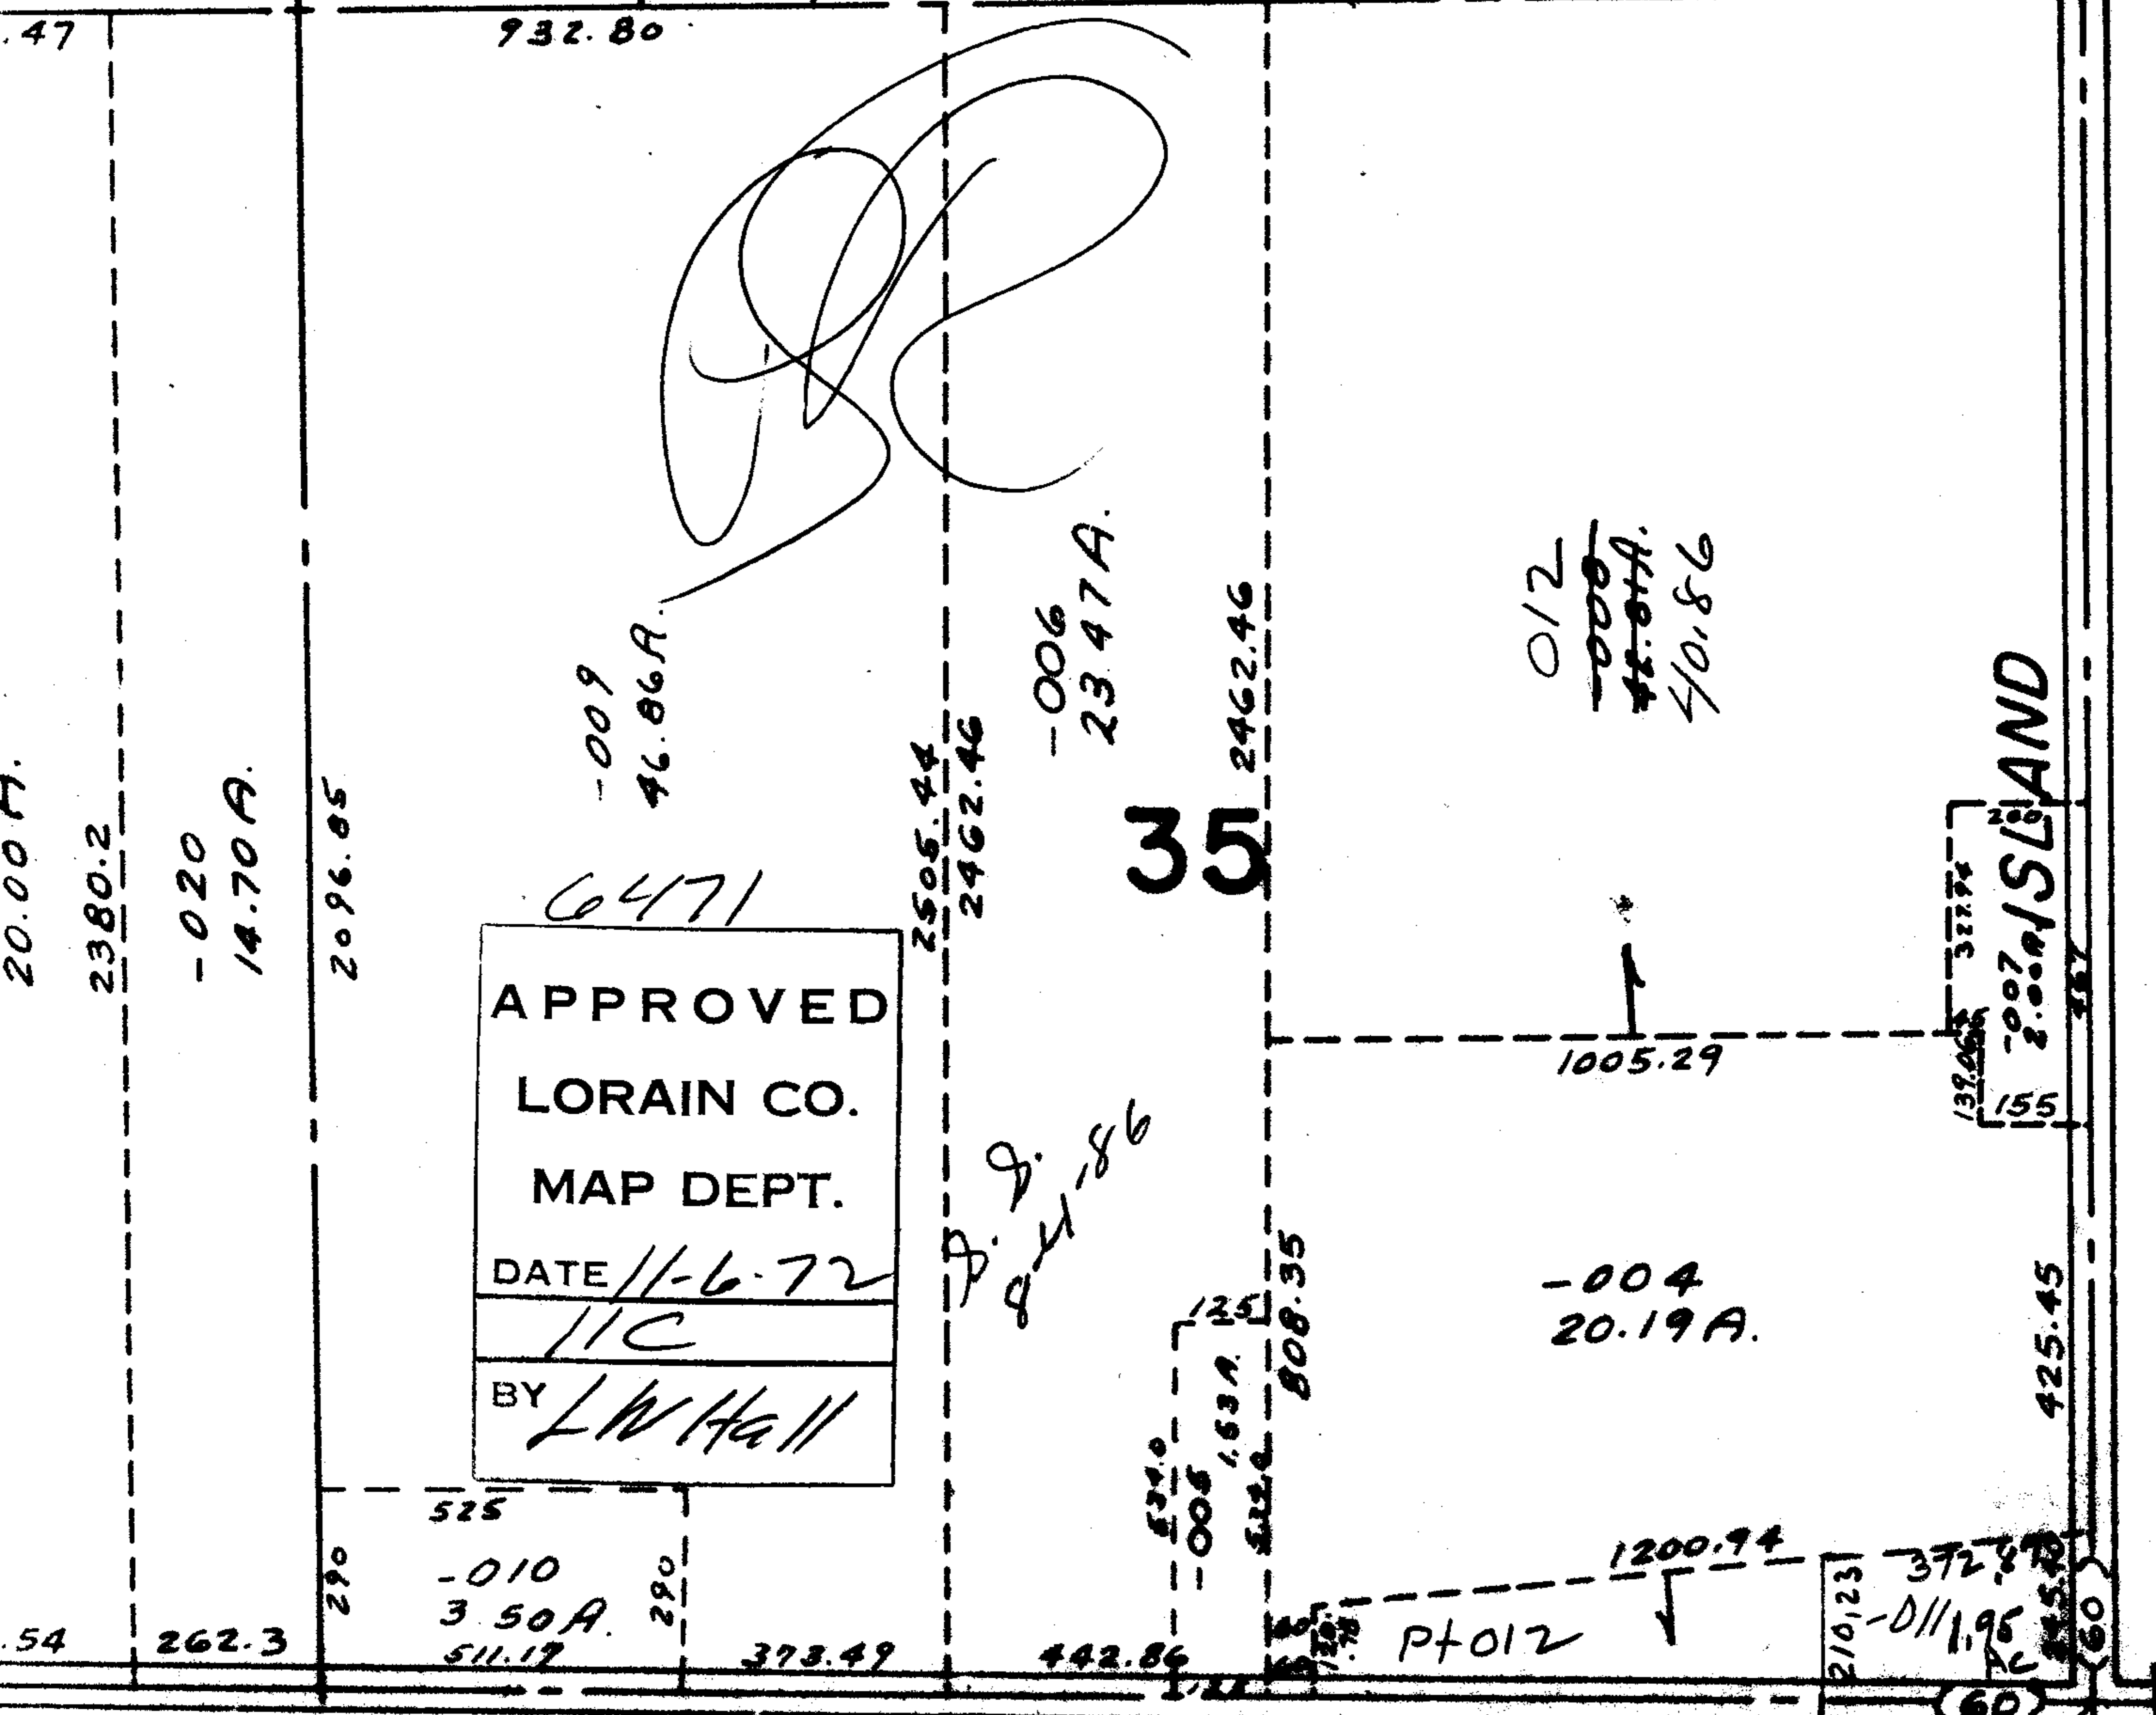

6471

APPROVED
LORAIN CO.
MAP DEPT.
DATE 11-6-72
BY LWHall

LOTS 31 THRU 35
46 " 50

11C

