

2683.56

76°50'

6480


-001
24.90 A.

300.3

-002
10.00 A.

-007
44.71 A.

225
-006
225
225
225

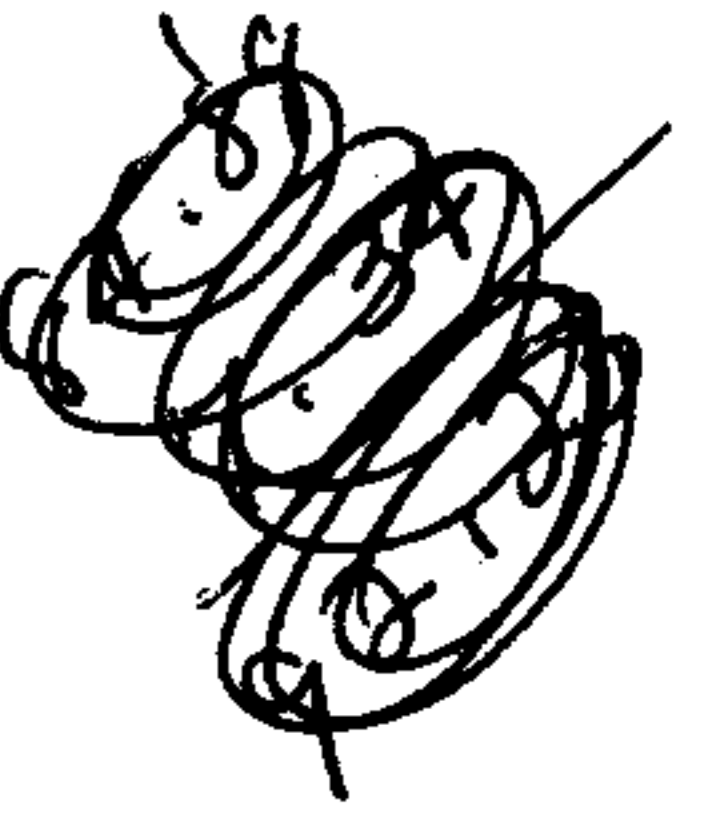

-003
~~7.00 A.~~
7.09 Ac.

550.4

-001
3.00 A.

-009
9.21 A.

-002
3.14 A.

-011
2.52 A.

-012
3.09 A.

-007
5.09 A.

996.20
996.07

1366.46
1666.46

88°34'

~~-004~~
50.00 A.

-013

40
84.89 Ac.

~~-005~~
4.24 A.

418.57

-014
7.34 Ac.

418.57

6480

APPROVED
LORAIN CO.
MAP DEPT.

DATE 11-10-72

16-A

BY

[Signature]

7-25-86 L.H.

-006
49.00 A.

91.21
84.89
6.32
7.34 A

217.0
1-002
2-003
217
014
1.00A
217