

1579.38

-001
52.50F.

52

-002
52.50F.

6488

414.48

~~3899A~~
-006
-008
35.11 Ac.

69

-003
35.00F.


-004
16.75F.

6488

280
-005
1.01 A.
158.0
-007 1070
3.88 Ac.
1070
280

APPROVED
LORAIN CO.
MAP DEPT.
DATE 11-13-72
14-A
BY *J. Collier*

-002
11.00F.

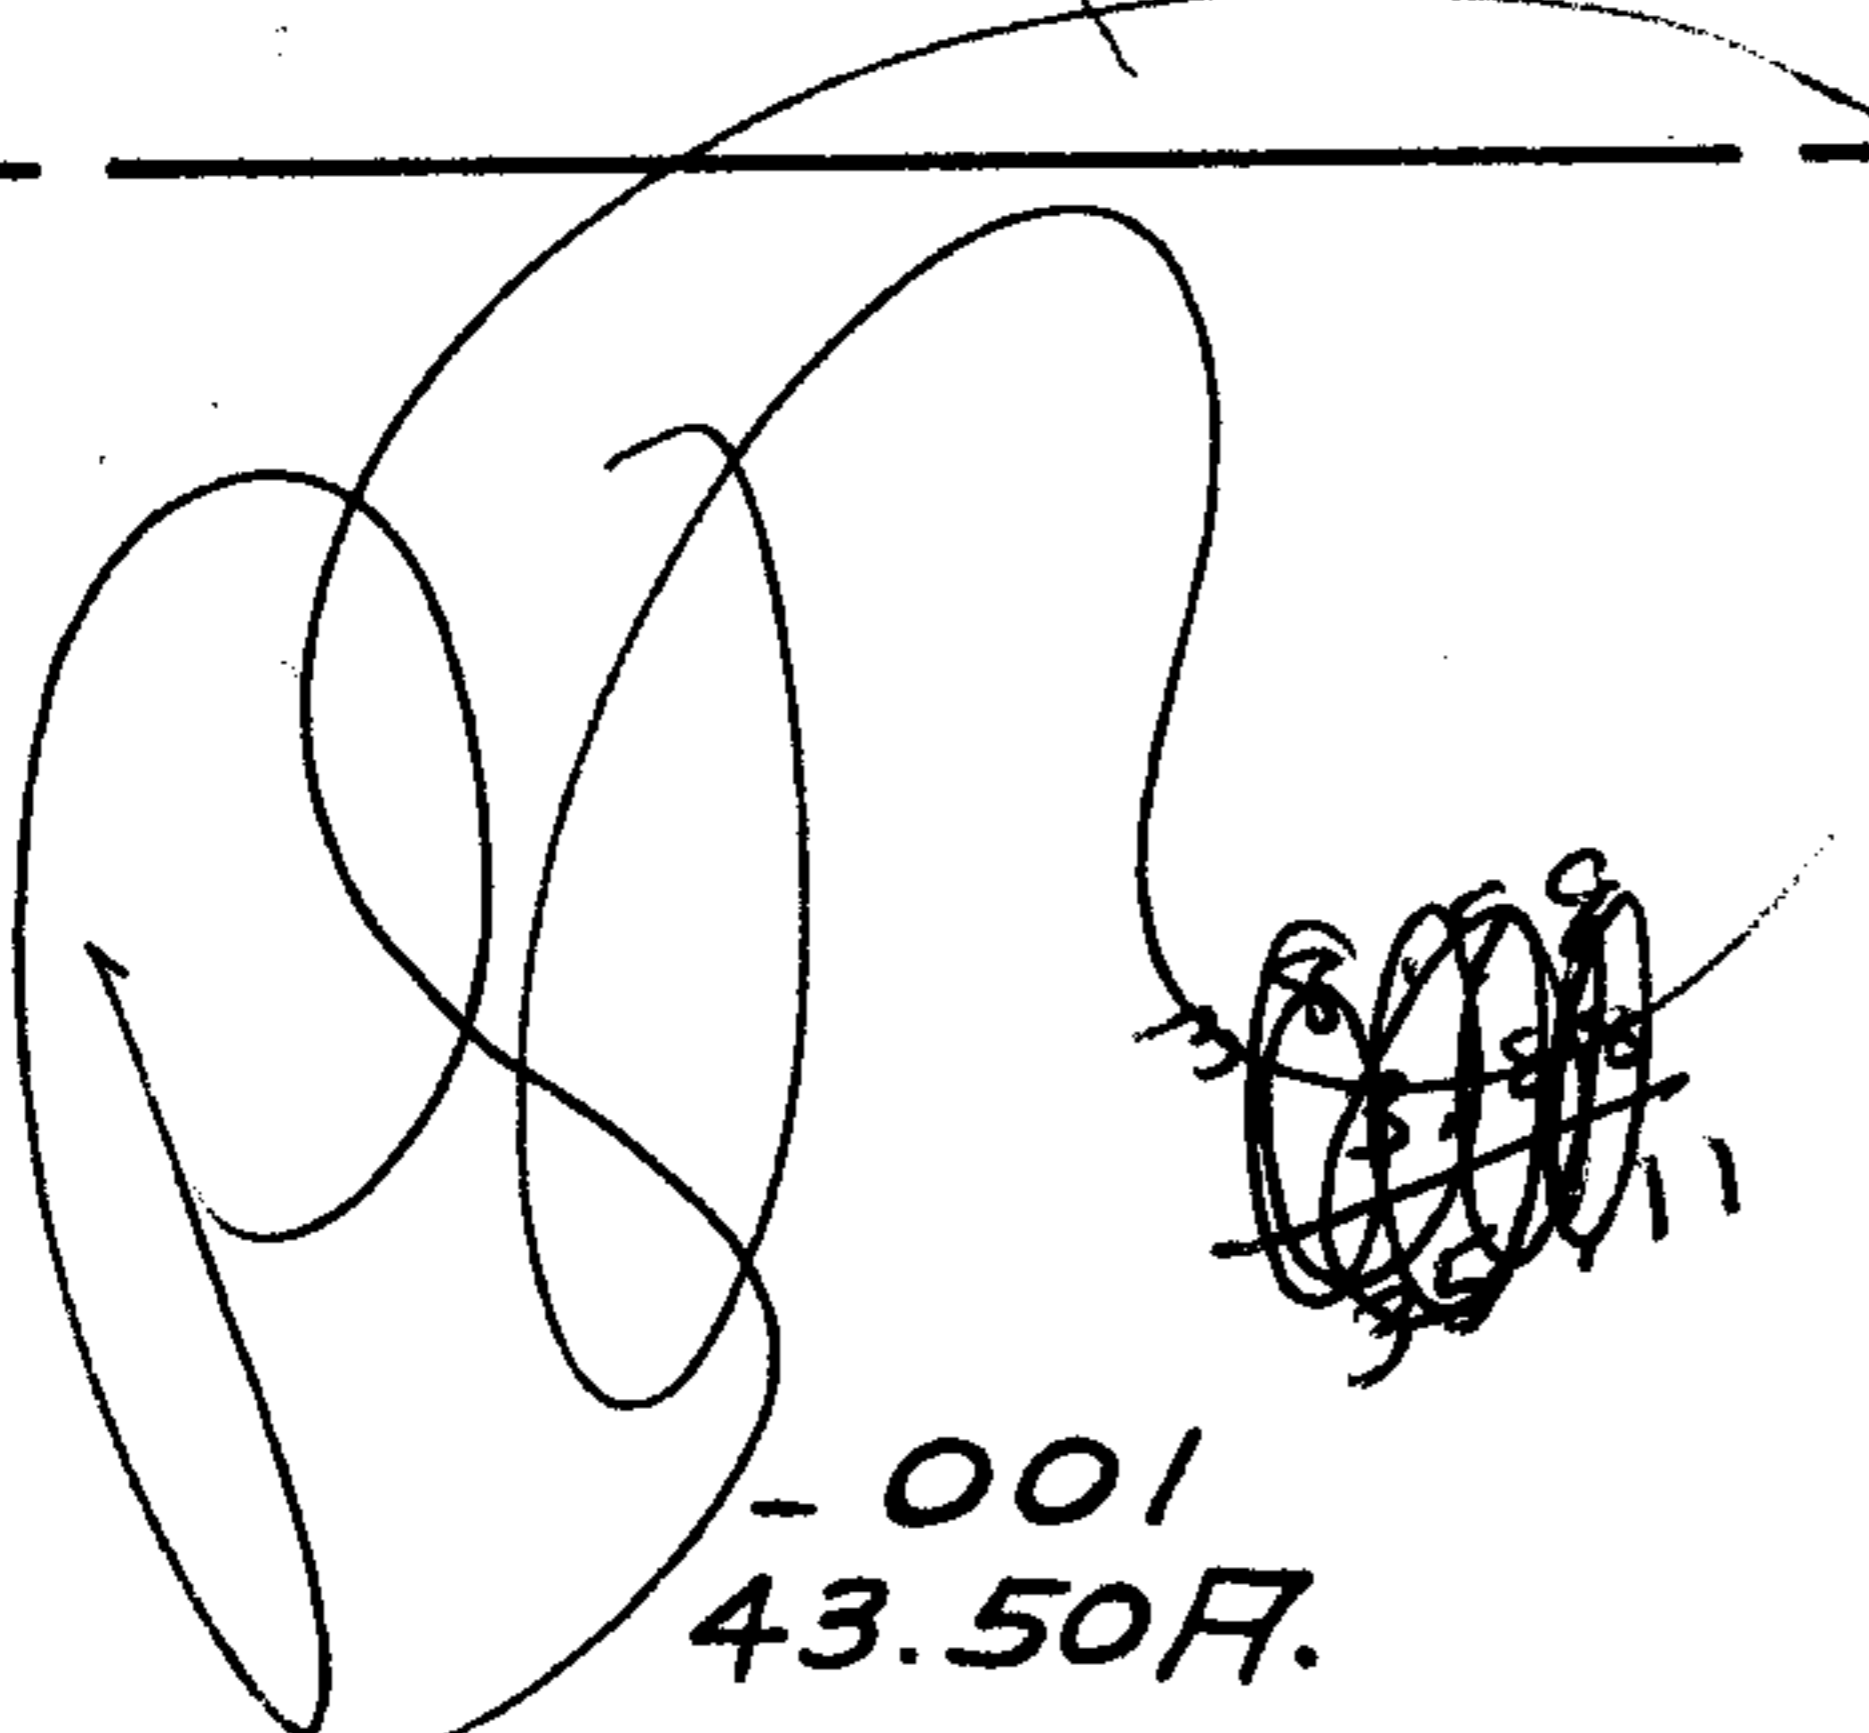

-001
43.50F.

72

-002
39.50F.

-003
3.70F.

200
100
20000
43560

QUARRY (60)

88°35'

1110.2

RD

(60)

303

E 14 - E