


6499

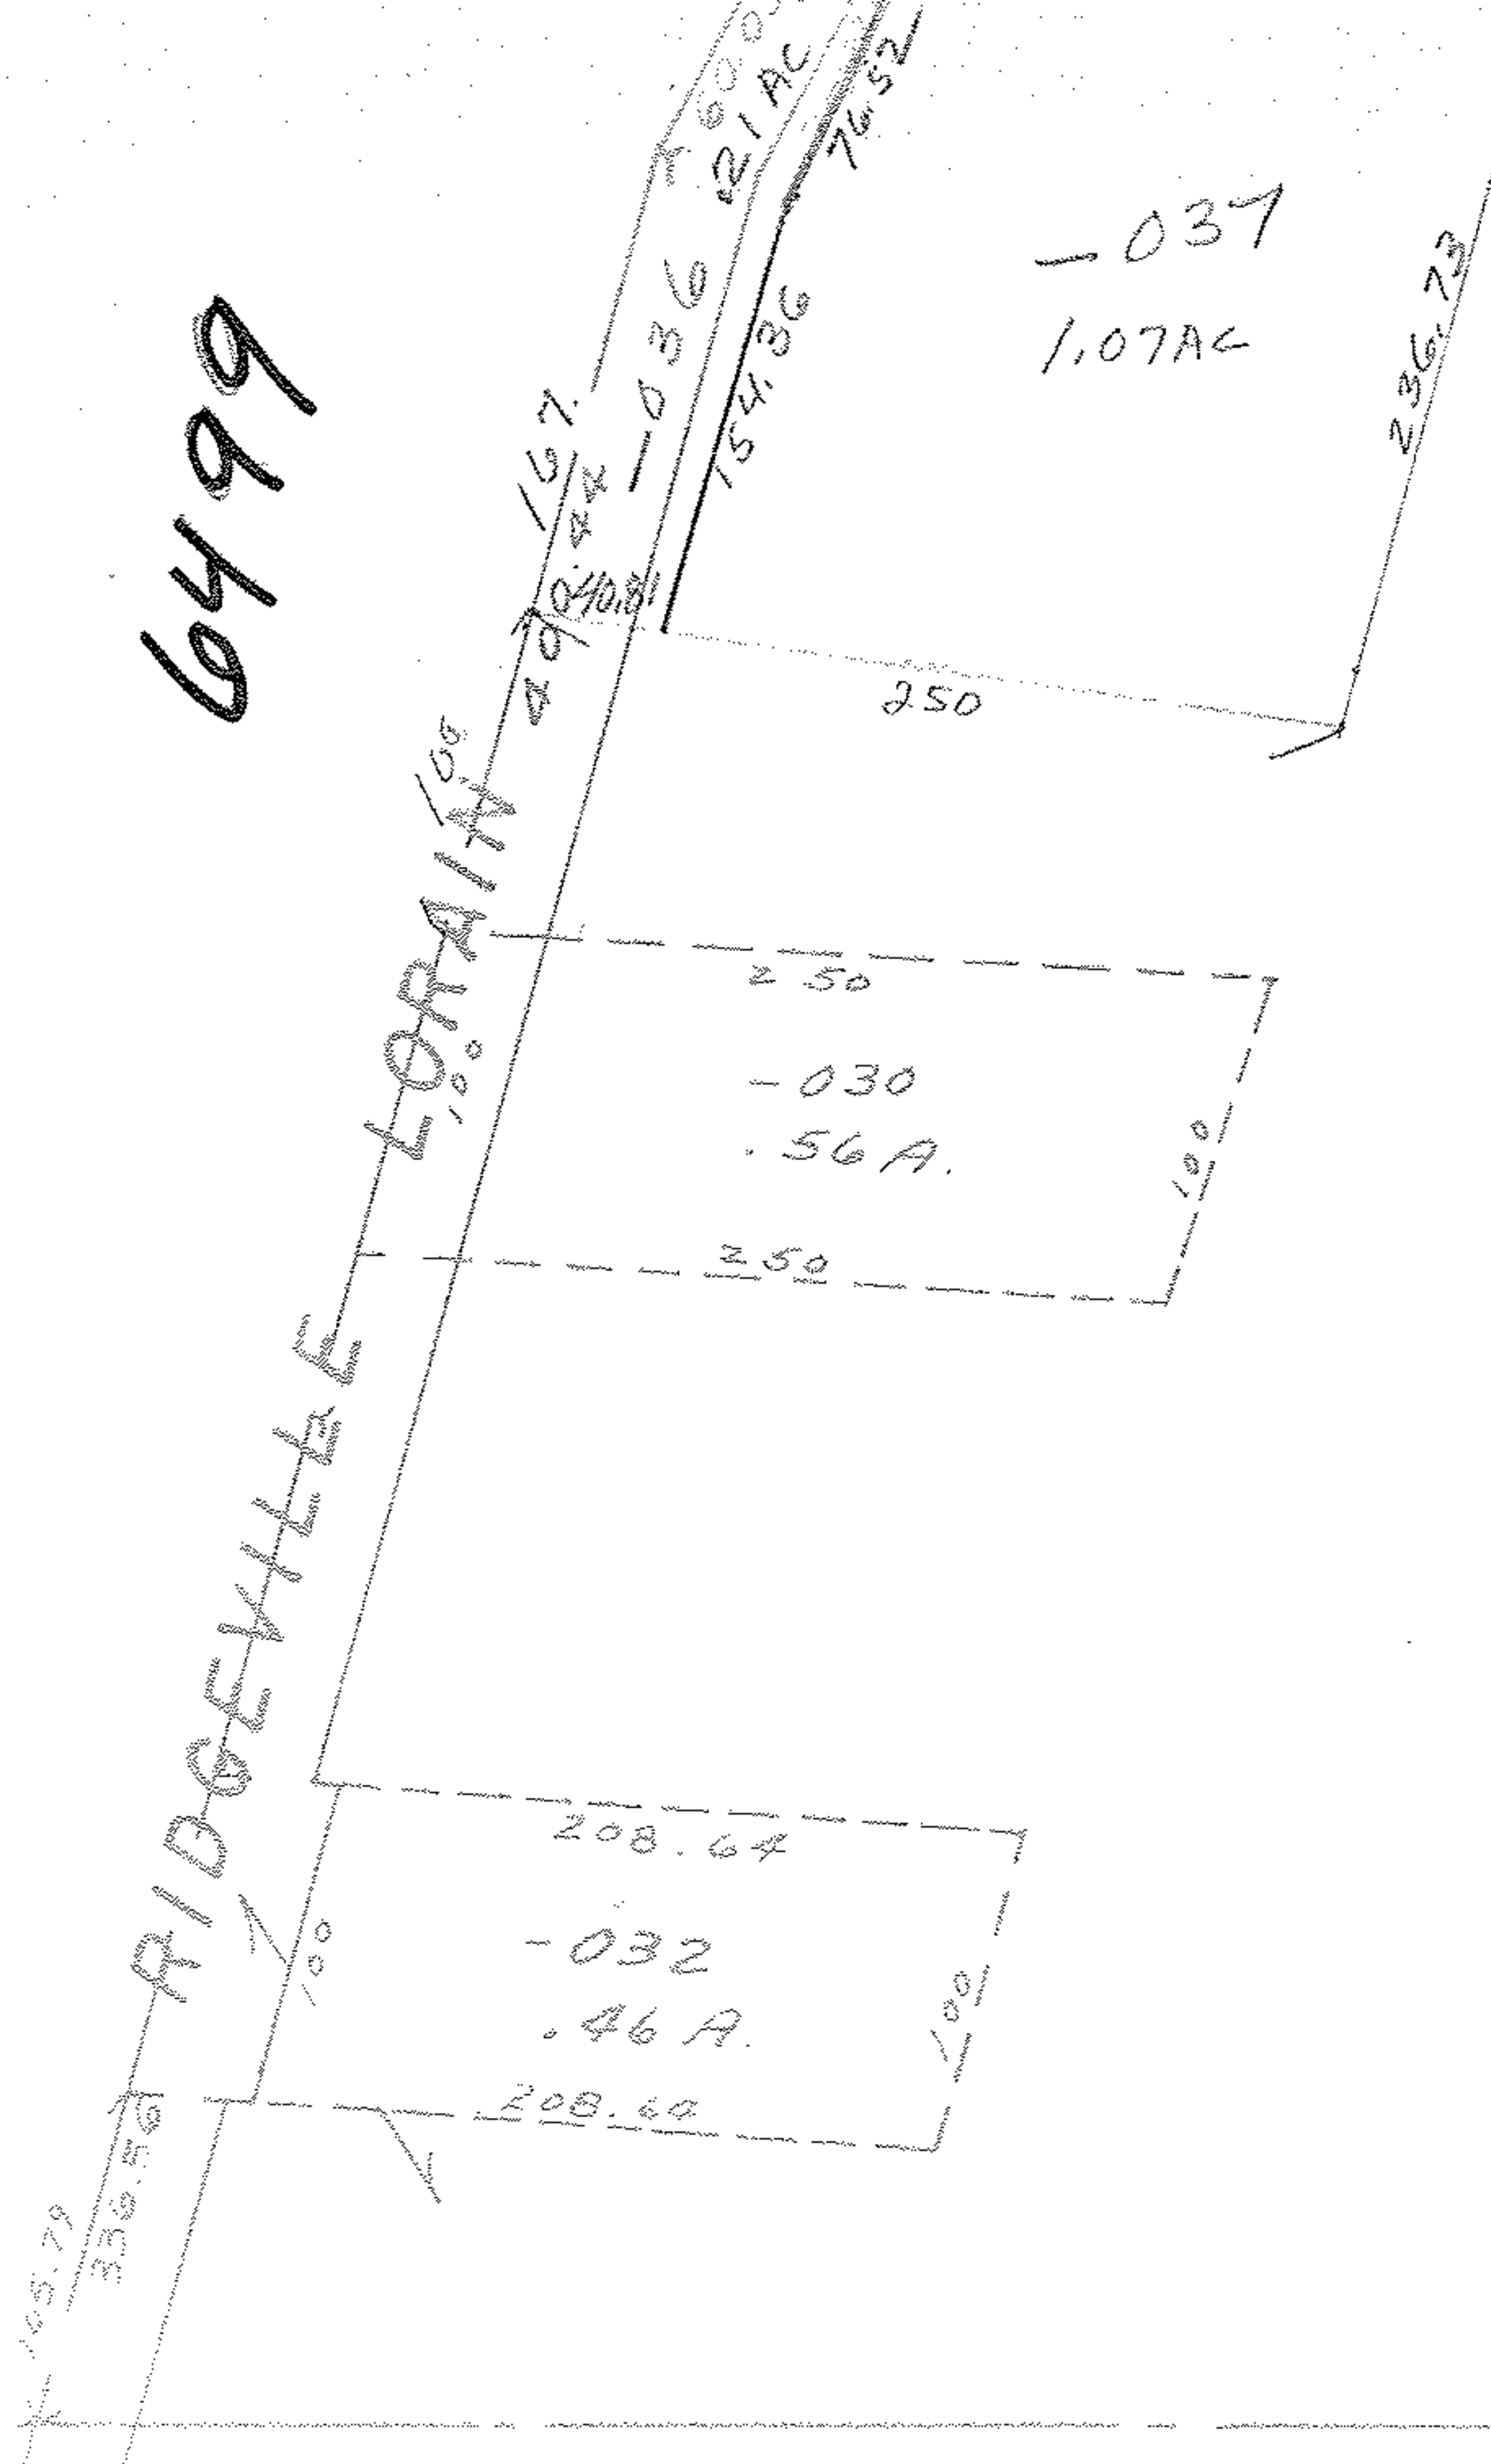

6499
 APPROVED
 LORAIN CO.
 MAP DEPT.
 DATE 11-14-72
 04-00-0114
 BY LWHall

PR

-038
~~433~~
~~27.03A.~~
 25.75 AC

4-00-0114

2344-10
 SF 4-00-012-0

90°30'

440.68

297.73

90°30'