


6503

~~031~~ 041
~~38.09~~ 37.92

[Large handwritten signature]

MITCHELL

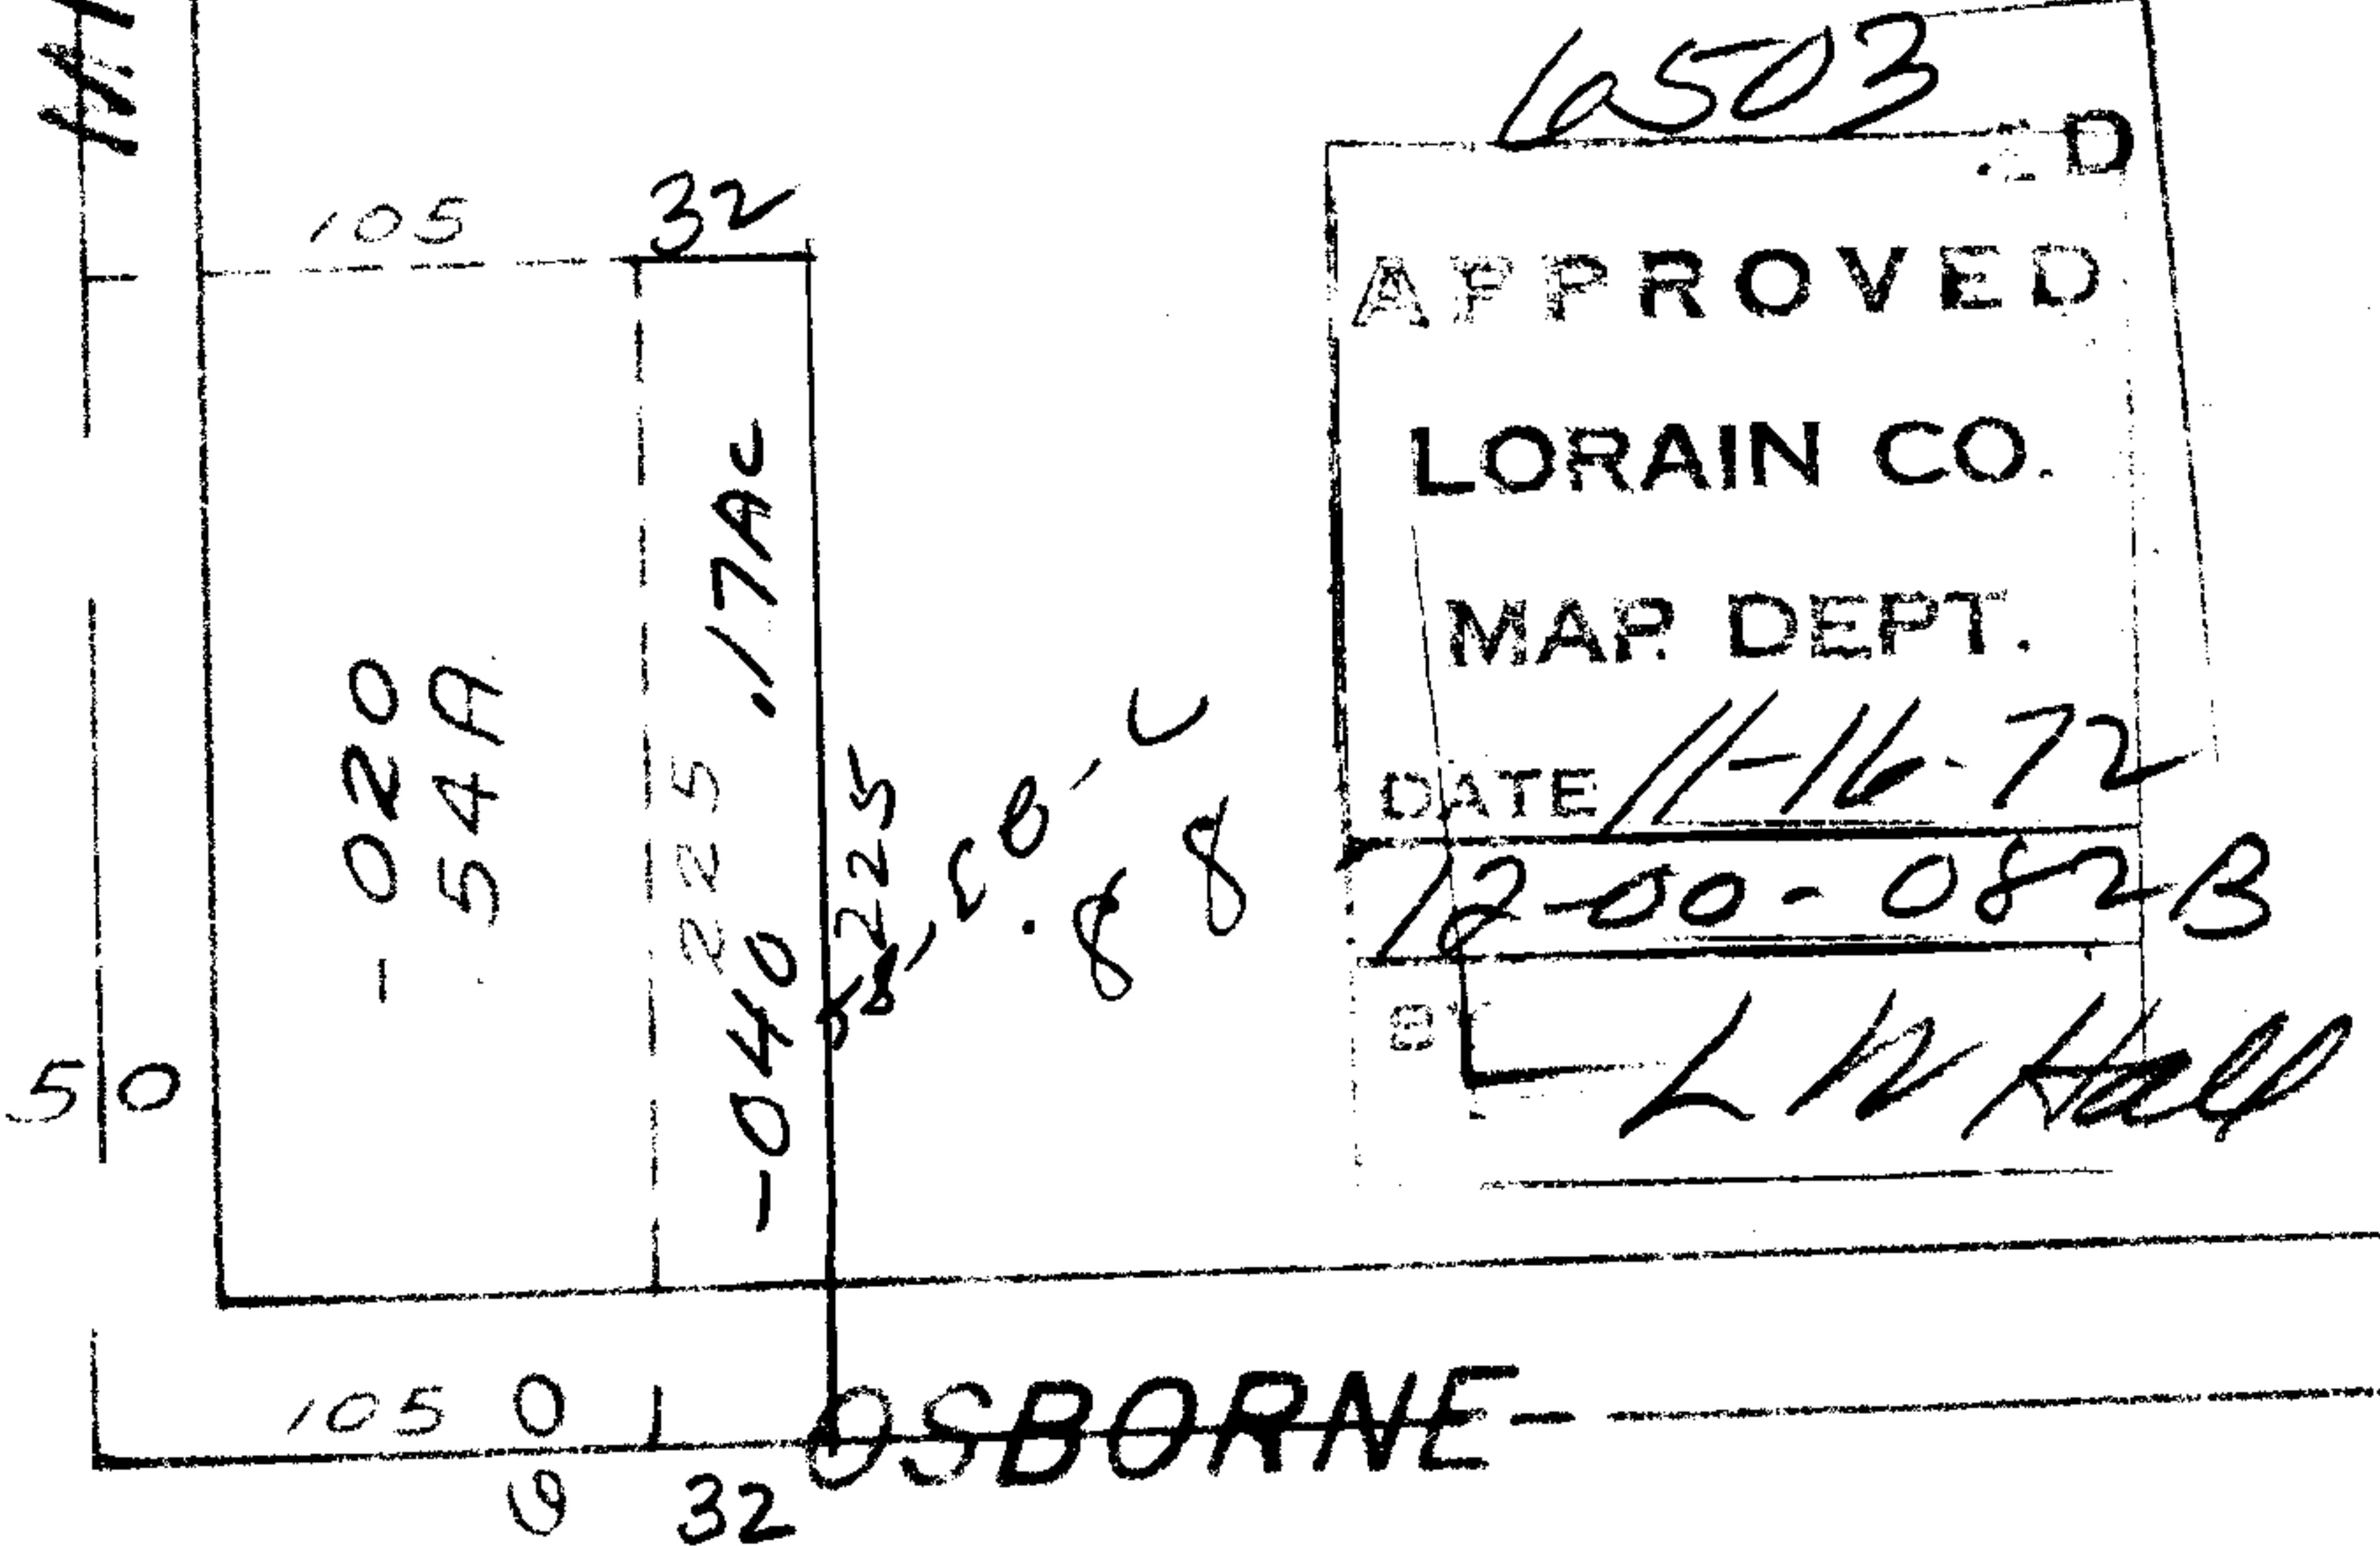

6503
 APPROVED
 LORAIN CO.
 MAP DEPT.
 DATE 11-16-72
 12-00-082B
 L W Hall

From sheet OK

12-00-082B
COLUMBIA TWP
 SCALE 1" = 100'

6503