


6505

105

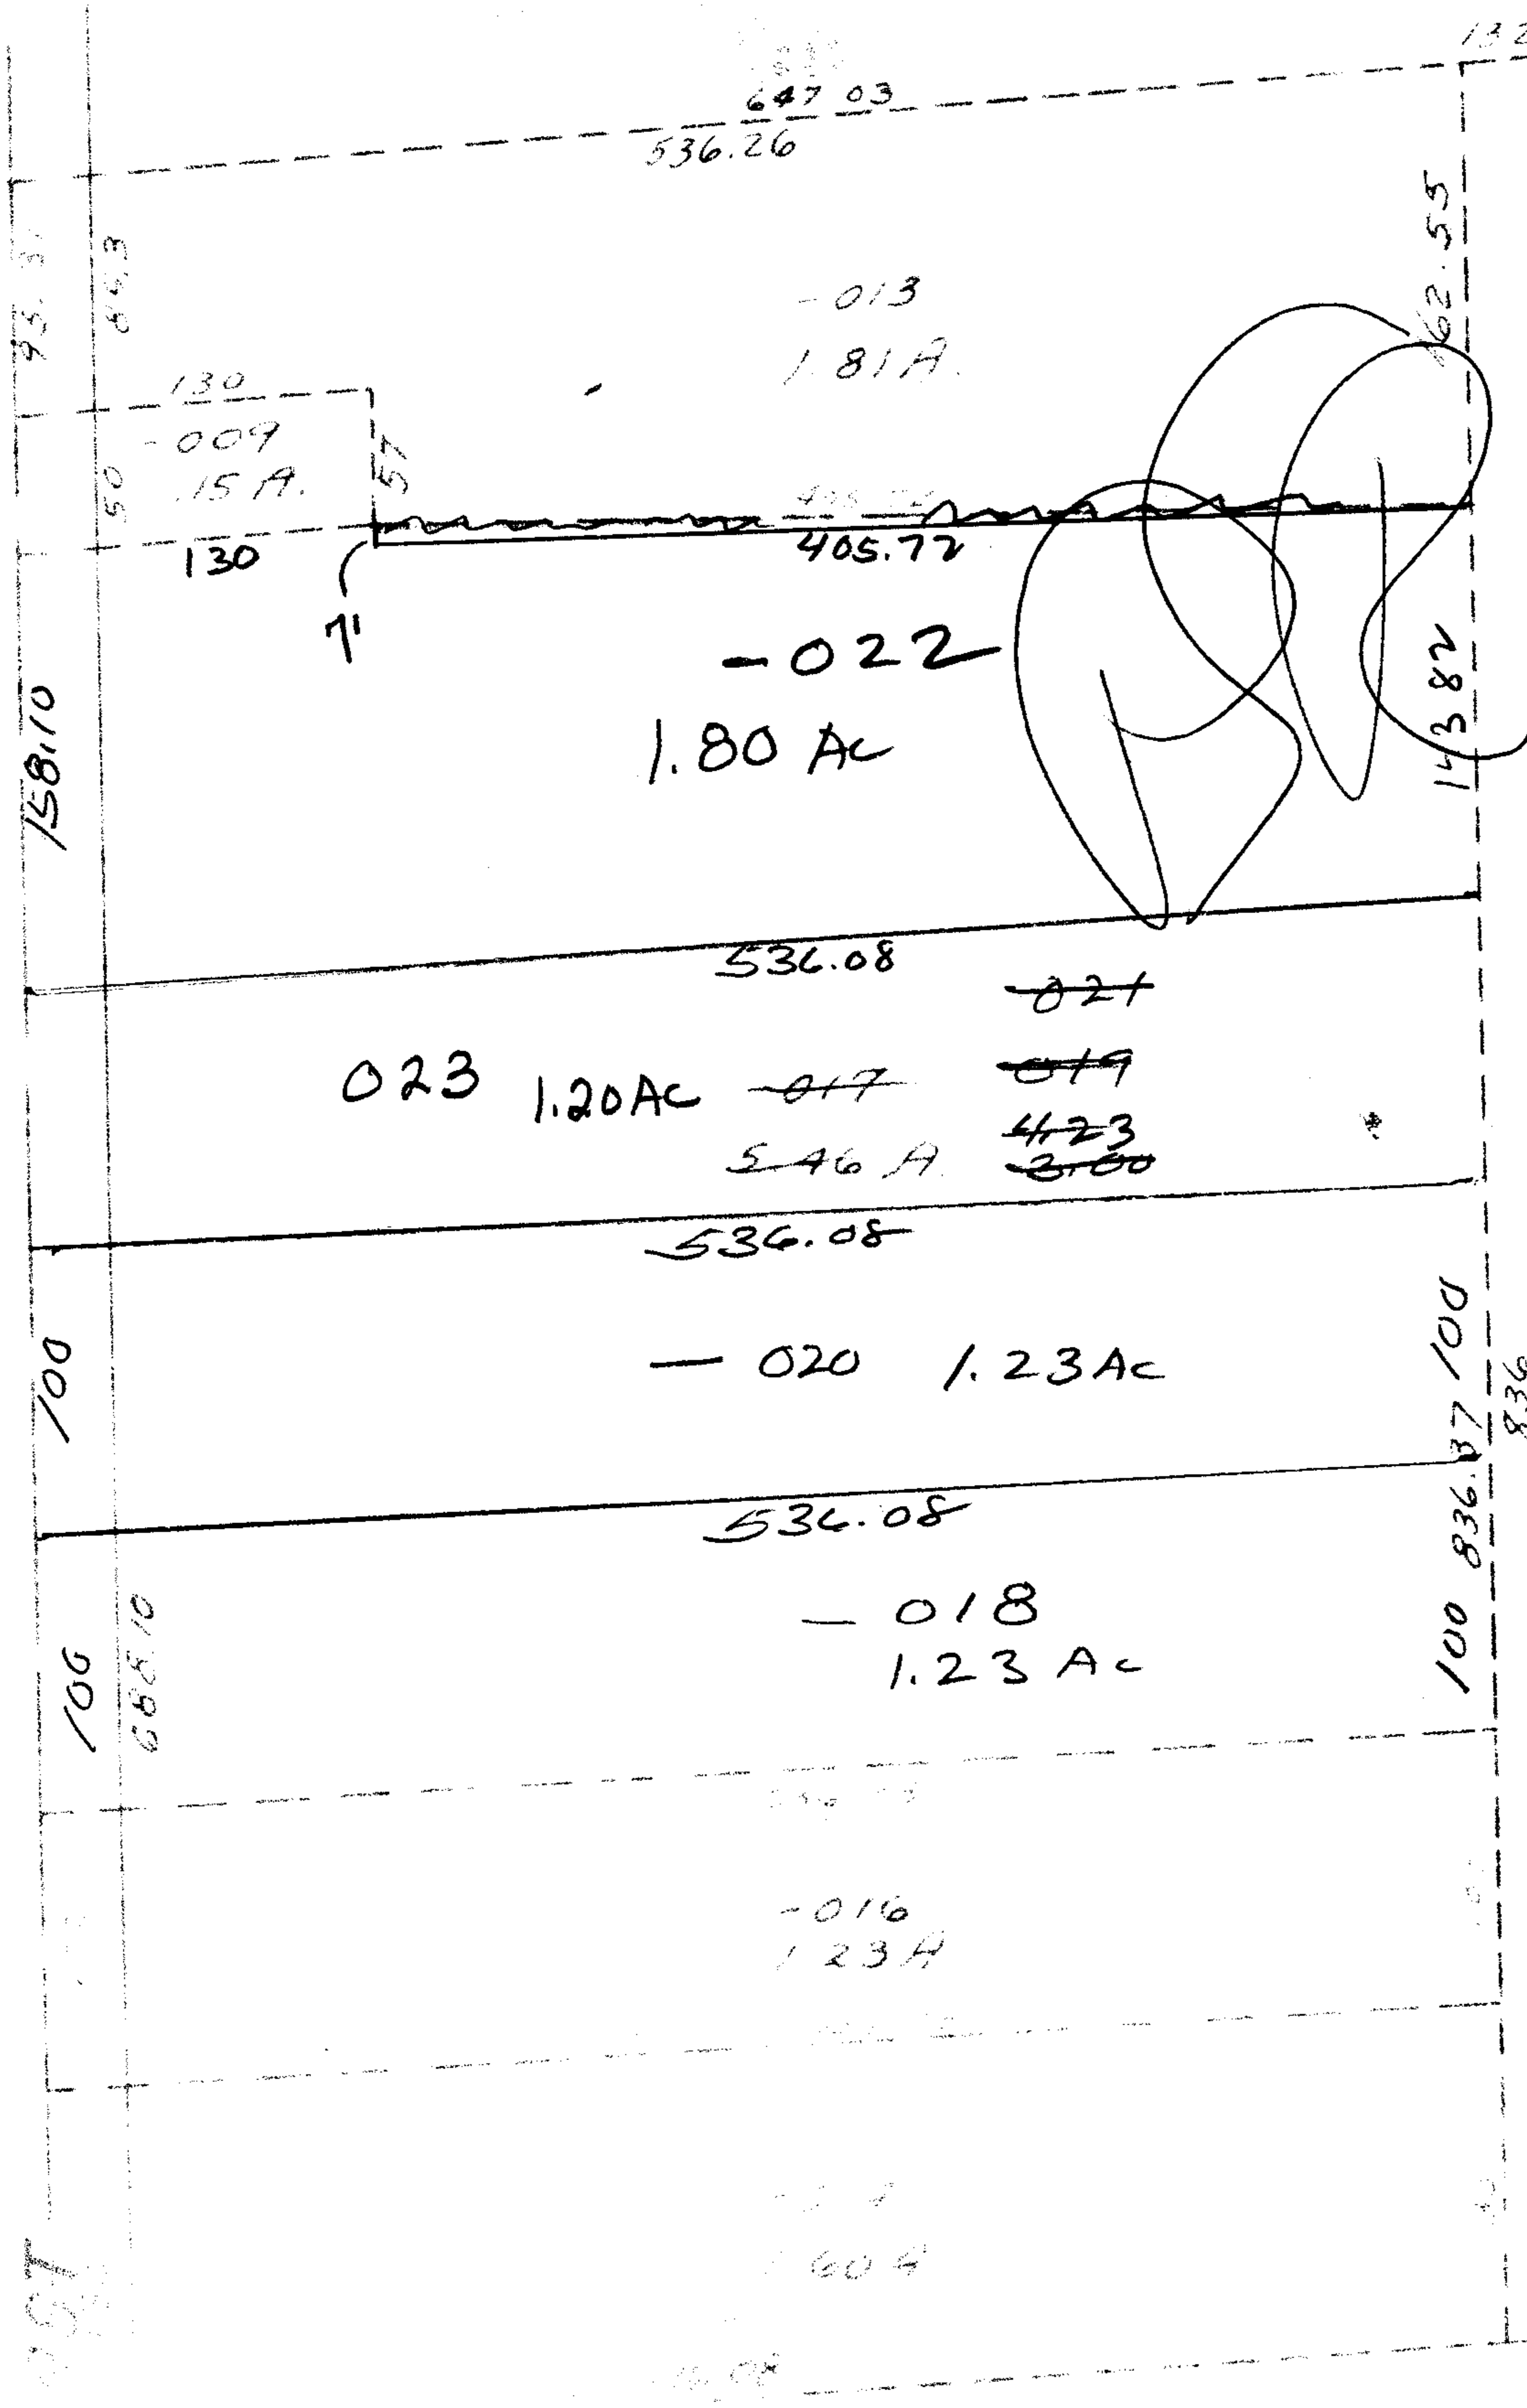

6505

**APPROVED**  
**LORAIN CO.**  
**MAP DEPT.**  
 DATE 11-17-72  
 9-00-003B  
 BY L W Hall

5.5  
7-23-56

Trans  
Sheet  
OK