


23

6506



New London Eastern 2317.22

1514.36

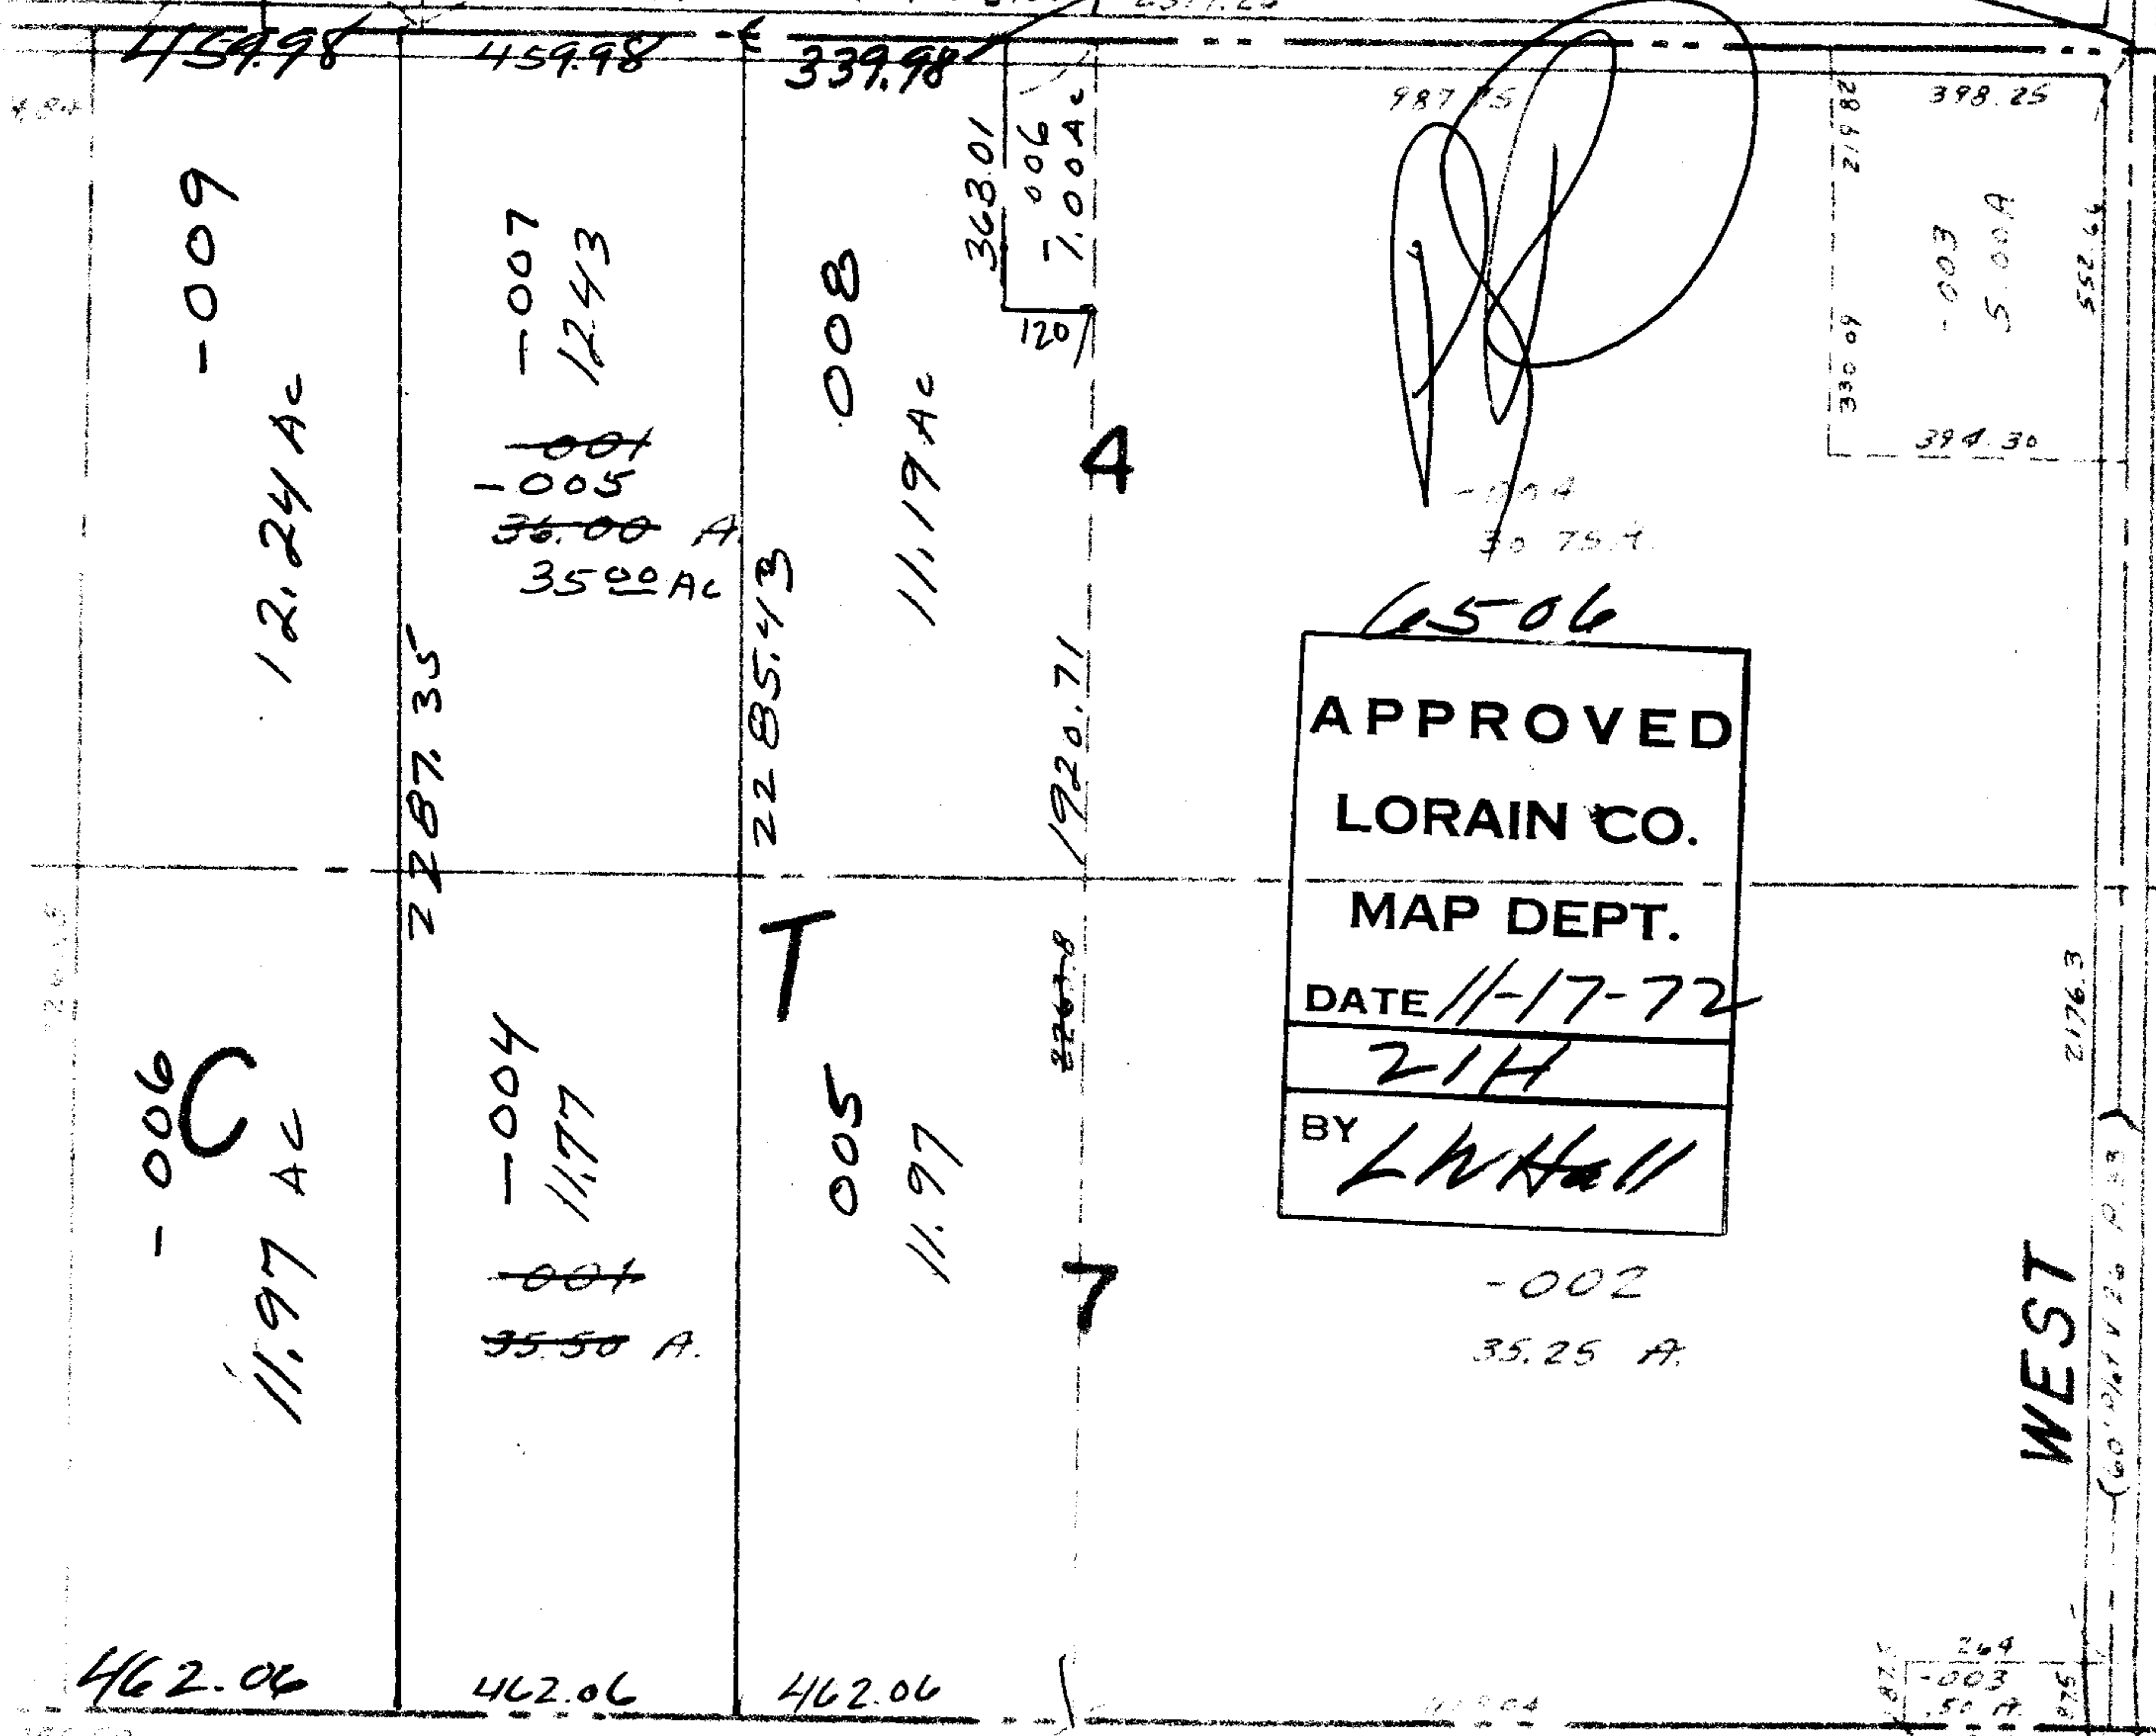

TRACT 8 LOTS 3 THRU
 " 17 " 12, 13, 14, 15