



6509

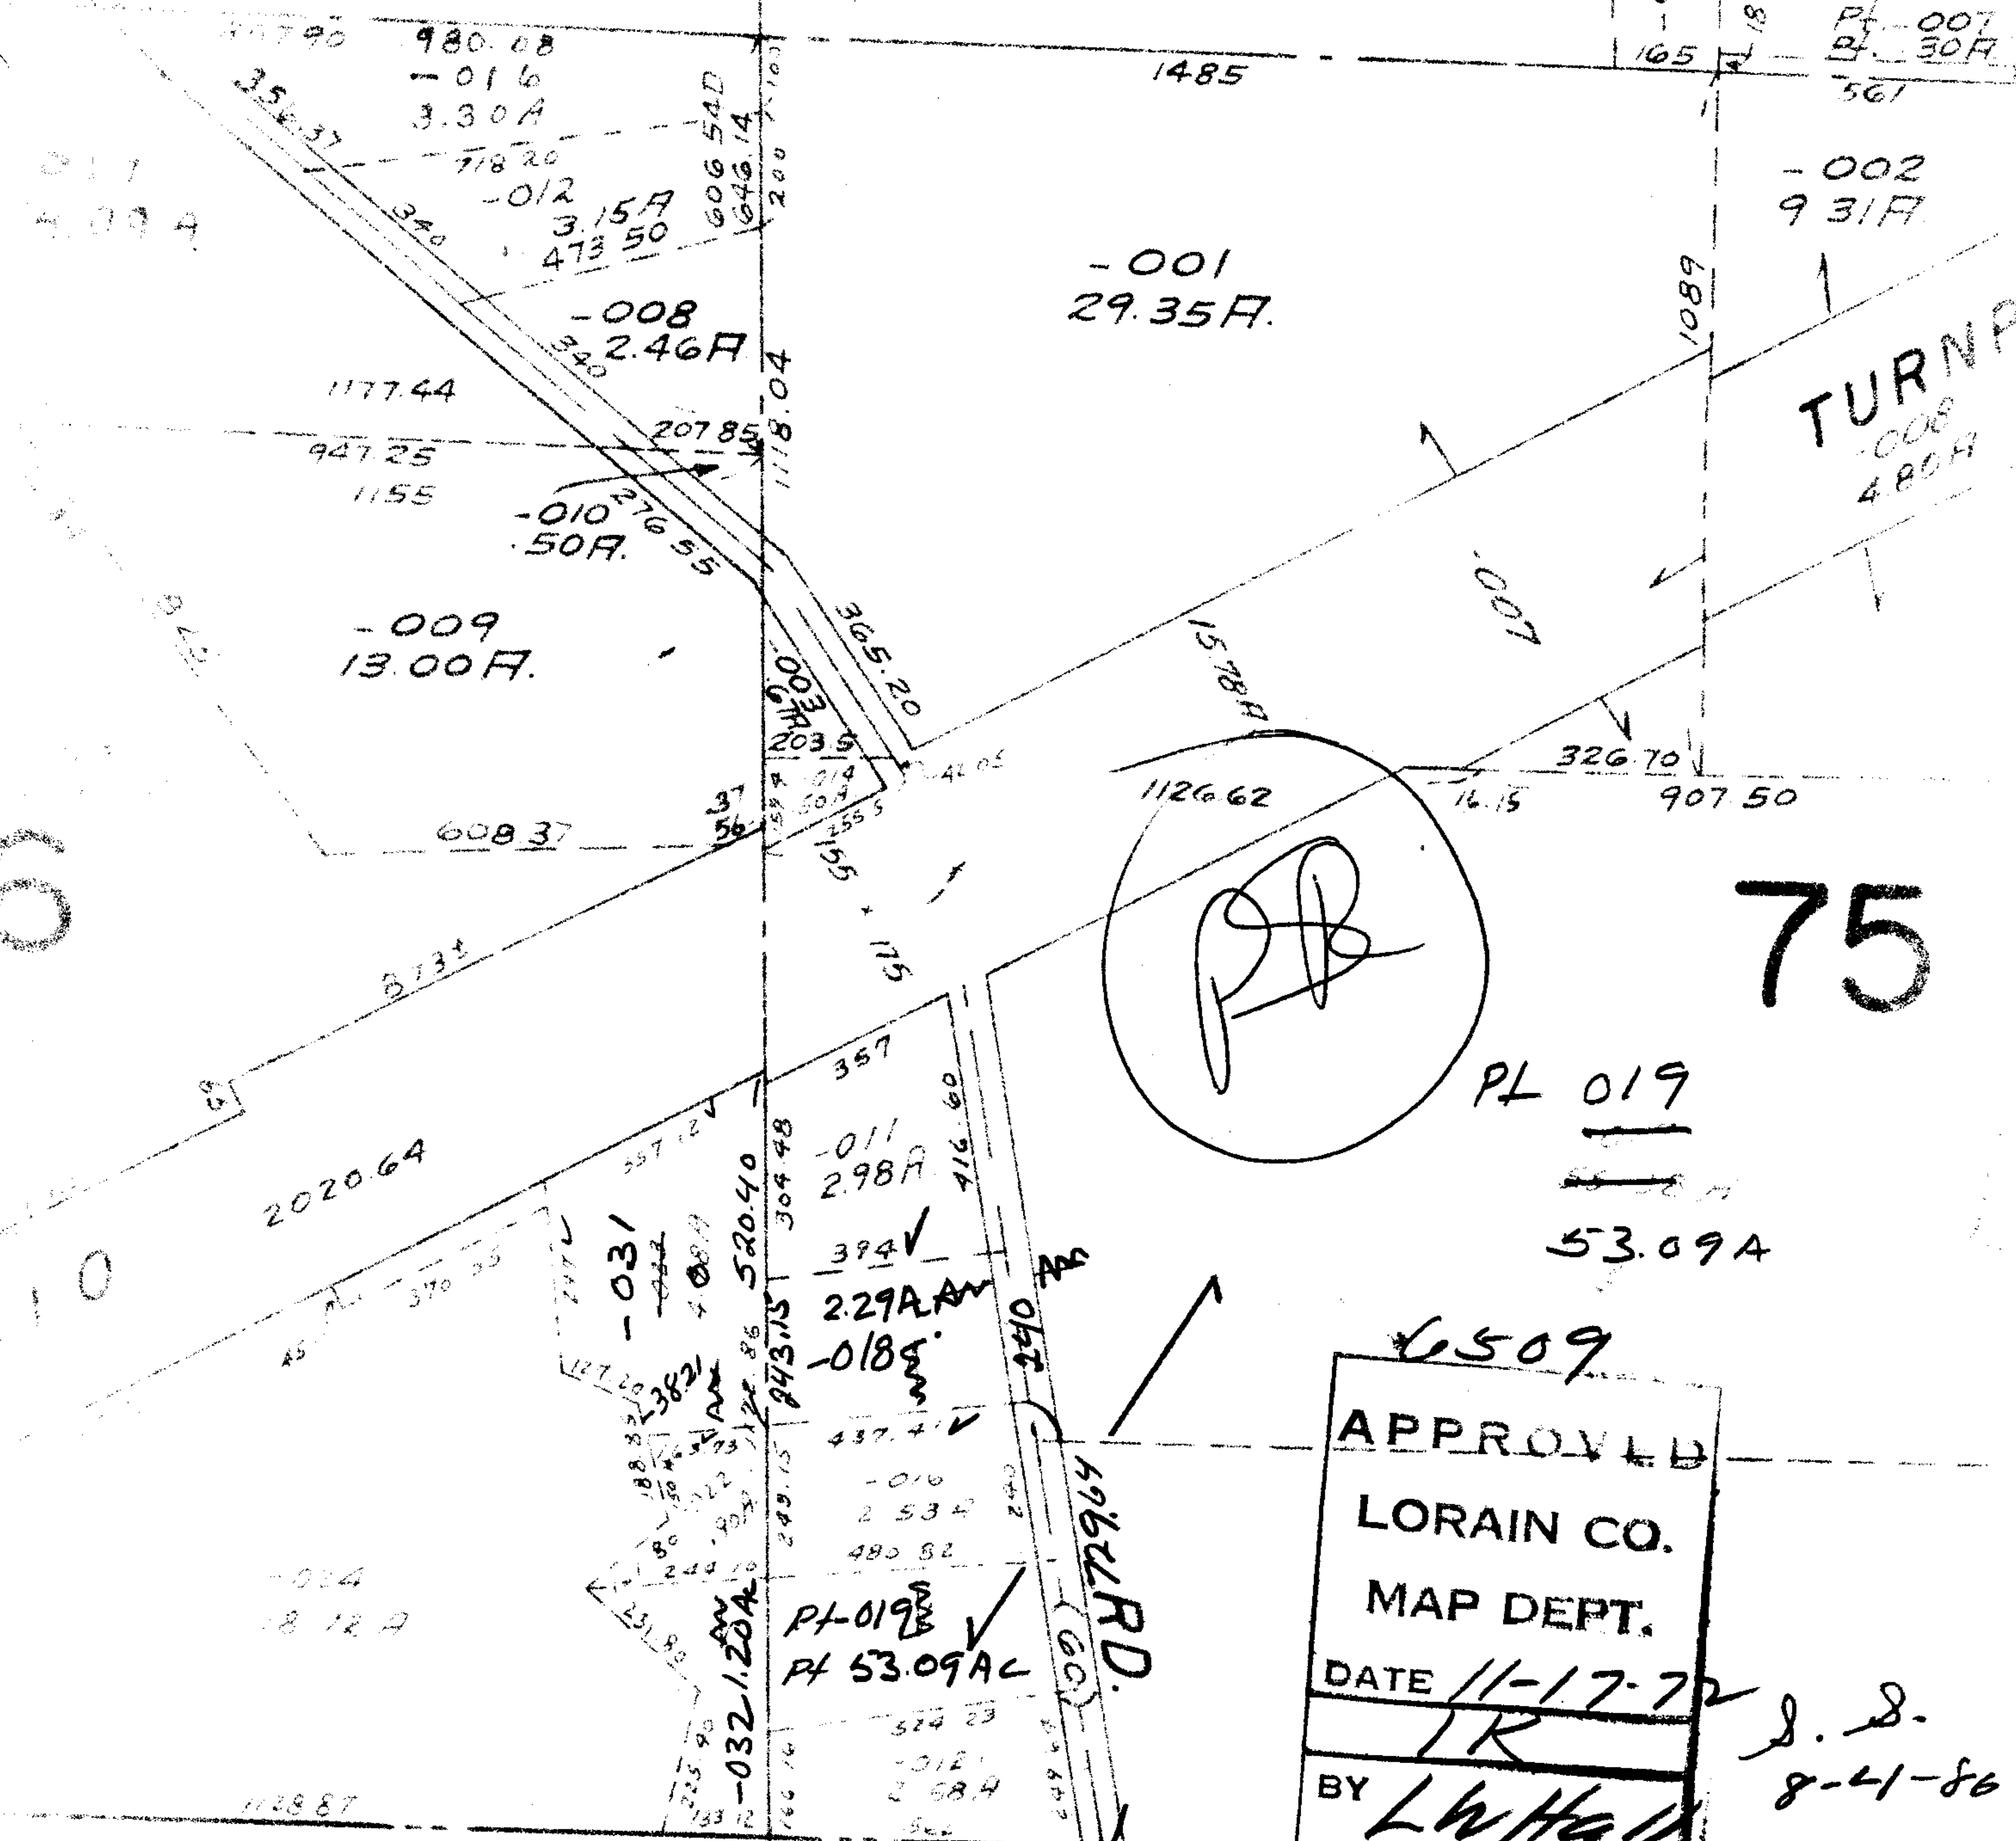

TURNPIKE

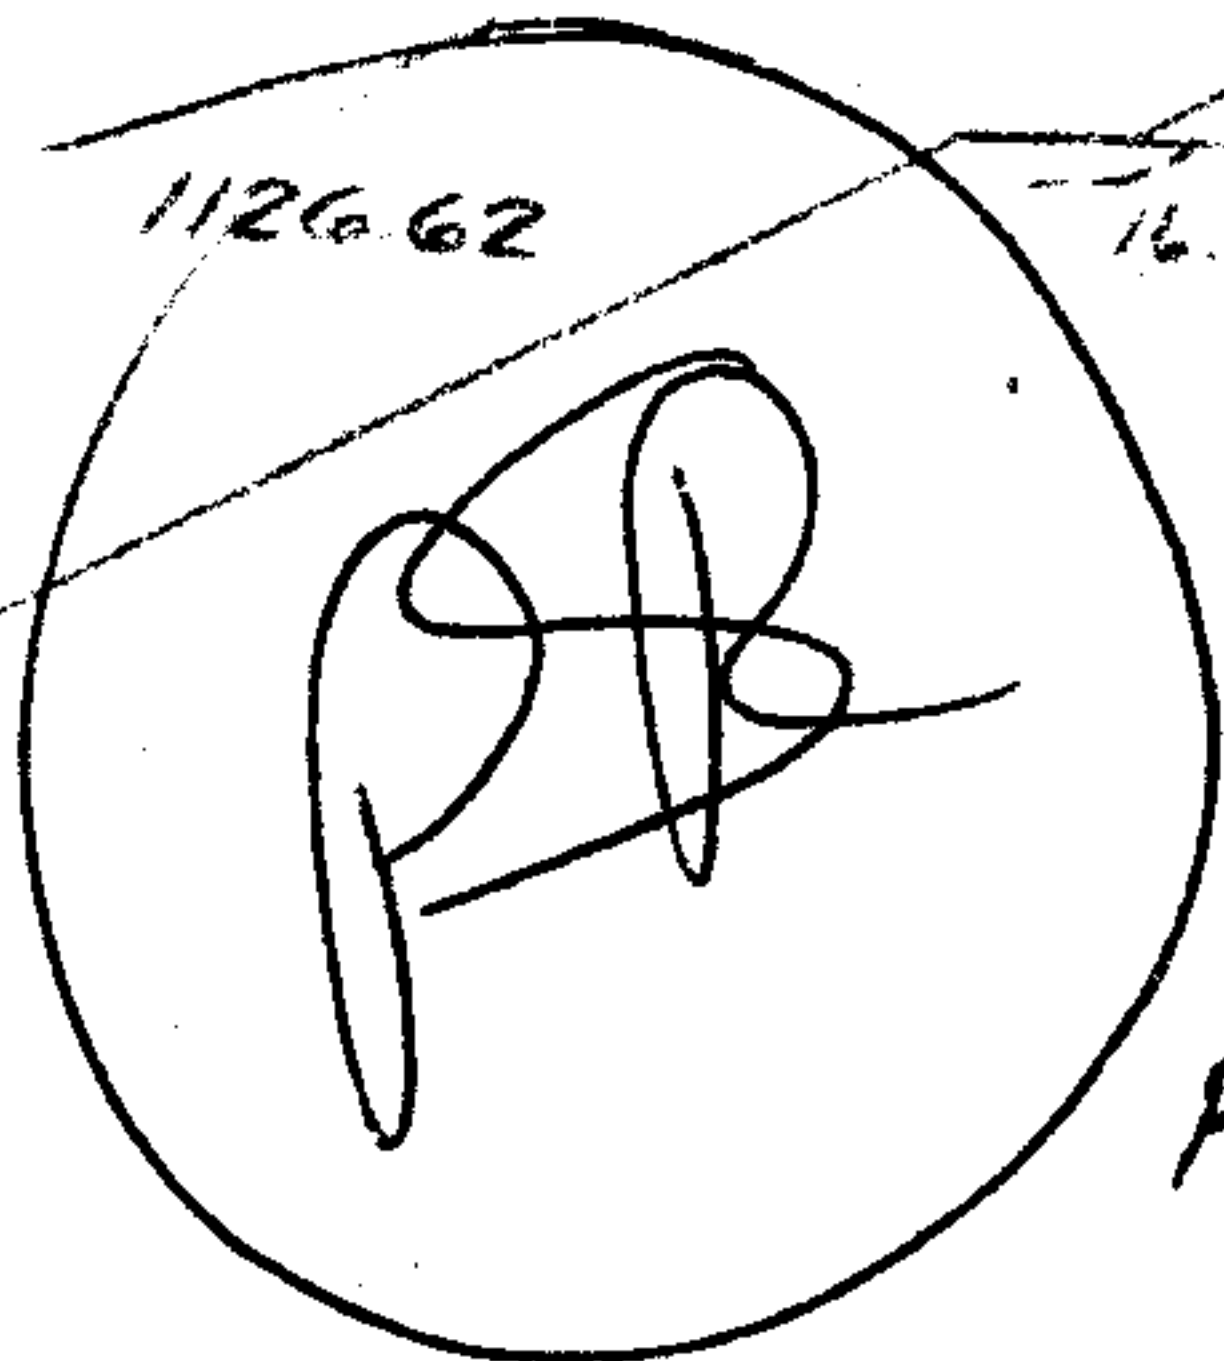

75

PL 019

53.09A

6509

APPROVED
LORAIN CO.
MAP DEPT.
DATE 11-17-72
IK
BY LWHall

J. S.
8-41-86

Trans sheet
checked.
OK

IK

M TWP.

LOTS

5
6