
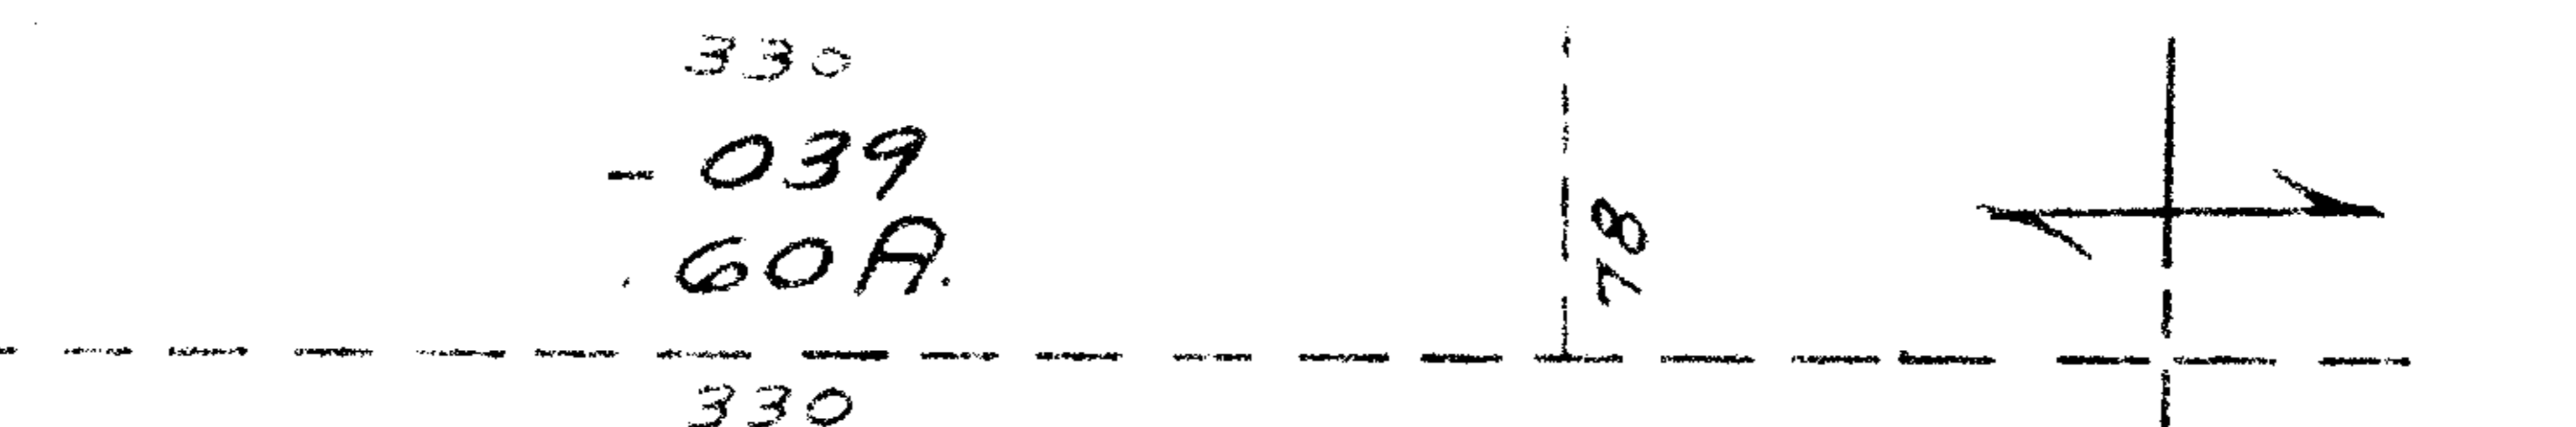


6510

PT 10-00-015-101-005
PT 17 50 A.

117.43
80.08
30.15

INDIAN HOLLOW

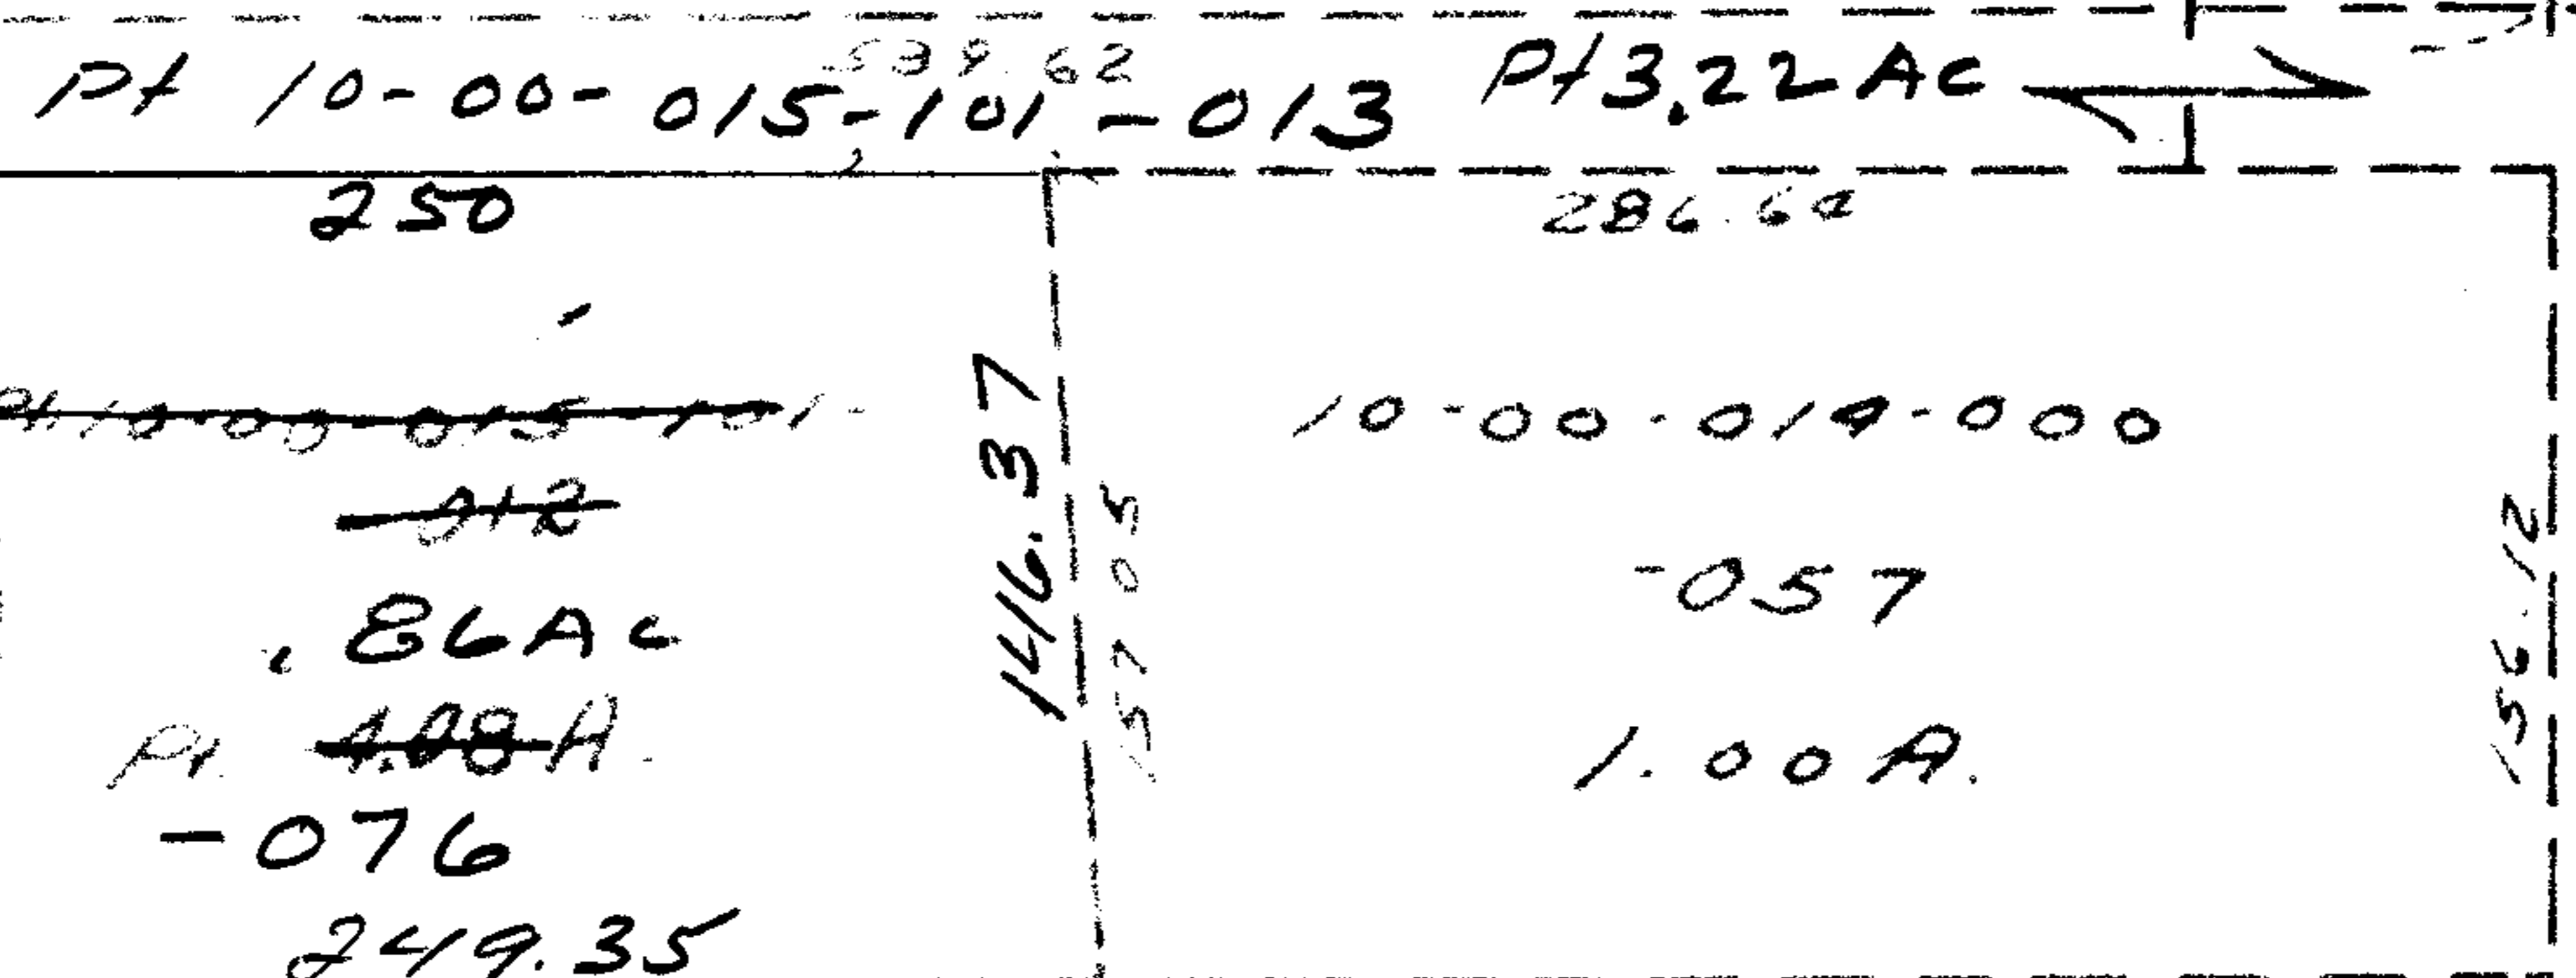

See 10-00-015 A
PT
PT 322
AC
PT 013

6510
 APPROVED
 LORAIN CO.
 MAP DEPT.
 DATE 11-17-72
 10-00-014D
 BY L W Hall

D.S.
7-23-86

From
sheet
OK

1/4 SEC. 14

10-00-014D

10-00-