

6521
SEE 11-D

82


ELYRIA — TWINSBURG

55

50

RD.

355

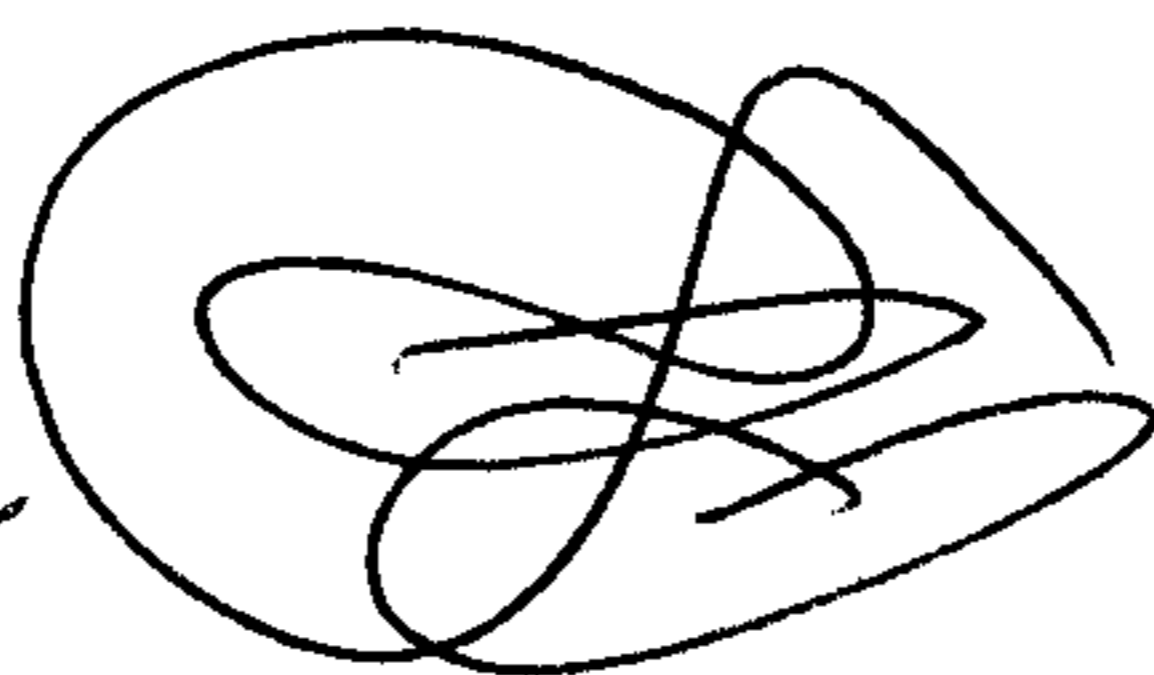

~~-023~~

-036

~~11.74 A.~~

11.24 Ac.

435.60

-035

.50 Ac.

50

435.6

6521



APPROVED

LORAIN CO. 3.00 A.

MAP DEPT.

DATE 11-21-72

11-00-016-A

BY

[Signature]

D. S.

7-23-86

435.

435.60

-022

1.50 A.

435.60

11-00-016A

300

300

150

150