


SEE 5-D

6-19

6524

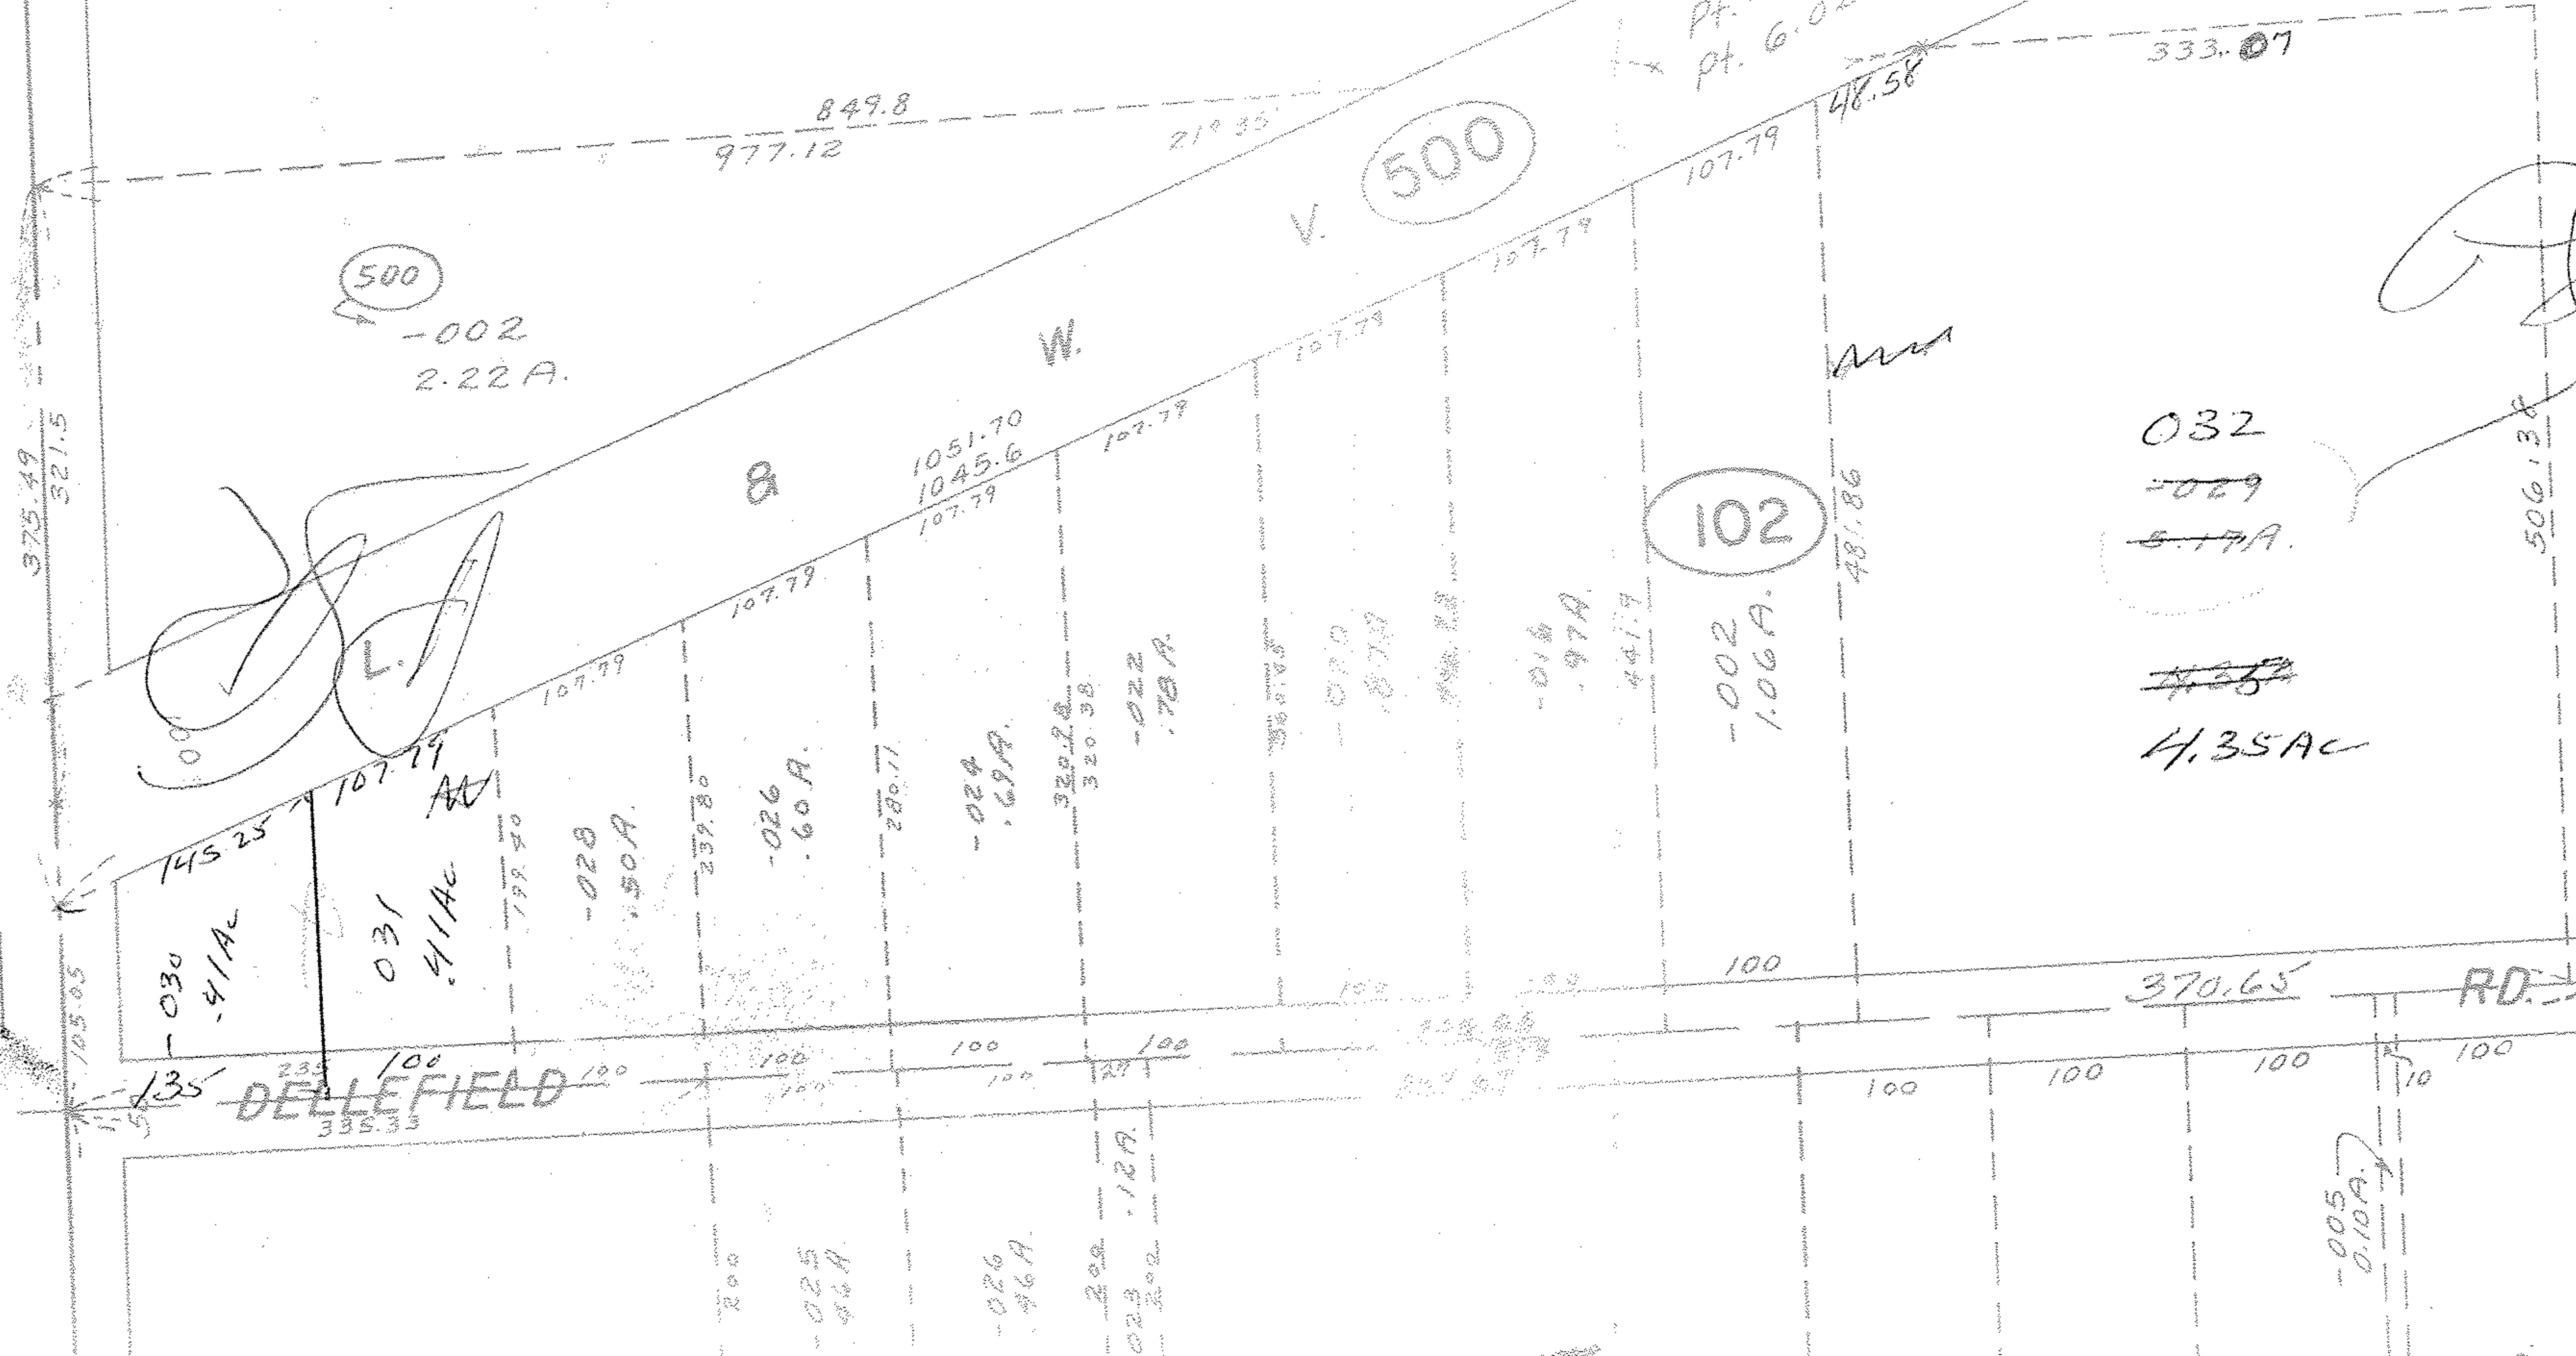

6-524  
 APPROVED  
 LORAIN CO.  
 MAP DEPT.  
 DATE 11-27-72  
 Co-19  
 BY L.W. Hall

6524