


OHIO

759.96

6551



SEE 7-00-022-D

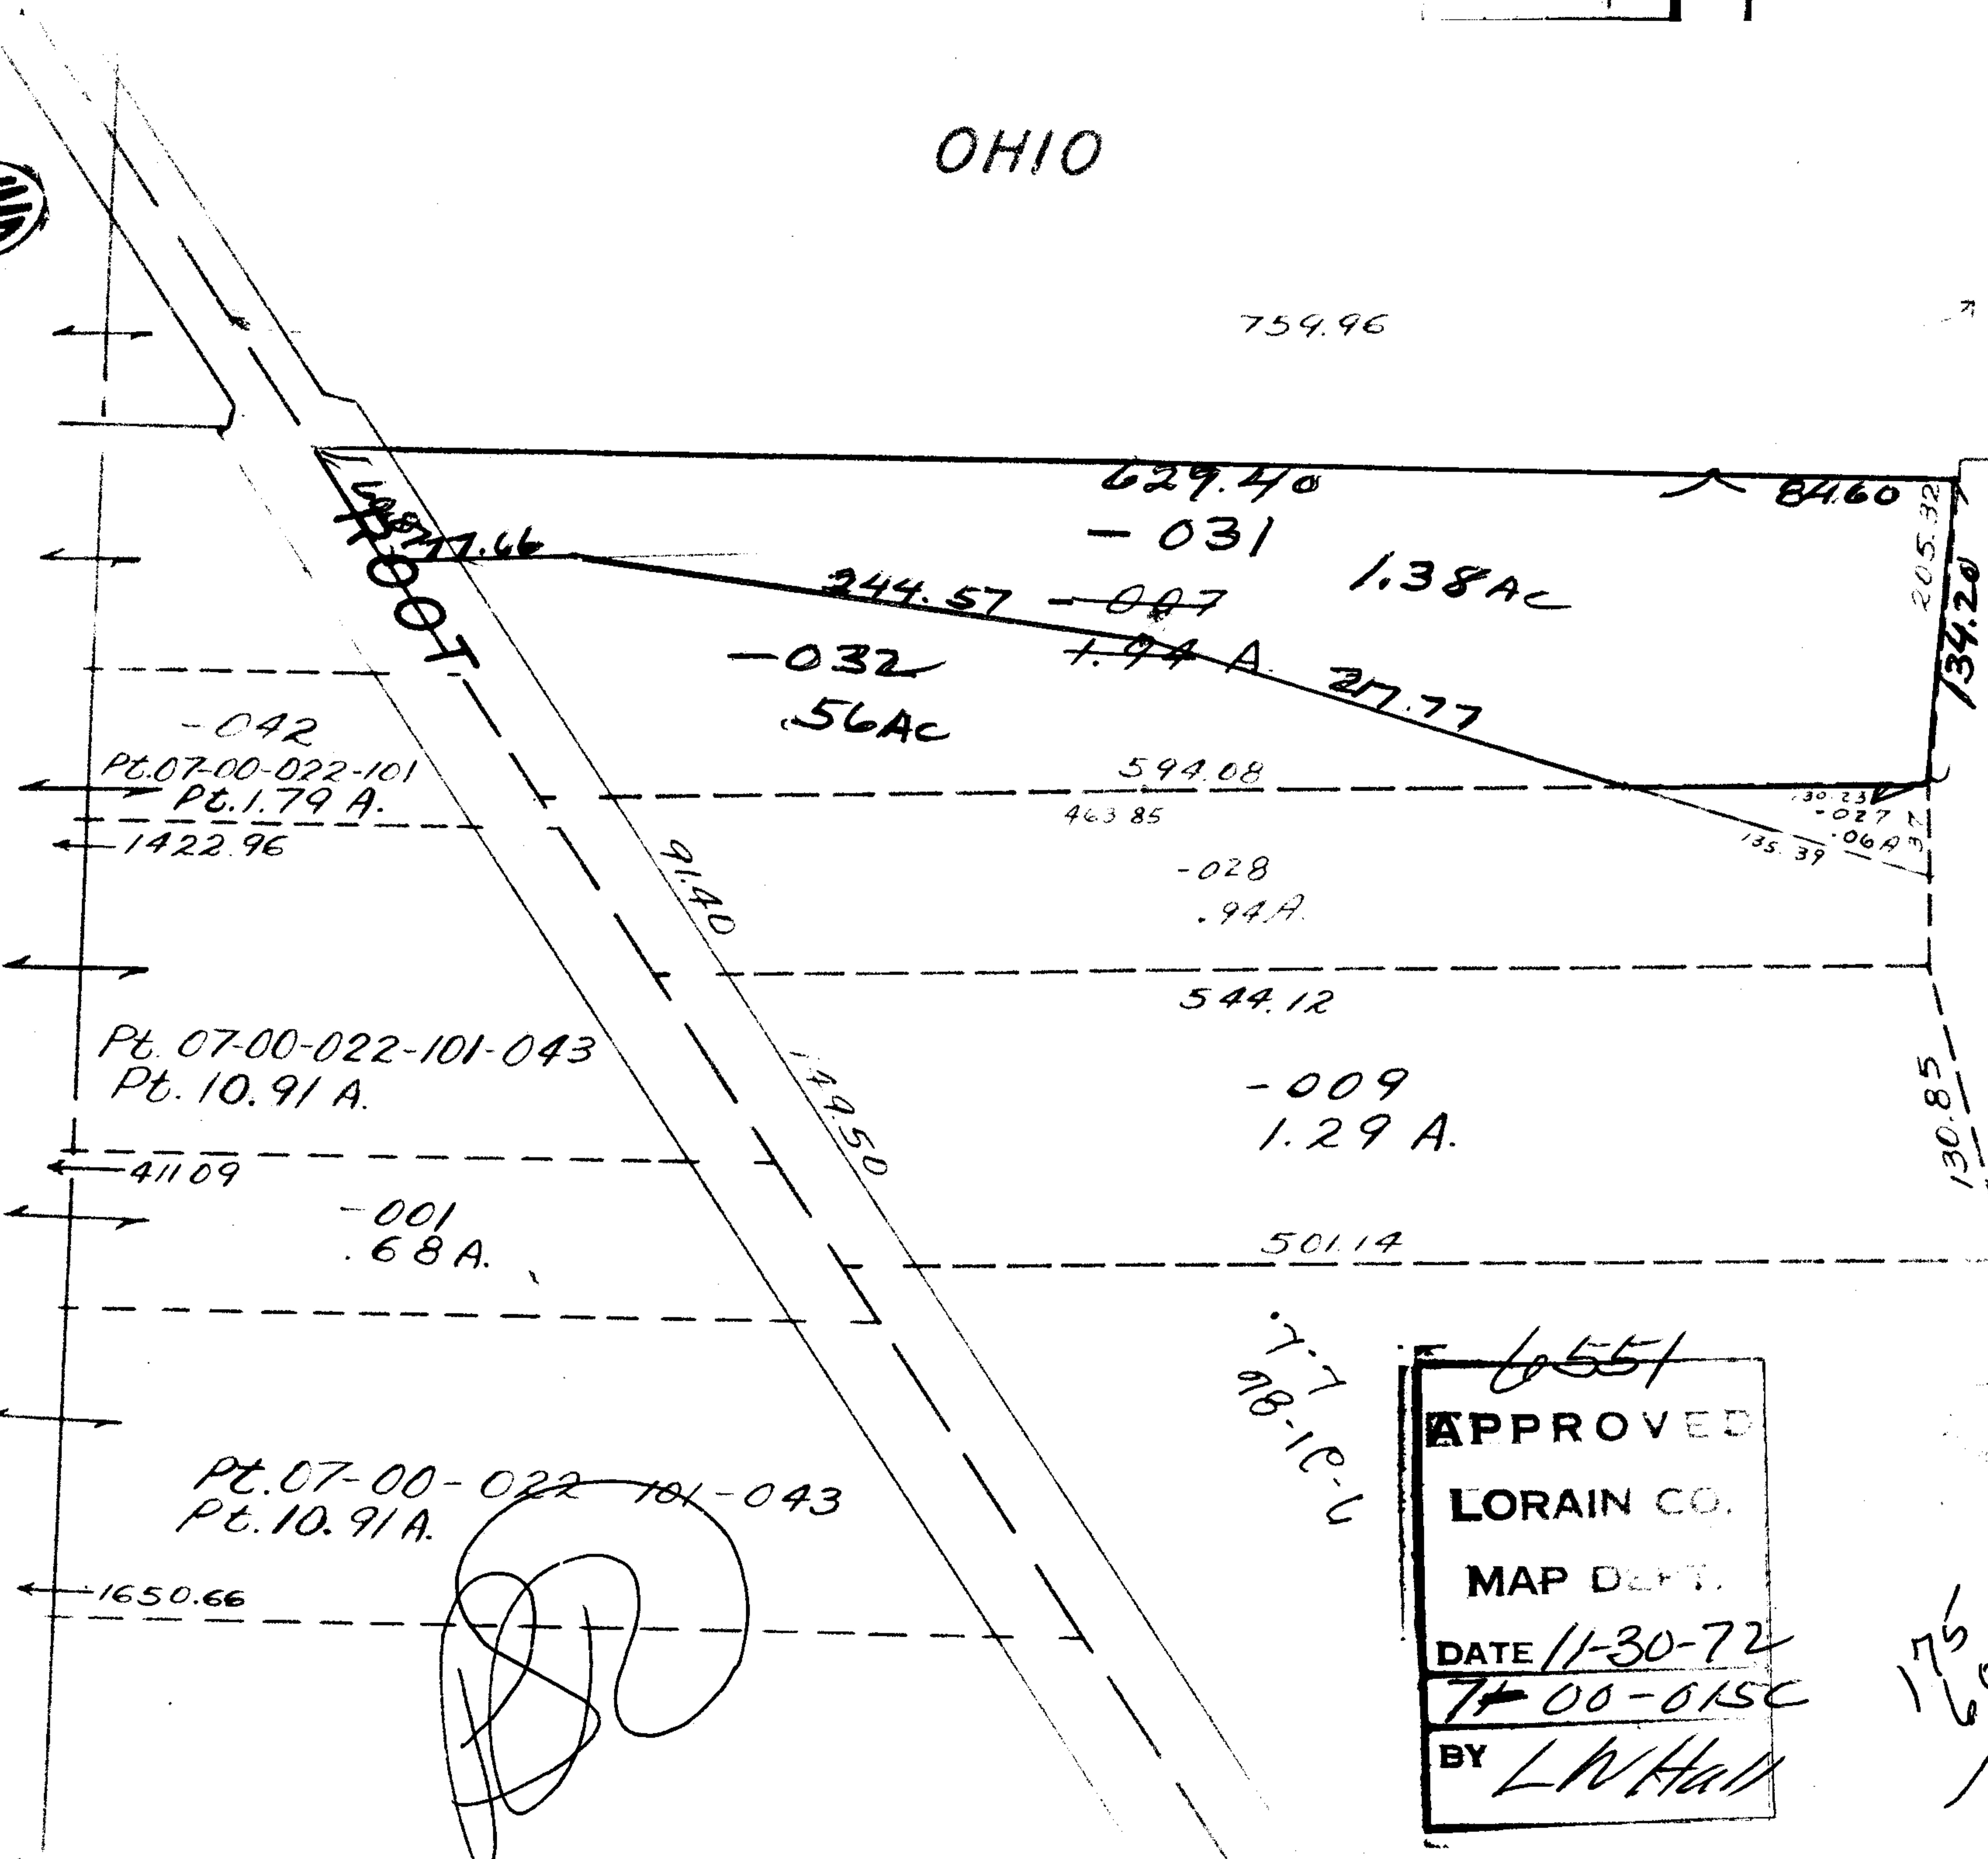

07-00-015C

6551
 APPROVED
 LORAIN CO.
 MAP DEPT.
 DATE 11-30-72
 7-00-015C
 BY LWHall

175
 60.87
 114.13

7.7
98-10-6