


Ce 580




Pt. = 012
~~Pt. 4522A~~

-099
45.13 AC

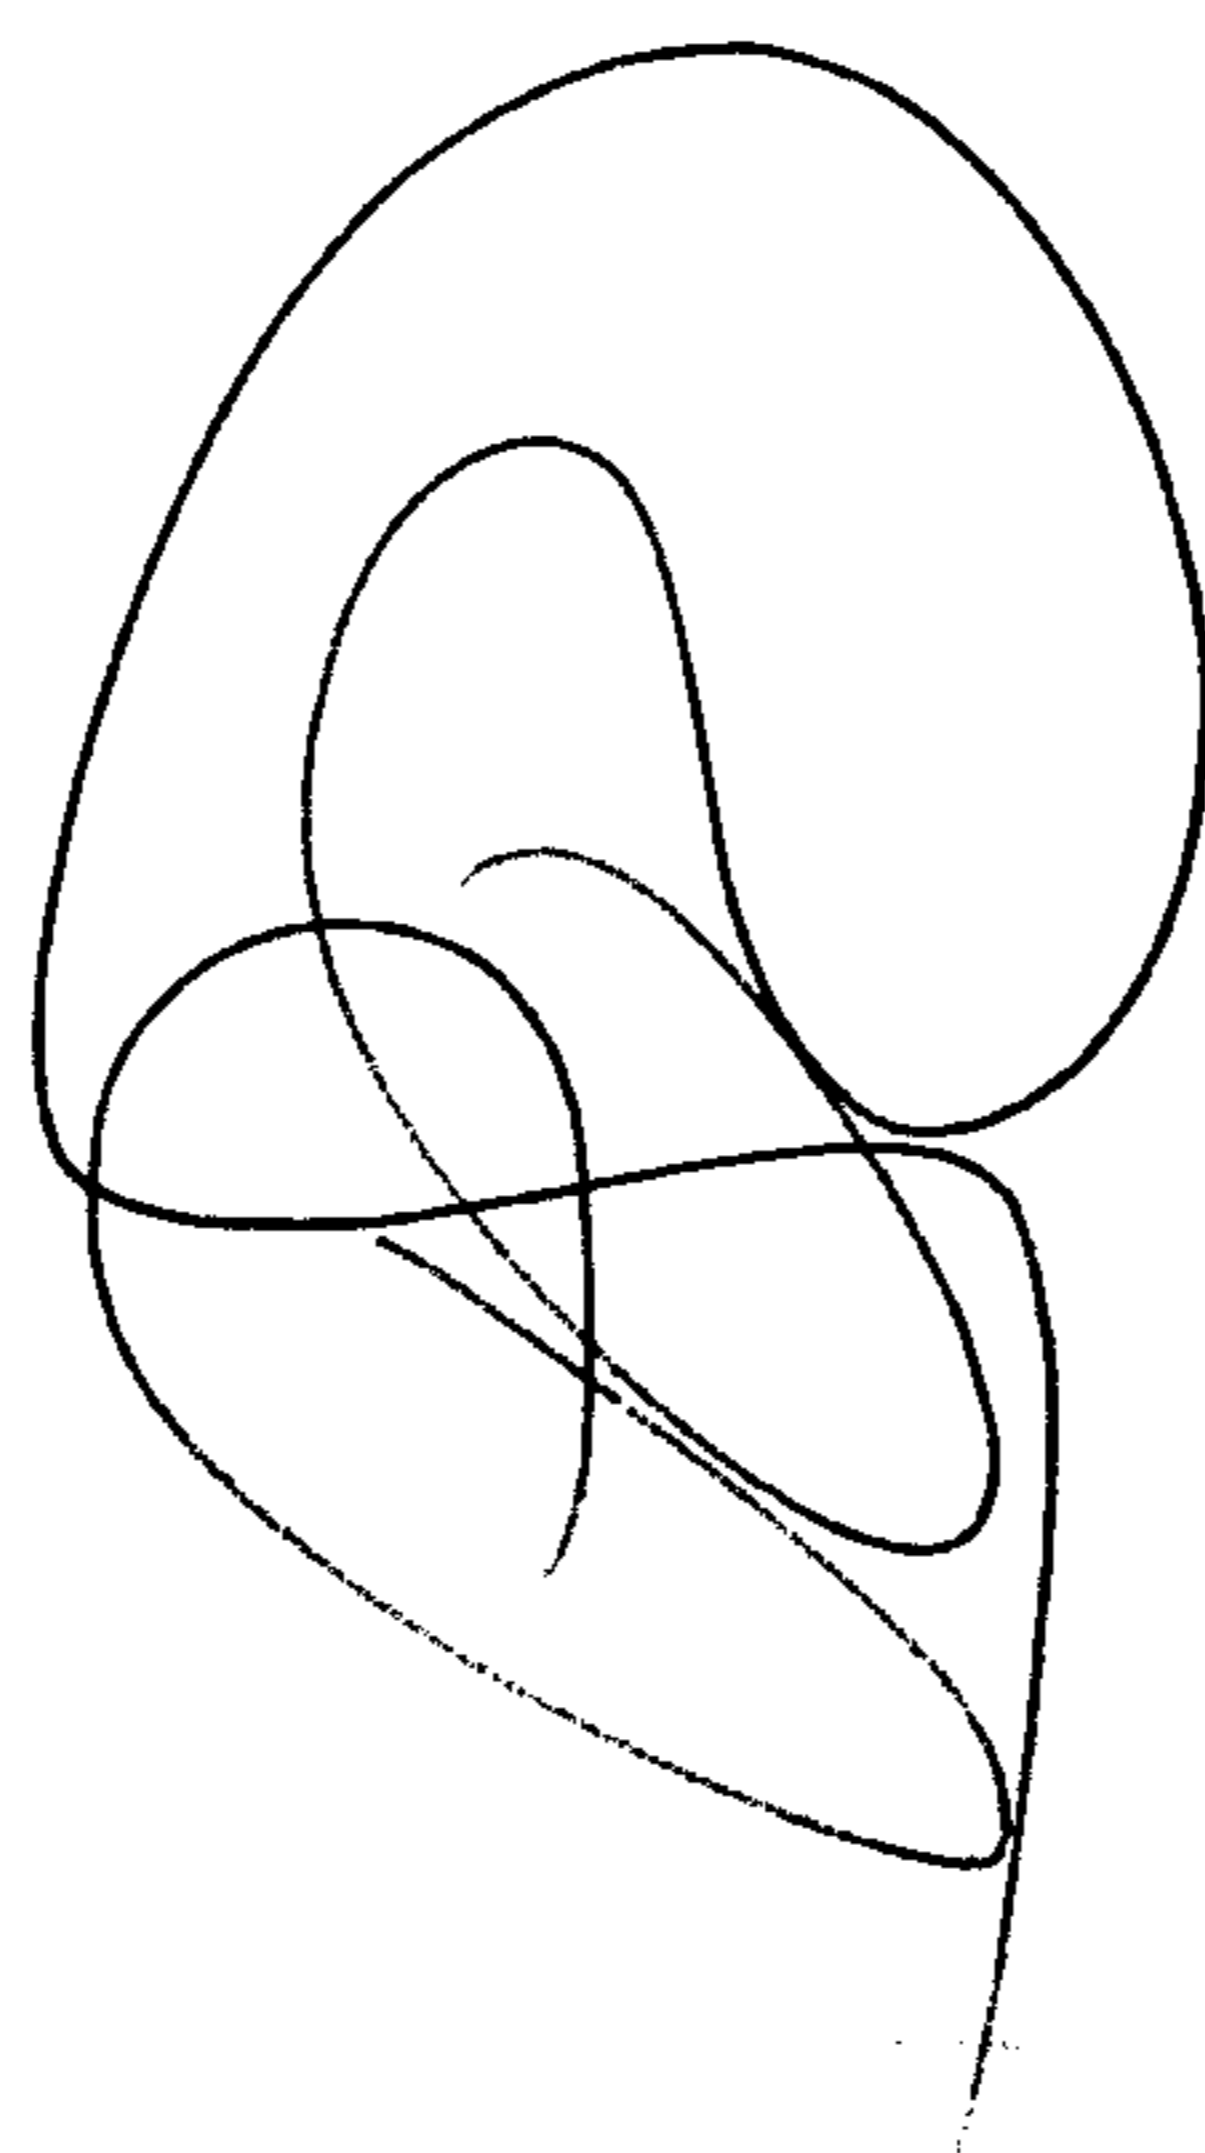

SEE 7-9

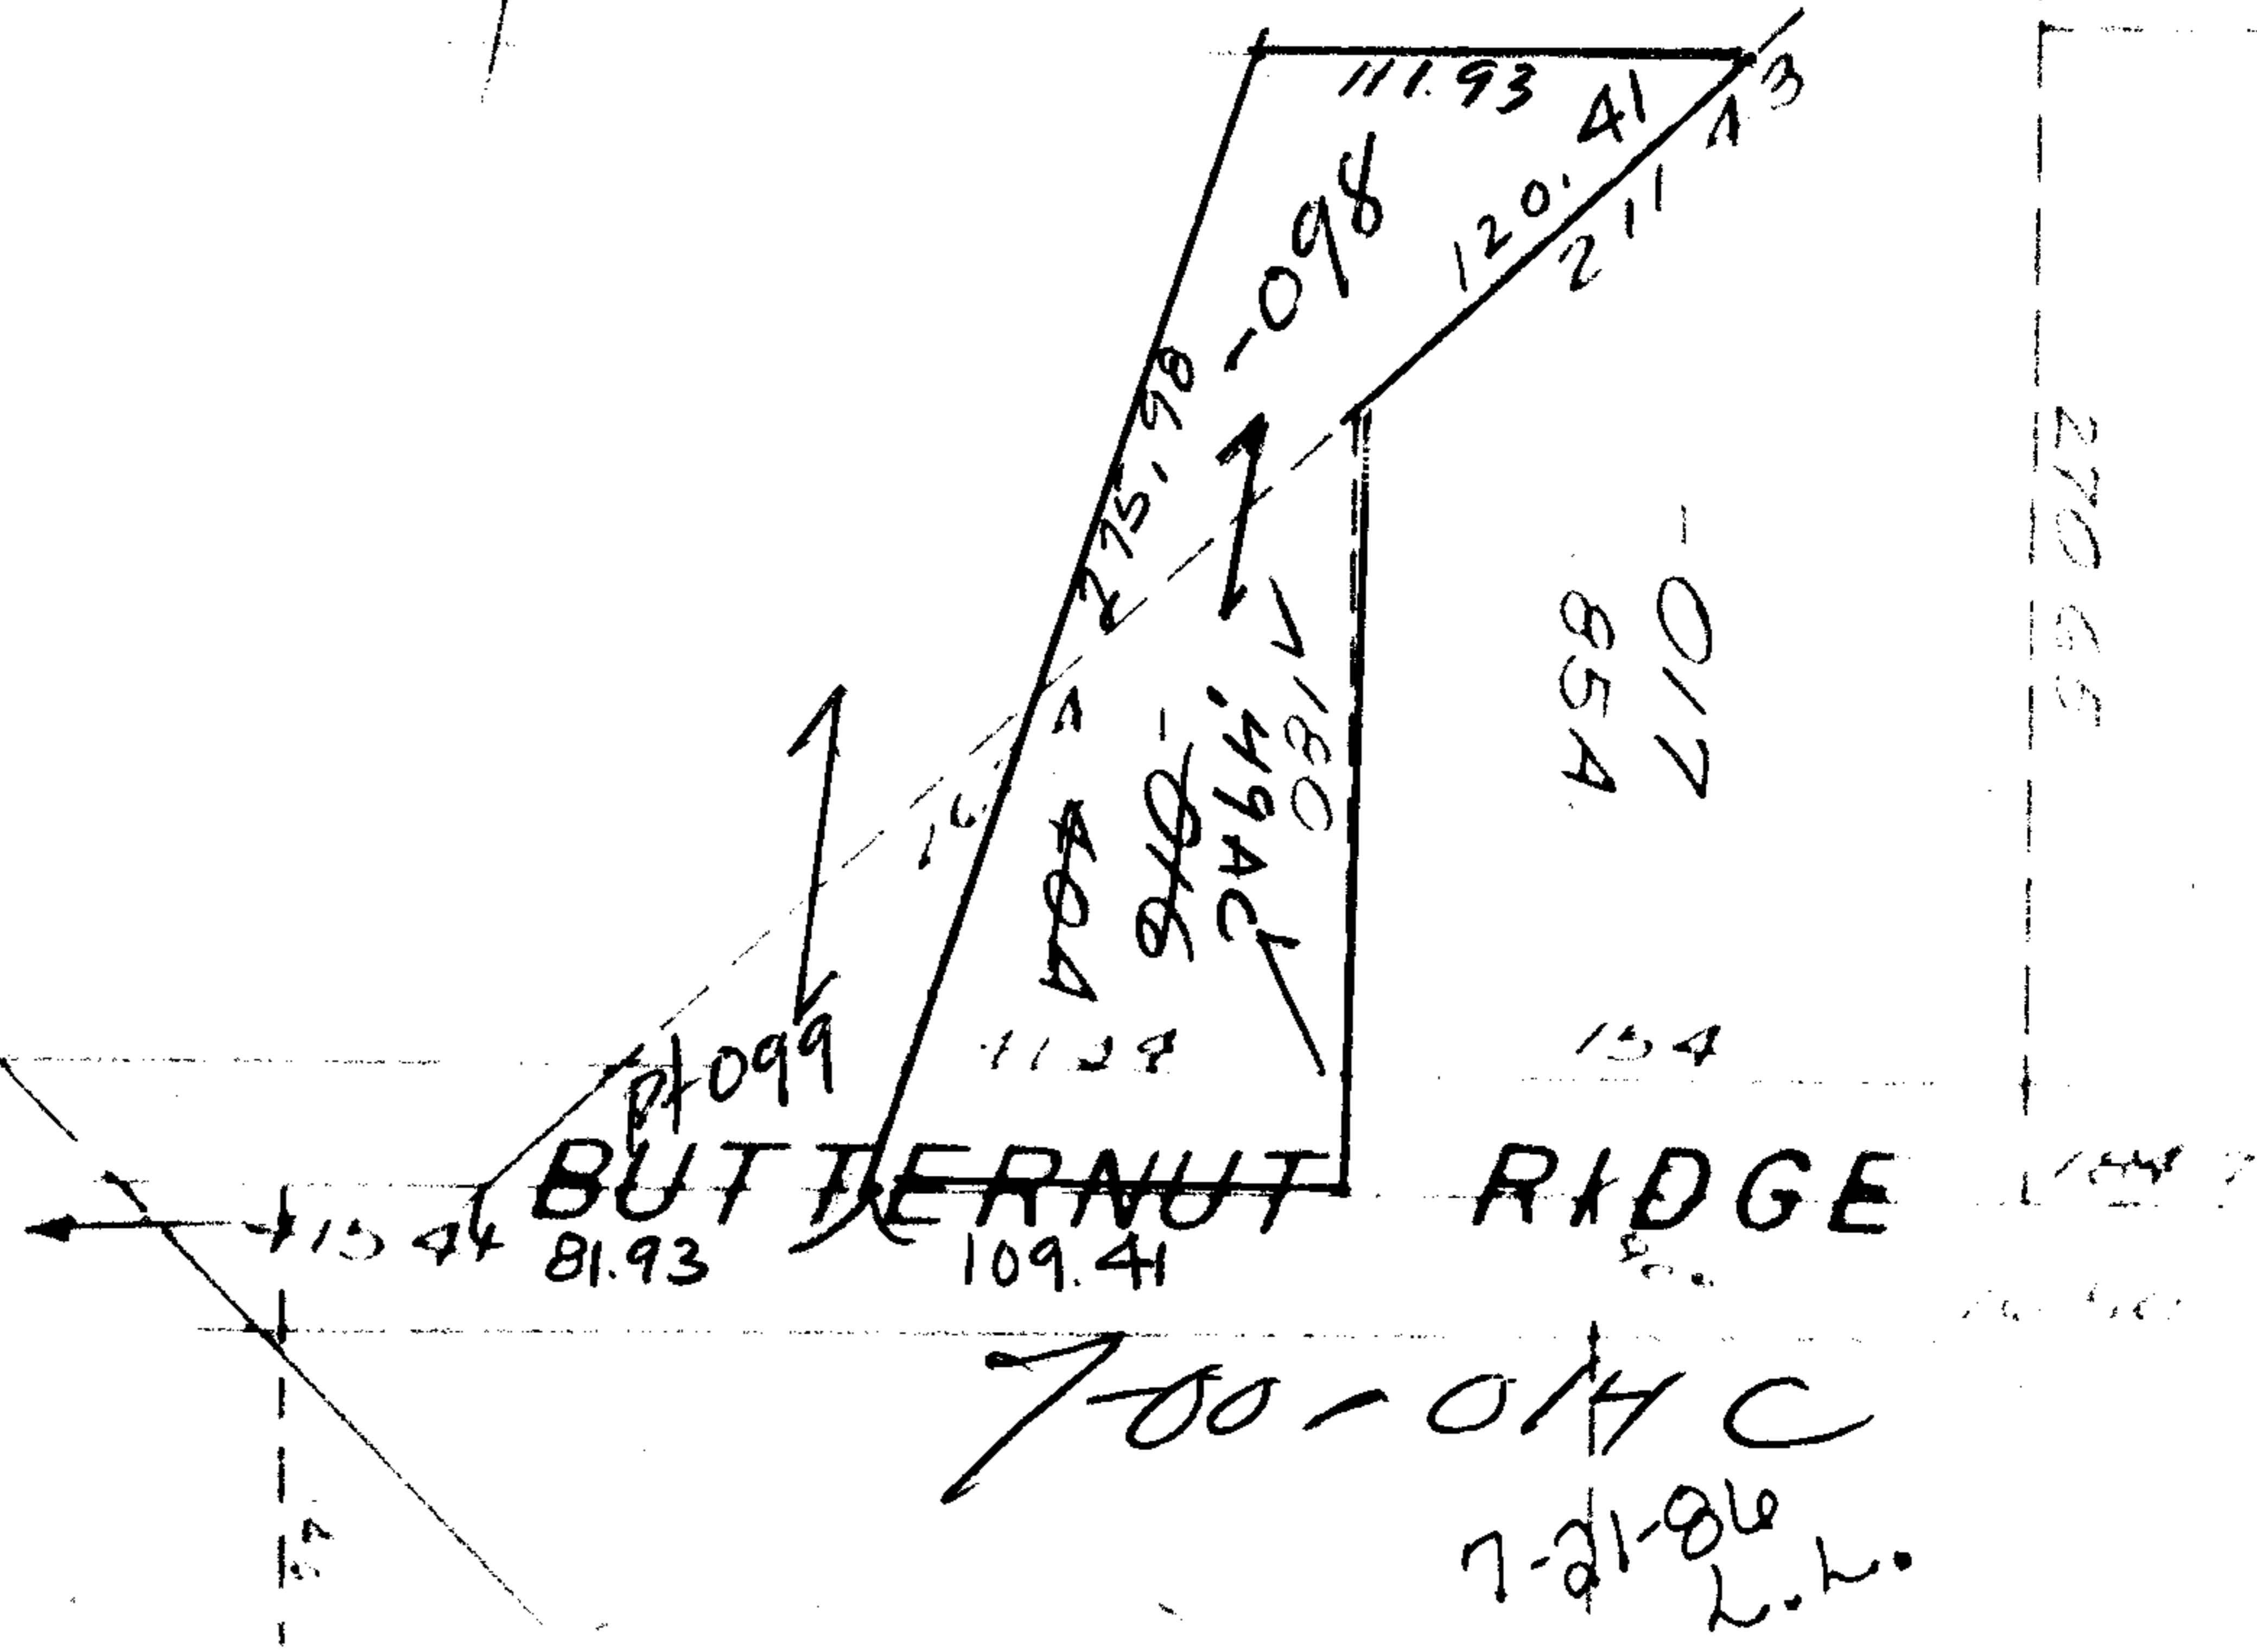

270.65