


6582

12-6

EMMONS

-001 5.24A  
-002 3.93A

-004 2.43A  
-005 2.95A

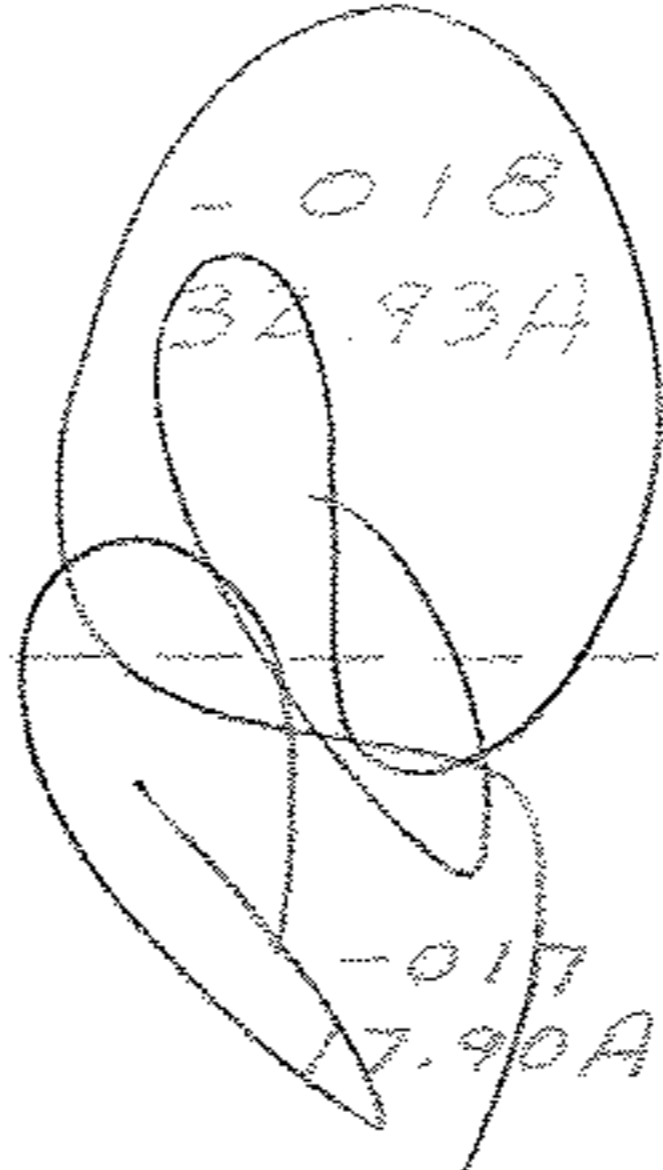

-006 18.58A

-010 5.11A

32

-007 14.28A

-020 1.64A  
-025 5.00AC  
-027 2.51AC  
-028 2.50AC  
-020 2.50AC

029 ✓  
~~026~~  
~~024~~  
~~015~~  
32.30A  
31.51  
26.51  
37.89AC  
35.39

6582  
APPROVED  
LORAIN CO.  
MAP DEPT.  
DATE 12-13-72  
126  
BY L. H. Hall

-008 3.60A

027 ✓ 2.51AC

028 ✓ 2.50AC

020 2.50AC

021 ✓  
~~004~~  
17.04A  
14.54

-017 51.51A

-016 3.70A

-012 5.00A

-013 3.35A

-003 9.27A

-015 51.73A

-007 8.77A

252

SCALE 1" = 400'

LOTS 2