

~~18-00-021-B~~  
6591


SEE 18-00-021-B 6591

-064

pt.  
pt.


1285

2741

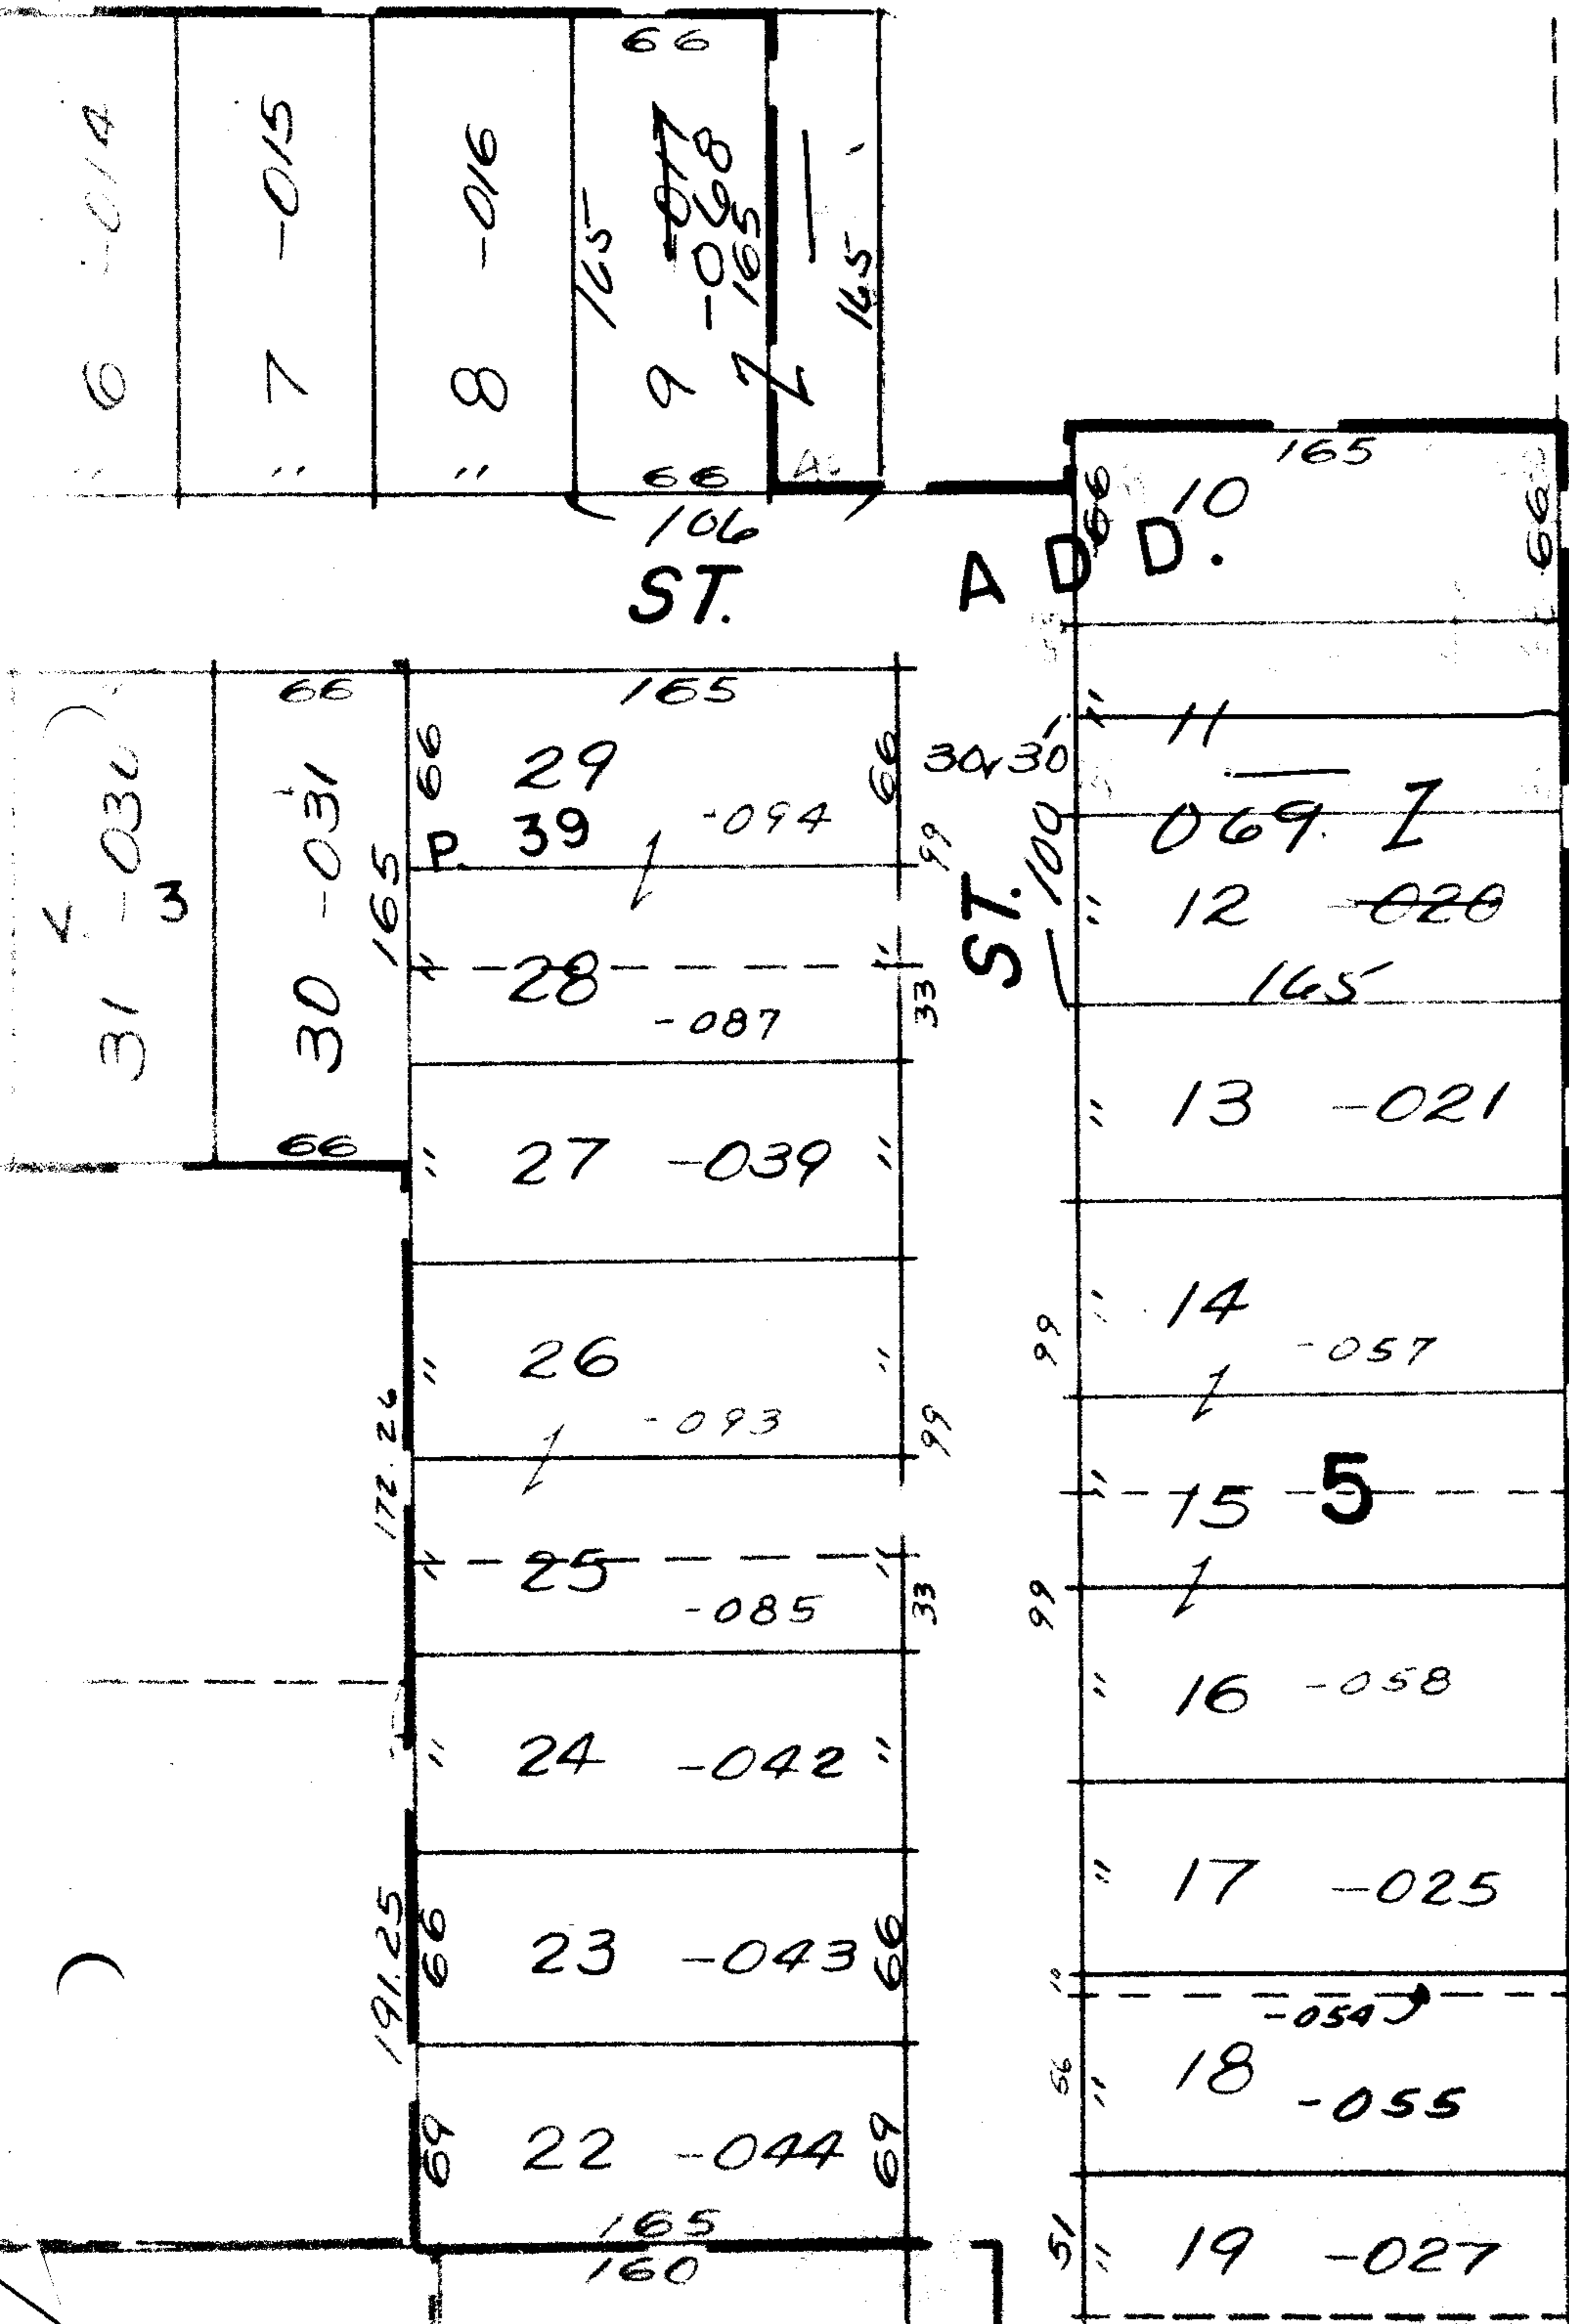

6591  
 APPROVED  
 LORAIN CO.  
 MAP DEPT.  
 DATE 12-14-72  
 18-00-021 D  
 BY L W Hall

D. S.  
 7-28-88  
 Pt. -039  
 Pt. 25.30A

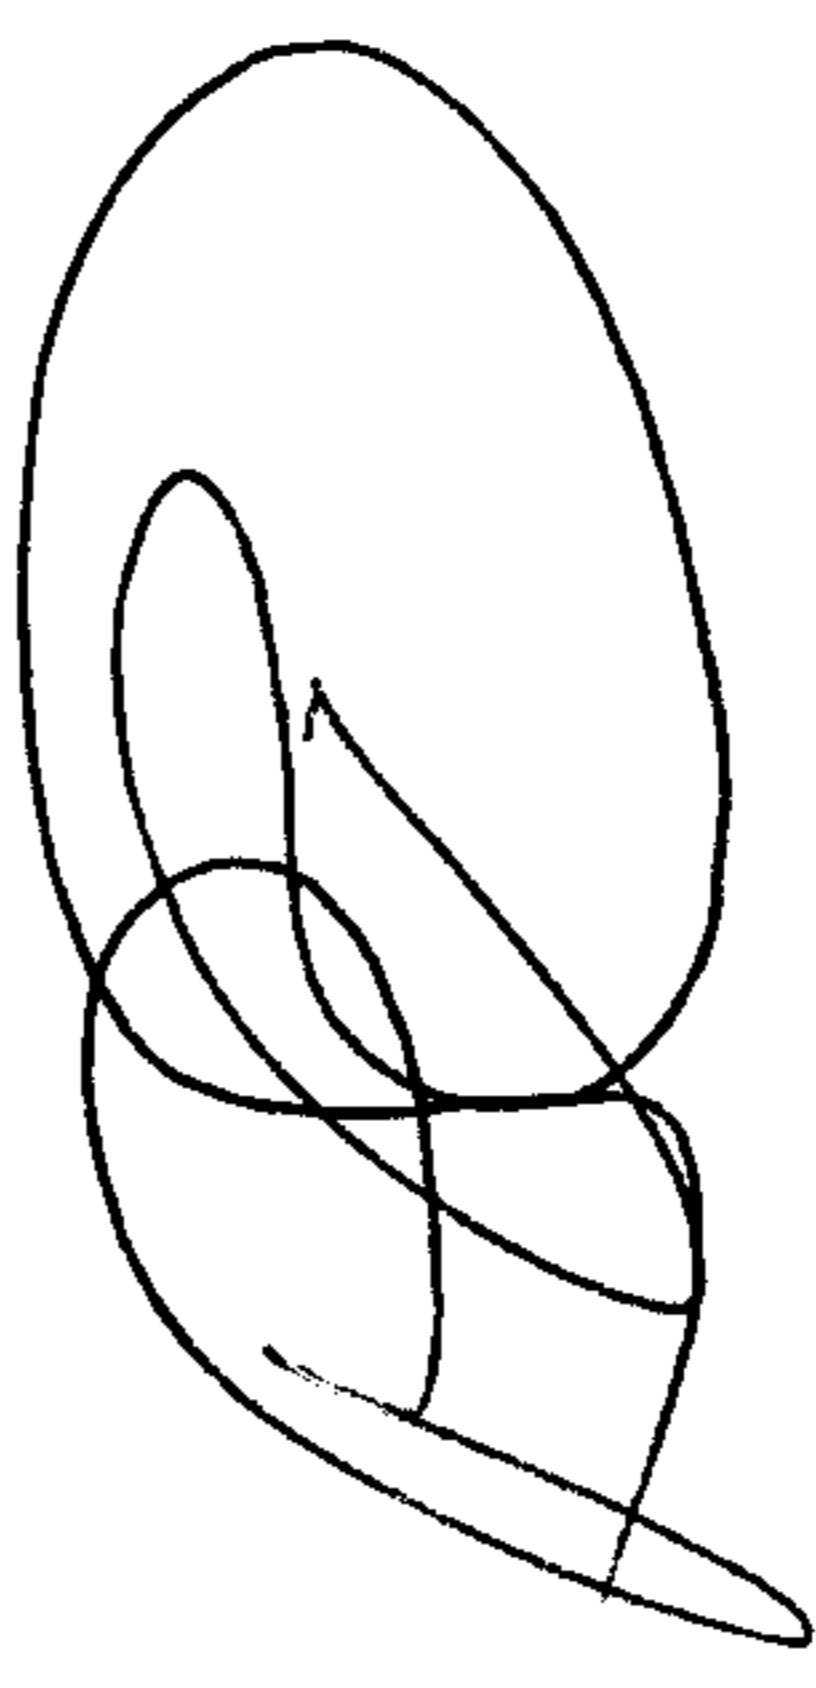

18-00-021 D