



6594

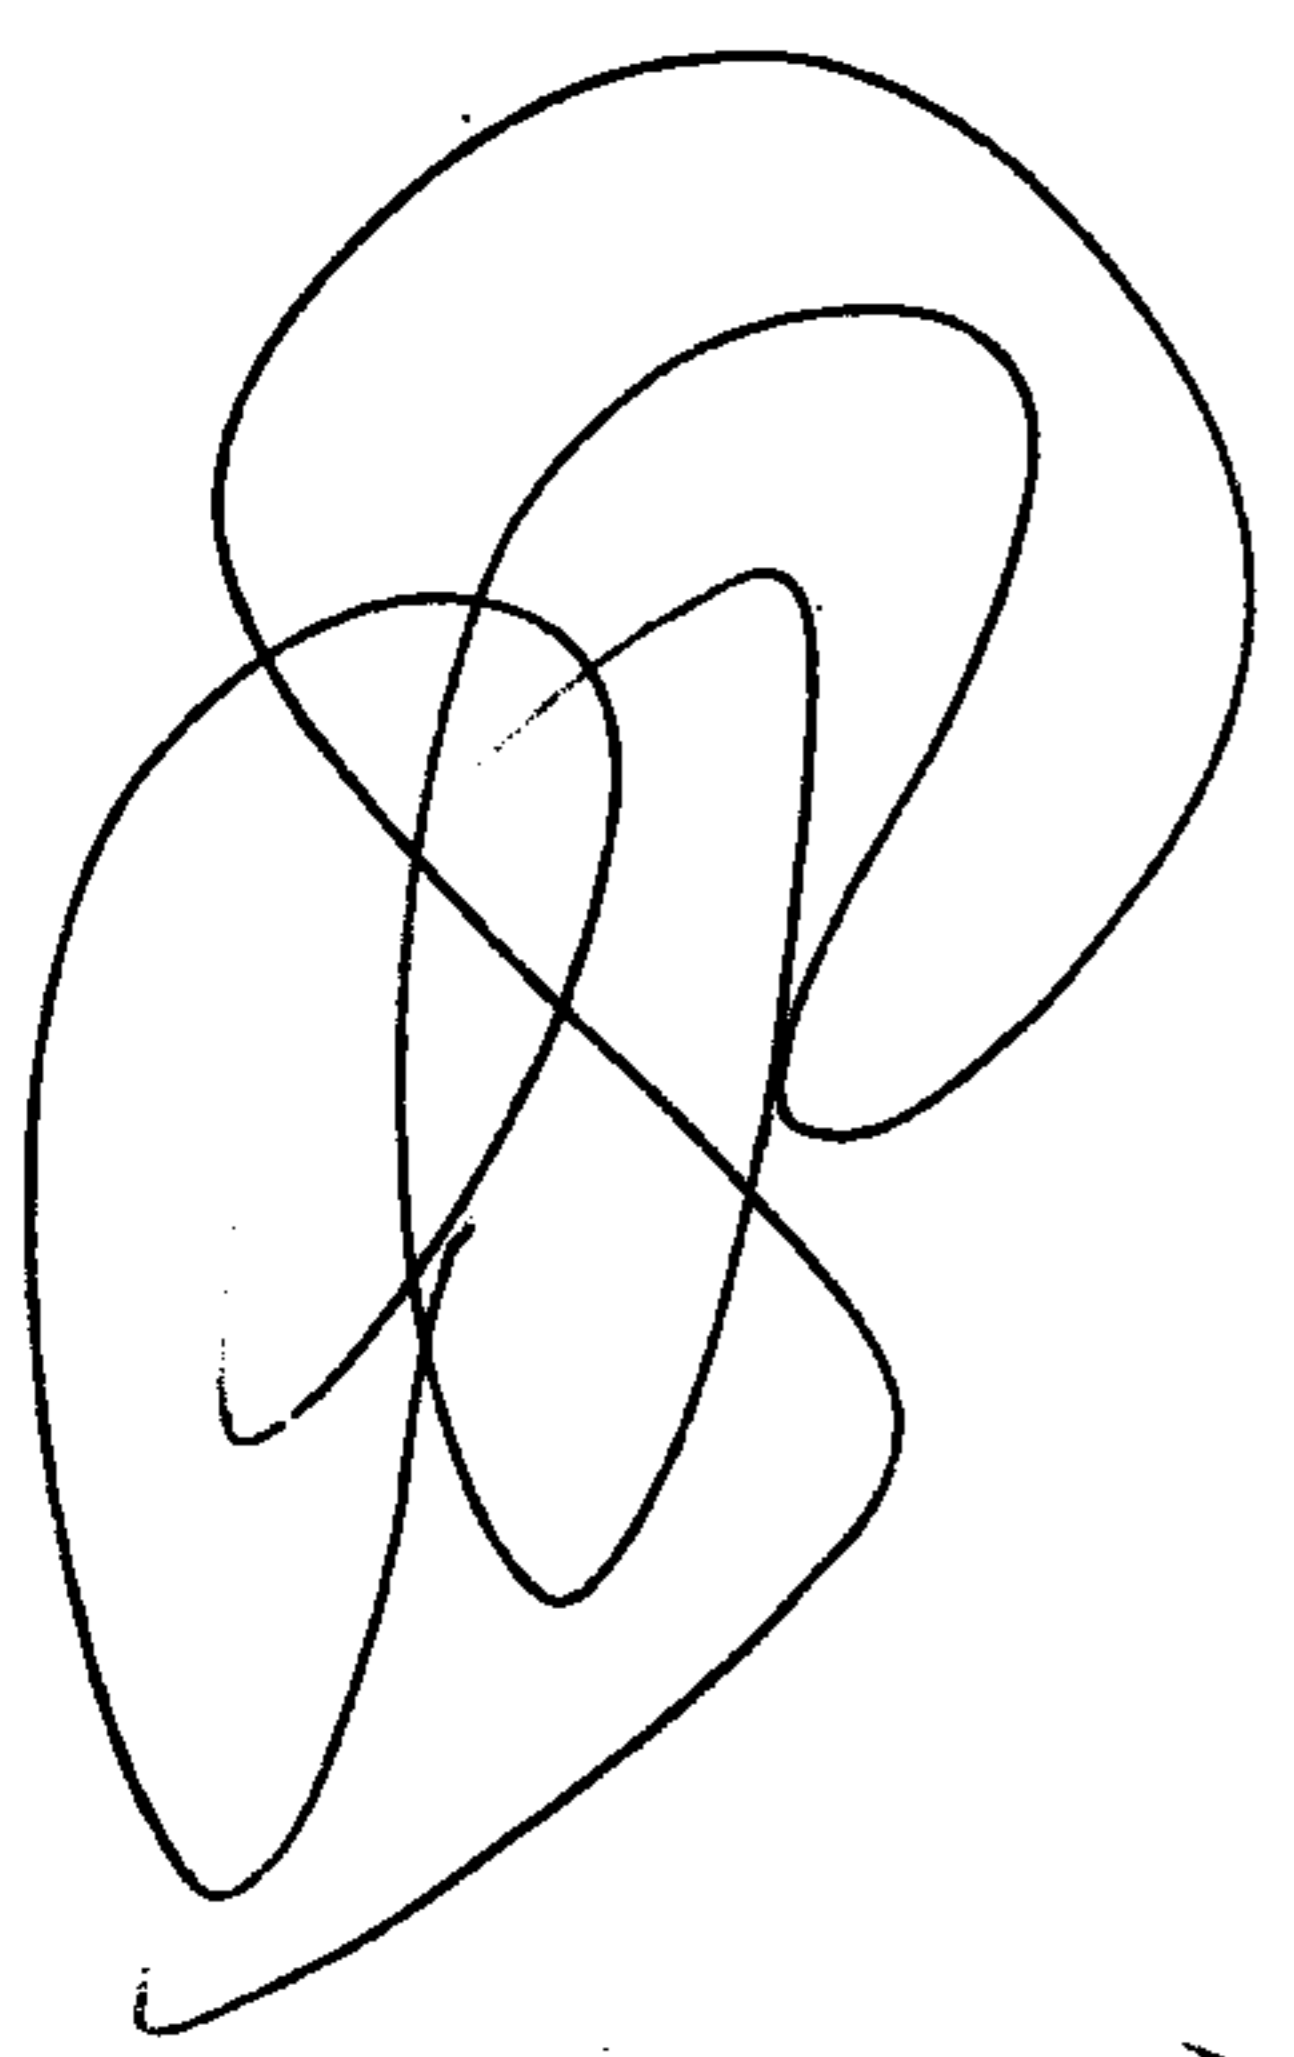

APPROVED
 LORAIN CO.
 MAP DEPT.
 DATE 12-14-72
 6-34
 BY L.V. Hall

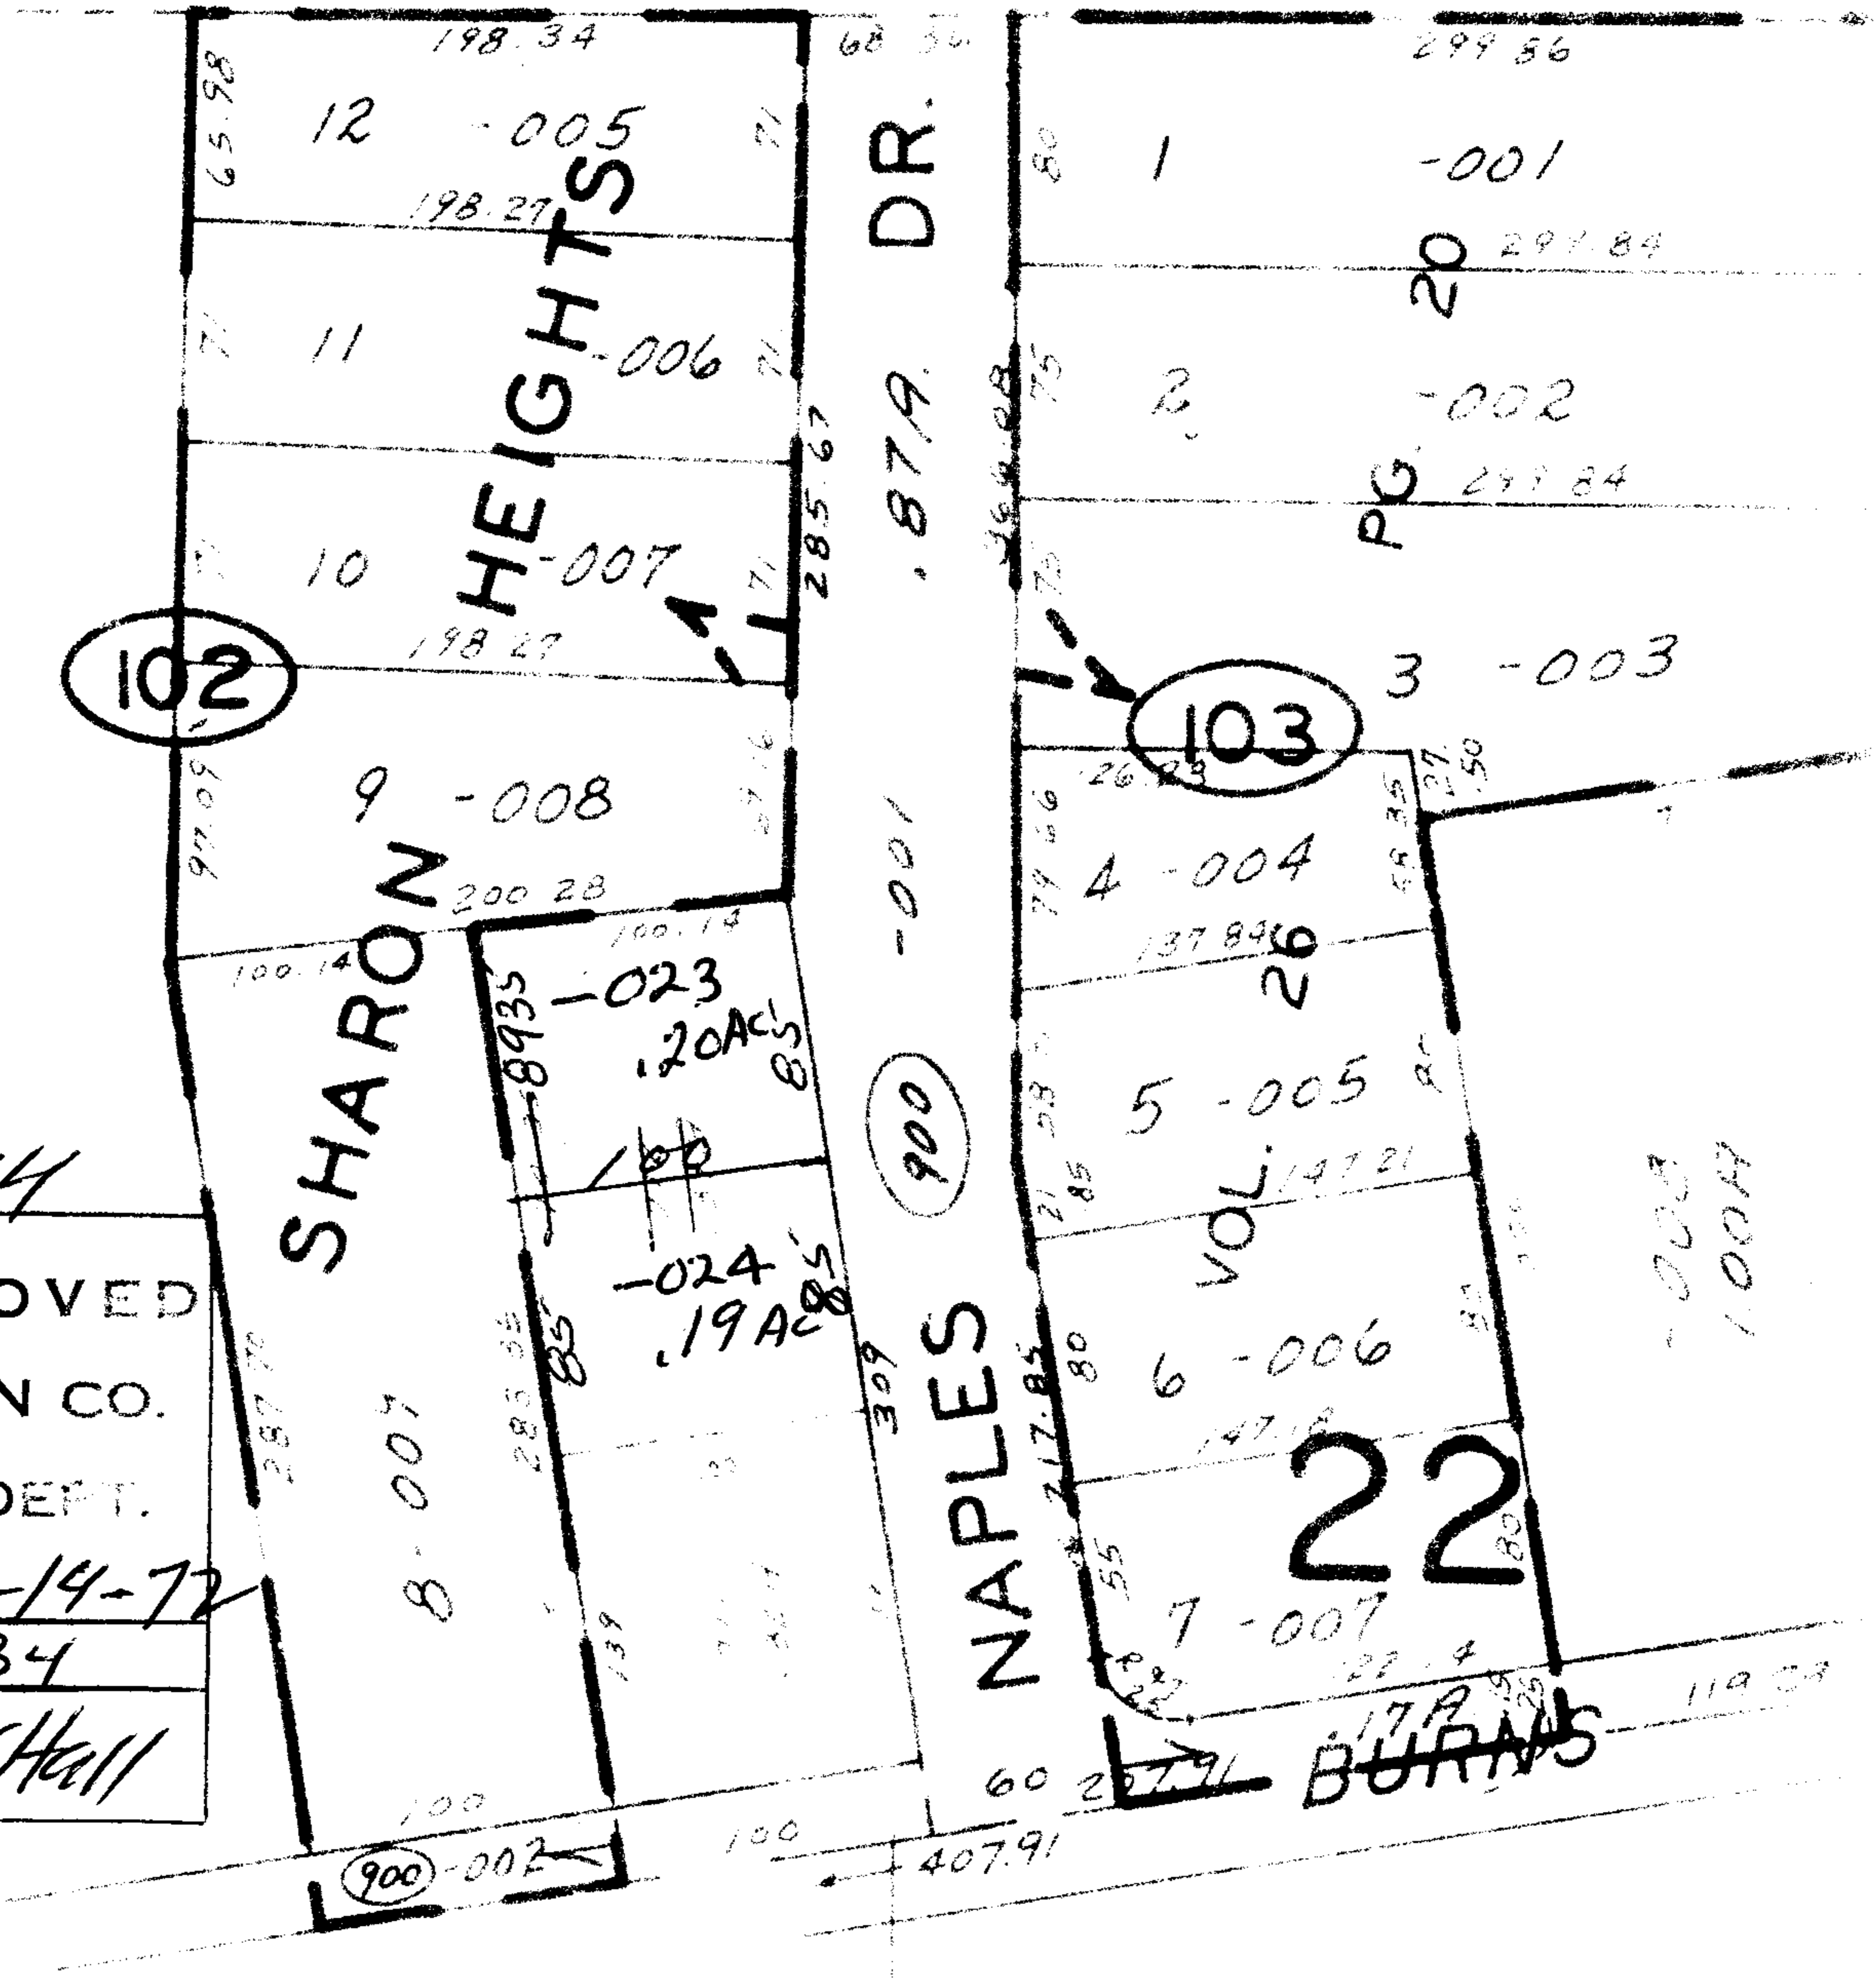

Pt. 001
Pt. 5.00A