


6600

APPROVED
 LORAIN CO.
 MAP DEPT.
 DATE 12-15-72
 6-100
 LNH/11

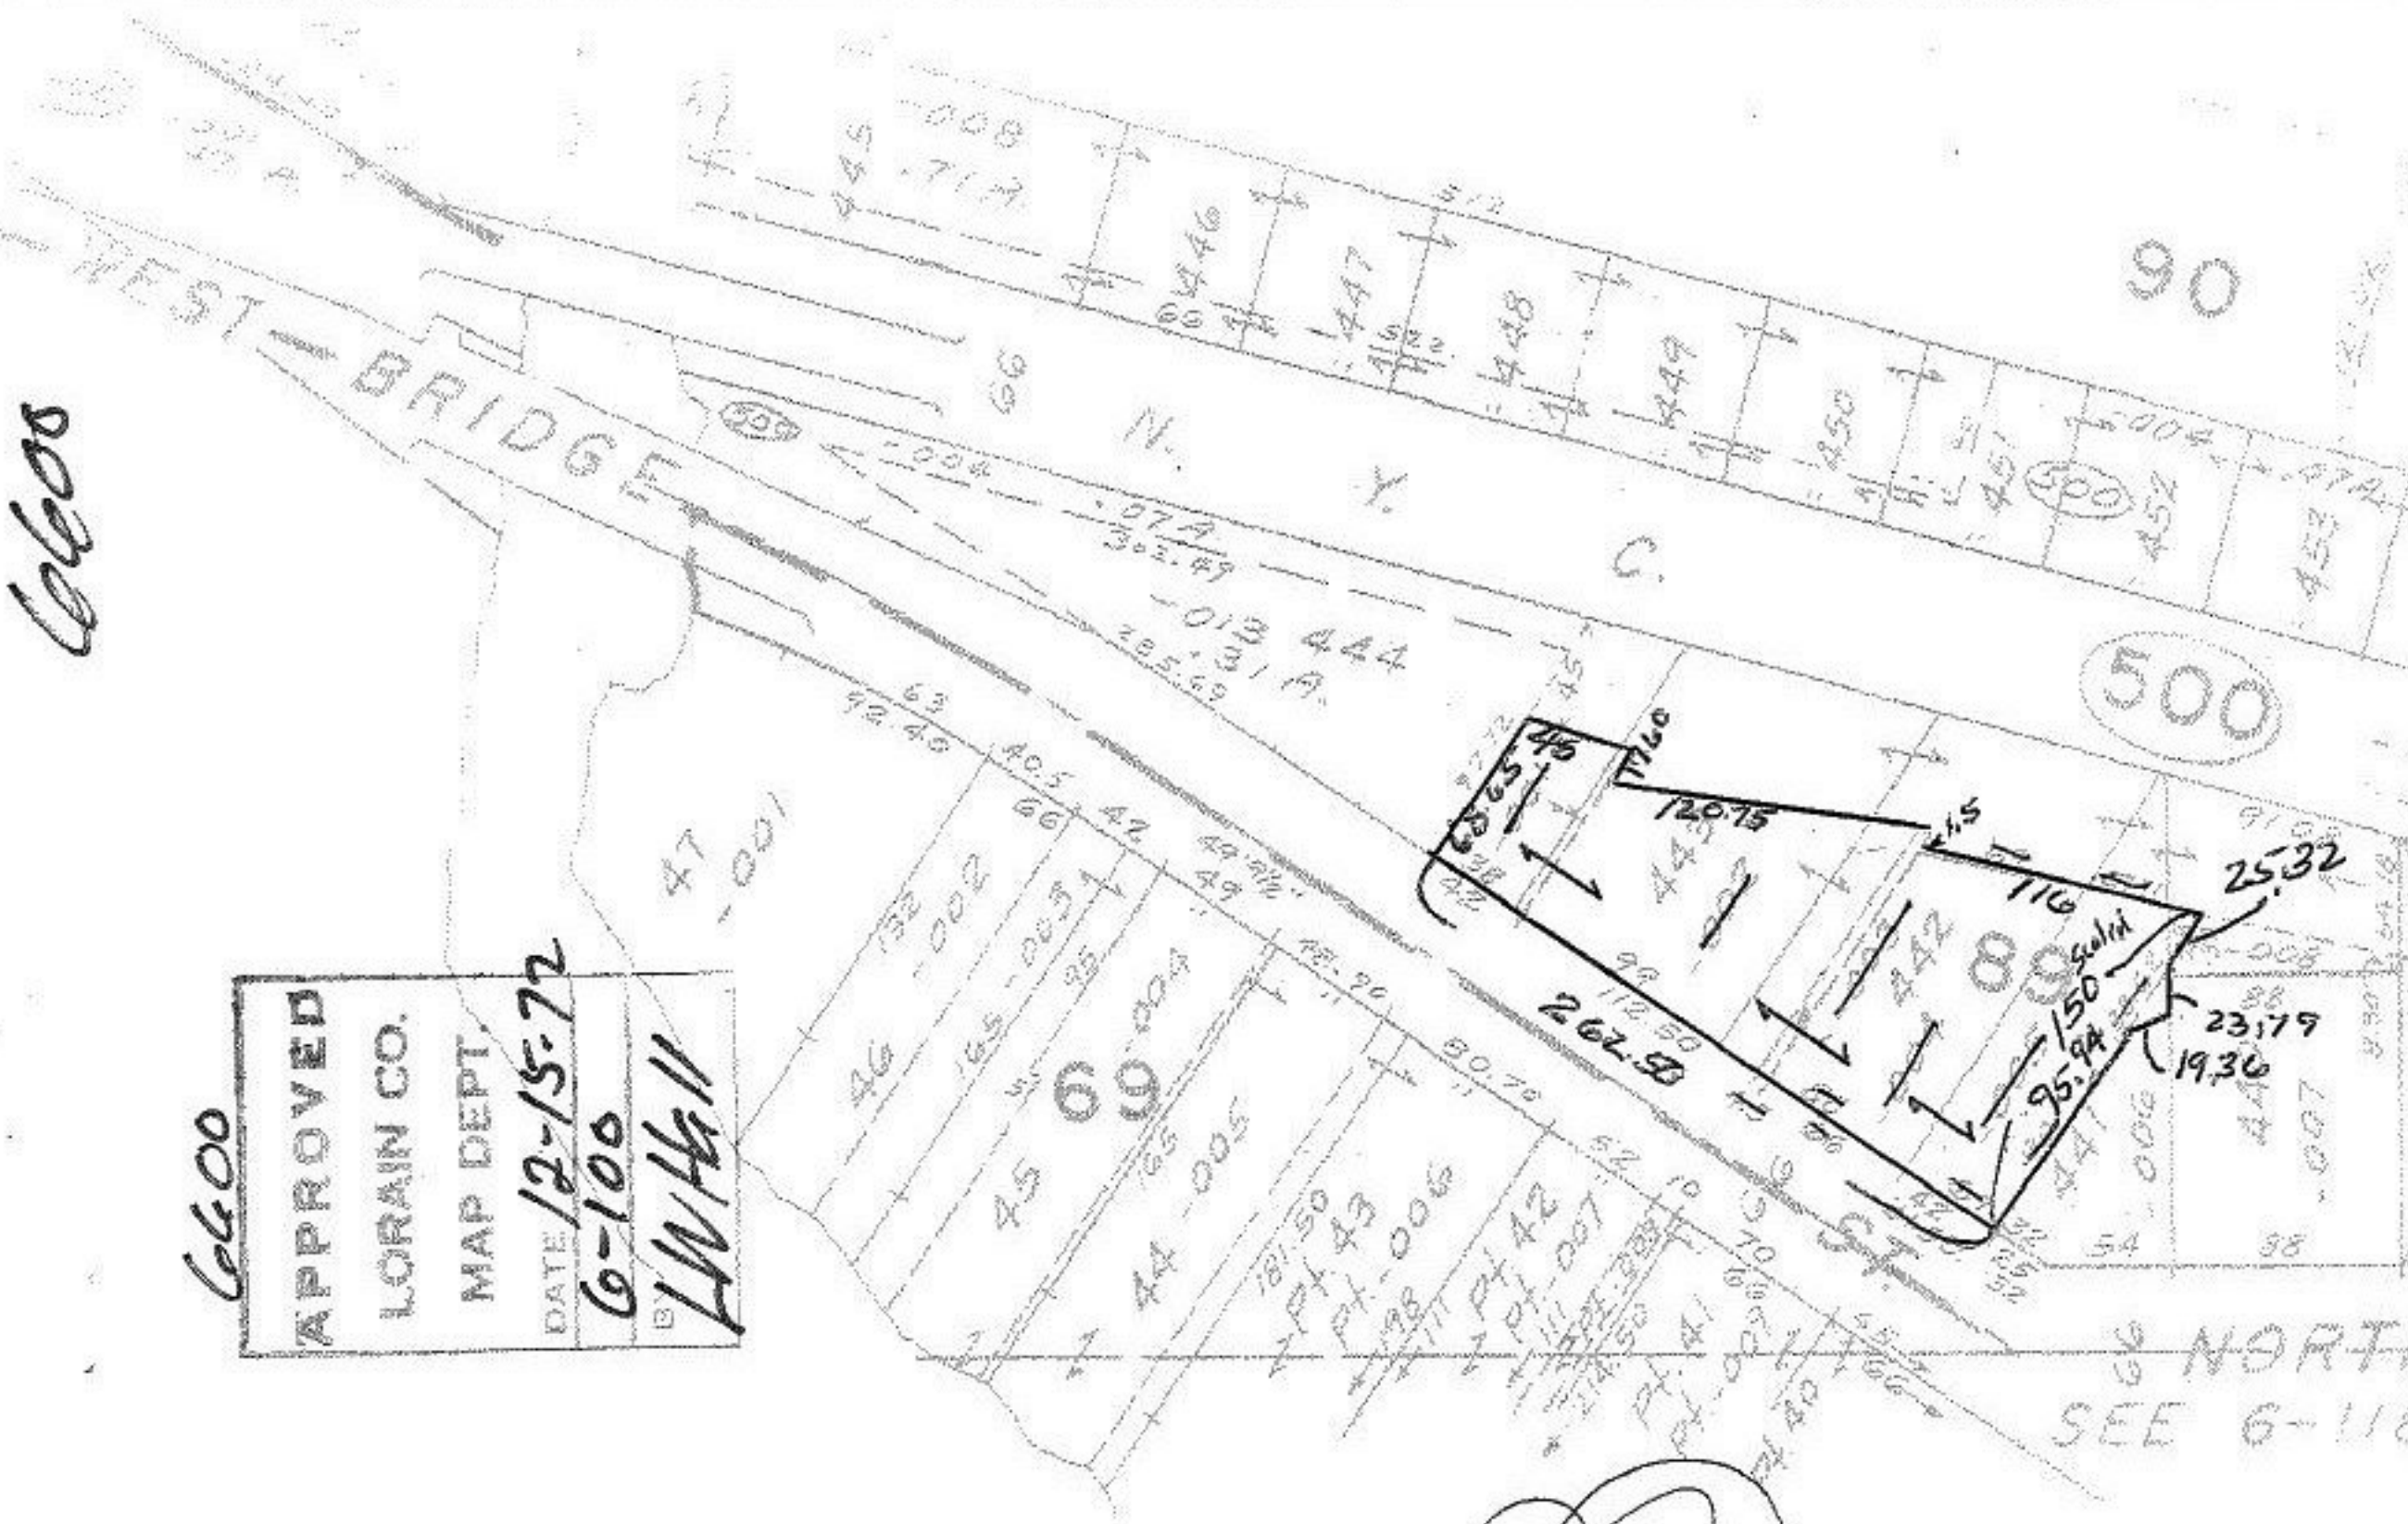

(Handwritten signature)

ELYRIA 6-100

BETWEEN THE
WEST OF RIVER

SCALE 1" = 100'