

6602

DR.

101


-178  
4.43Ac.

400.09

352.26  
HORSESHOE

4.23  
- .70  
-----  
4.93  
4.43  
- .50  
-----  
4.93

167.80

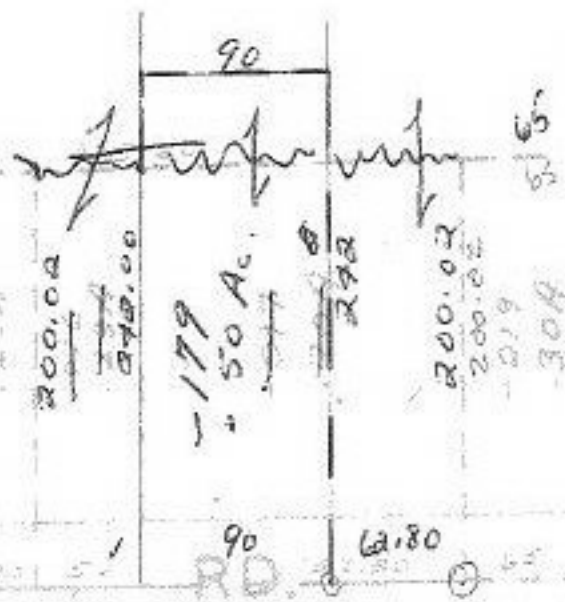

6602

APPROVED  
LORAIN CO.  
MAP DEPT.  
DATE 12-18-72  
15-00-099-B  
BY *[Signature]*

7-28-94 L.C.

PPB

TWP

15-00-099-B