


6604

MAP

1647

102
102

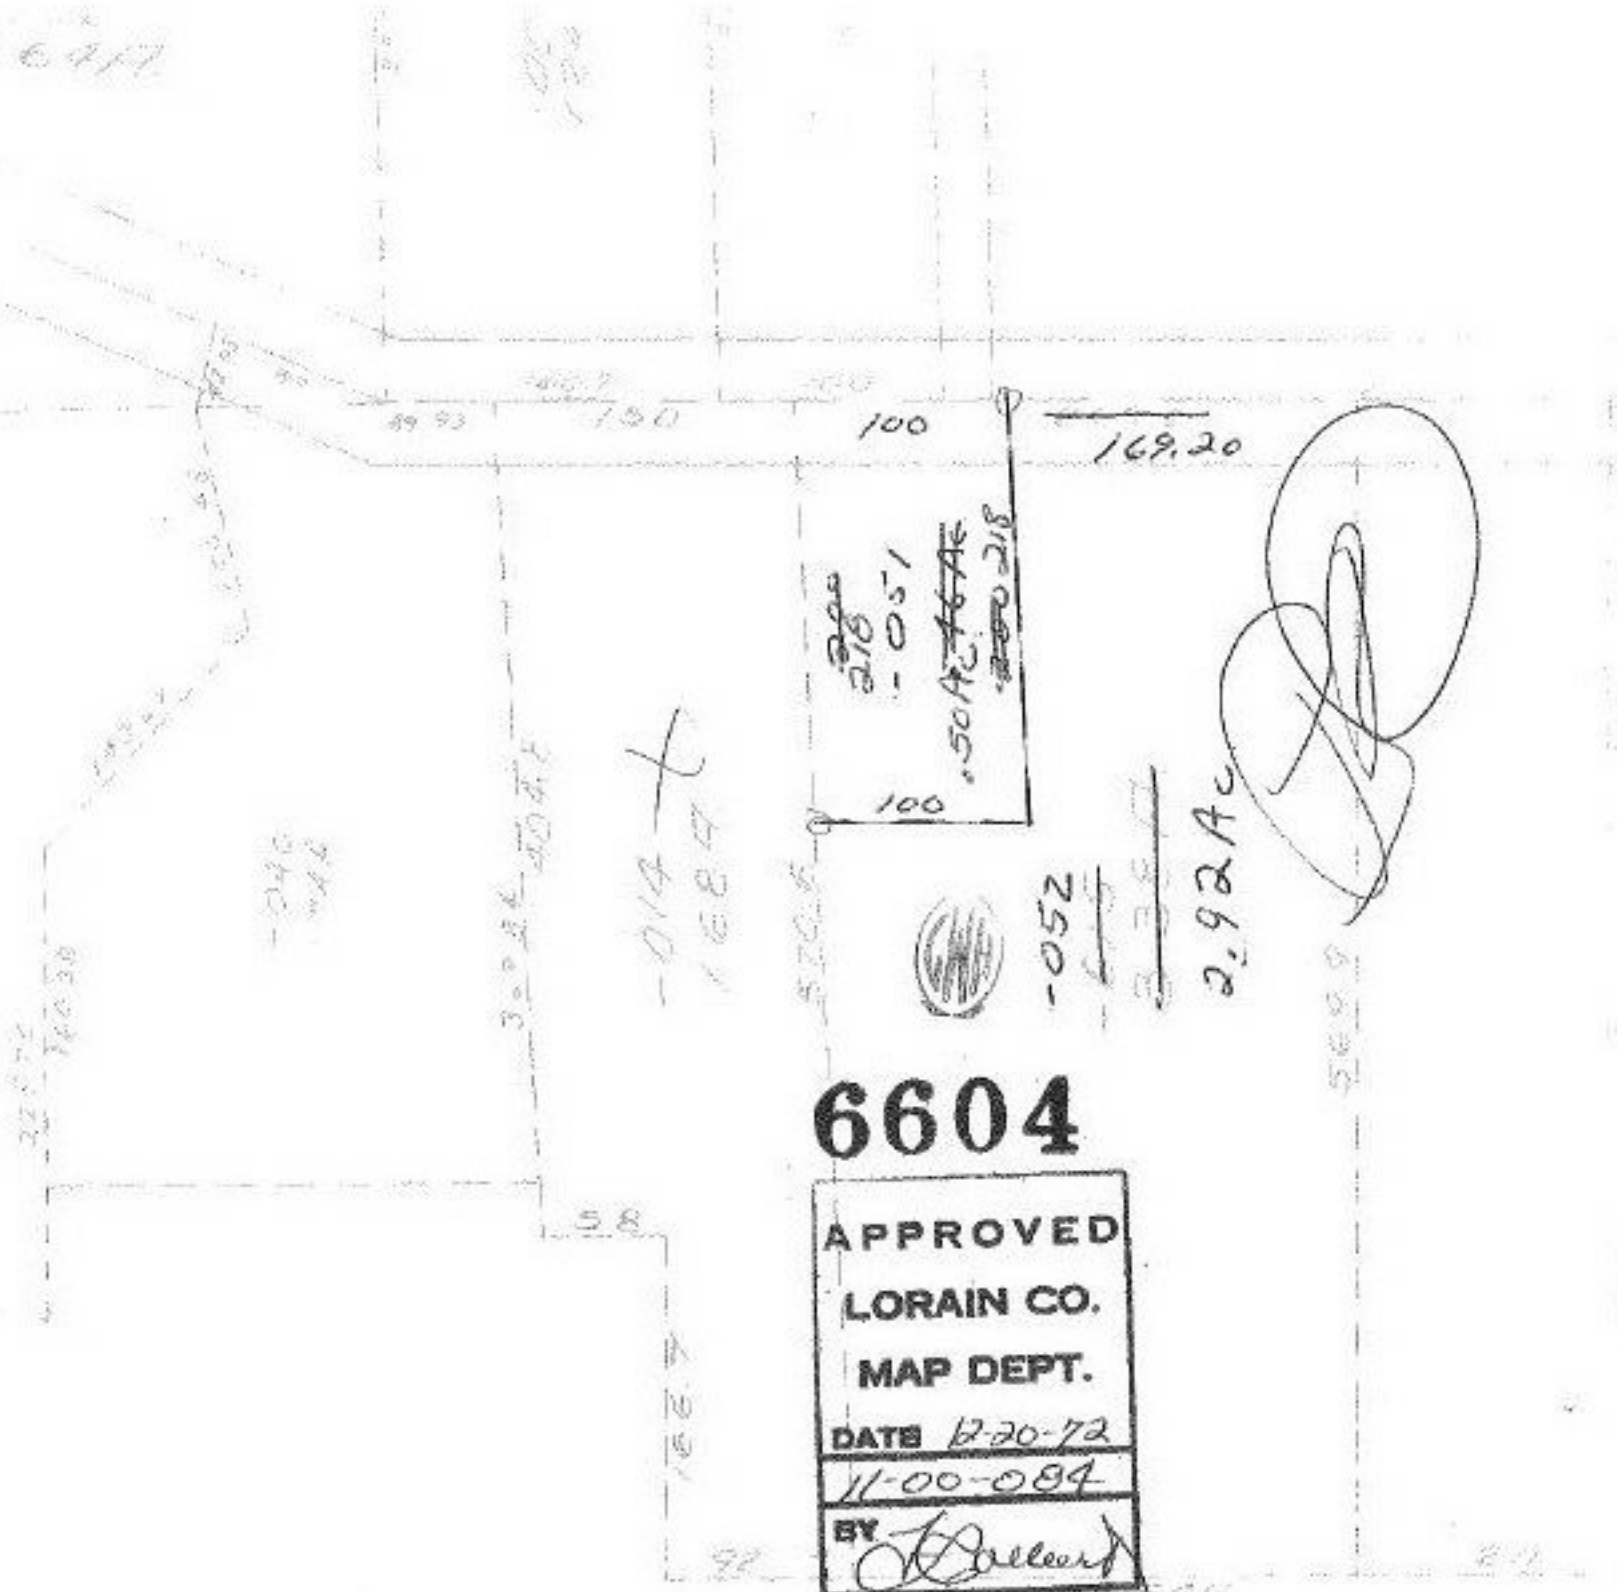

-014
1687

-040
1642


300.24
408.7

218
-0.51
.50 AC
218



-0.52

2.92 AC

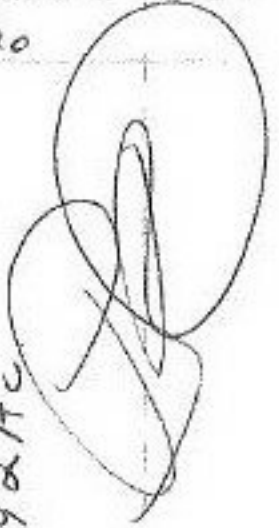

6604

APPROVED
 LORAIN CO.
 MAP DEPT.
 DATE 12-20-72
 11-00-084
 BY *L. Colcord*

111

6604