


C-M-OK SEE 9-00-085-B

6606

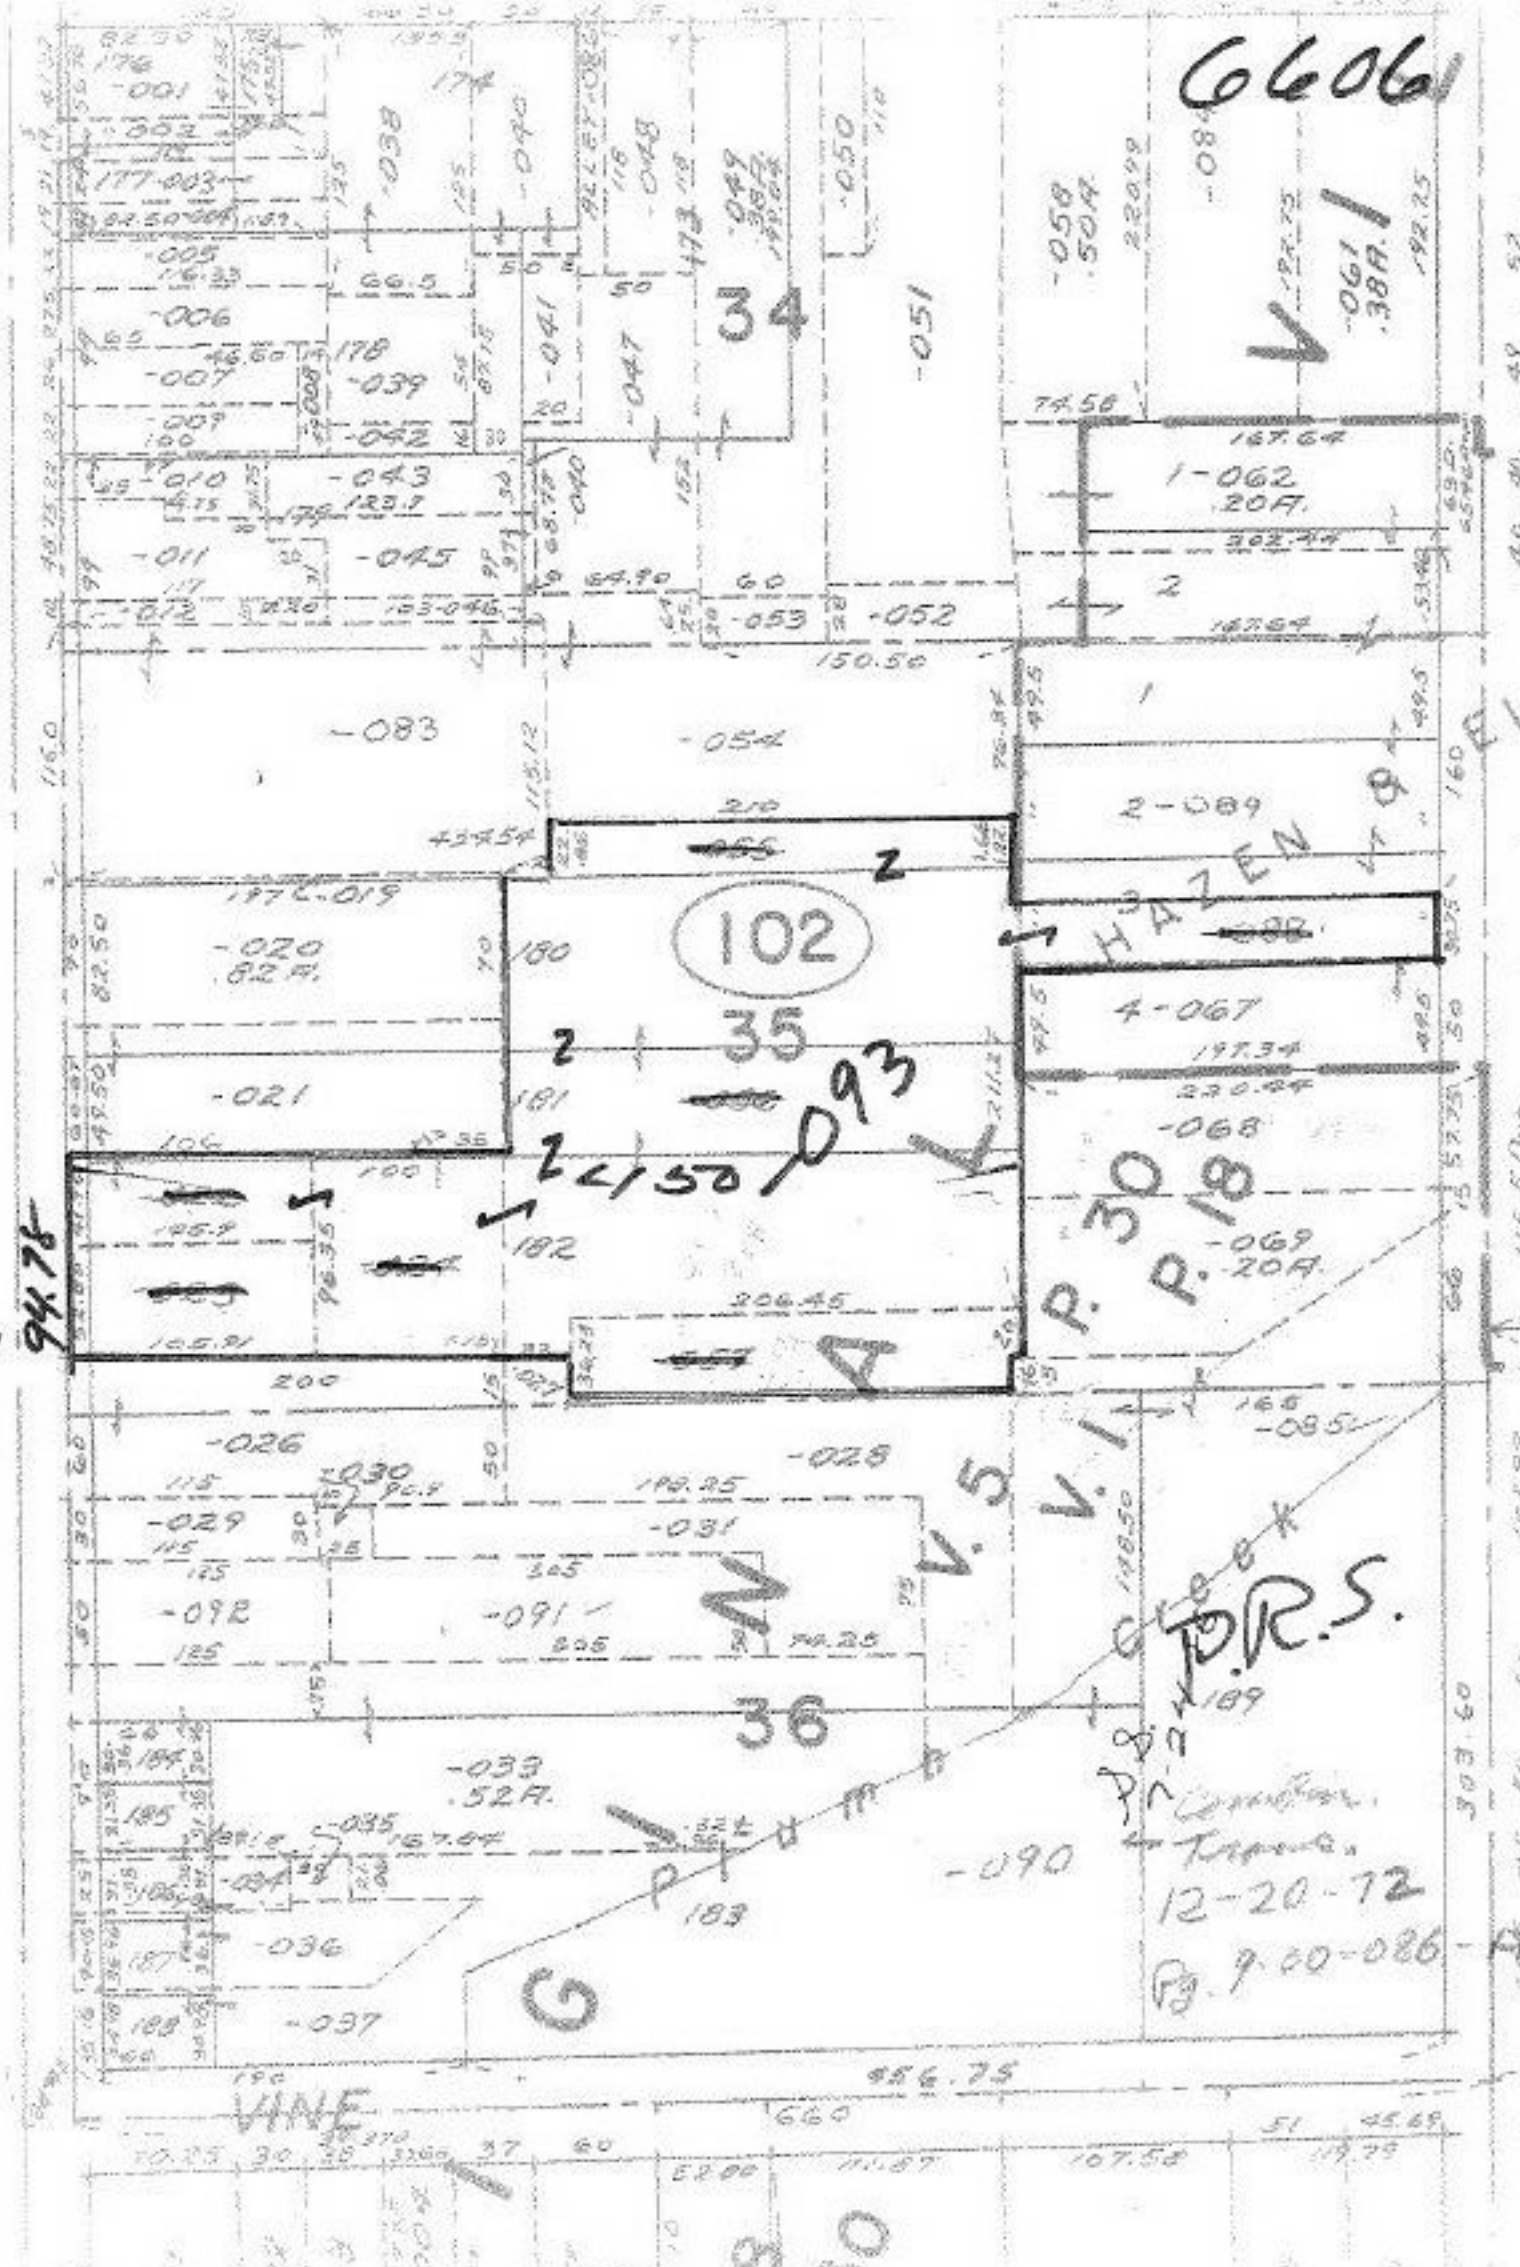

94.75

VINE

10.25	30	30	30	37	60	660	51	45.69
10.25	30	30	30	37	60	660	51	45.69
