


66/14  
15  
16  
17

PT - 033  
PT 7.52 Ac

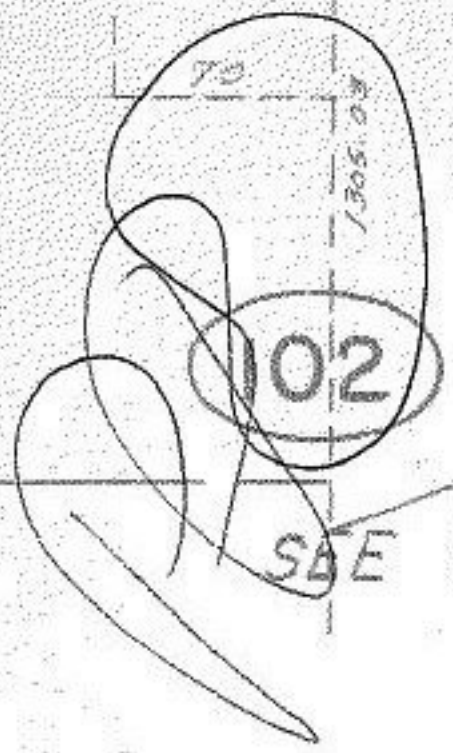

SBE 6-39

035  
PT - ~~888~~  
PT ~~51A~~  
3.79 Ac.

037  
PT - ~~888~~  
PT. ~~51A~~  
3.90 Ac.

6614  
6615  
6616  
6617

APPROVED  
LORAIN CO.  
MAP DEPT.  
DATE 1-3-73  
6-21  
BY *Lalbert*

312.65

407.11

-038  
2.89 Ac.

382.77

Also  
6-39

377.43

-039  
PT - ~~888~~  
PT. ~~51A~~  
7.19 Ac.

RD

036  
71A  
032.20

1303.80  
1299.93

225

-009  
.79A

225

146.59

172.09

153

70

70

70

1305.08

20

21.50

50