


66/14
15
16
17

PT - 033
PT 7.52 Ac

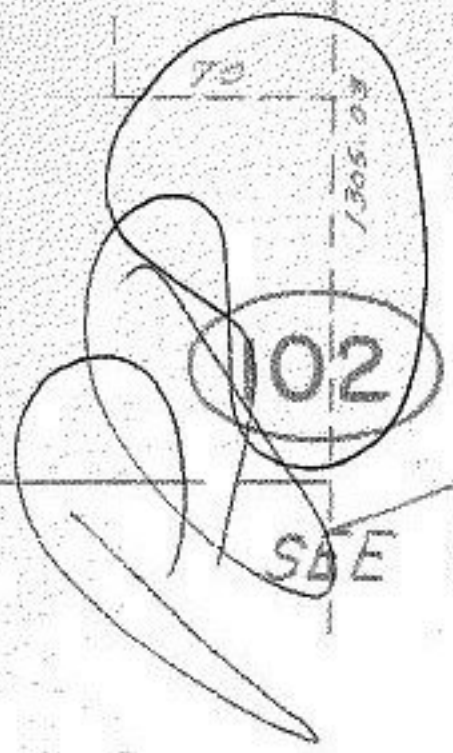

SBE 6-39

PT - 035
PT ~~8.19~~
3.79 Ac.

PT - 037
PT ~~8.19~~
3.90 Ac.

PT - 039
PT ~~8.19~~
7.19 Ac.

-038
2.89 Ac.

APPROVED
LORAIN CO.
MAP DEPT.
DATE 1-3-73
6-21
BY *Lalbert*

6614
6615
6616
6617

312.65

382.77

Also
6-39

377.43

407.11

RD

146.59

172.09

153

225

225

225

225

1303.80
1299.93

1305.08

-009
.799

-039

7.19 Ac.

6614
6615
6616
6617