

154.97

334.33

66 14
15
16
17

Pt. -033
Pt. 4.52 Ac.

-032
2.77 Ac.

427.13

172.46

149.43

311.60

179.32

184.89

SEE 6-21

312.65

-036
1.23 Ac.

-034
1.21 Ac.

Pt. 3.79 Ac.

-035

Pt. ~~3.79~~

Pt. ~~3.79~~

-037

Pt. ~~3.90~~

Pt. ~~3.90~~

3.90 Ac.

6614
6615
6616
6617

-039


Pt. ~~7.19~~

Pt. ~~7.19~~

7.19 Ac.

382.77

APPROVED
LORAIN CO.
MAP DEPT.
DATE 1-3-73
6-39
BY <i>[Signature]</i>

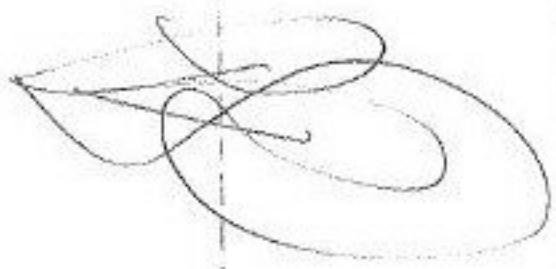

614.82