


6624

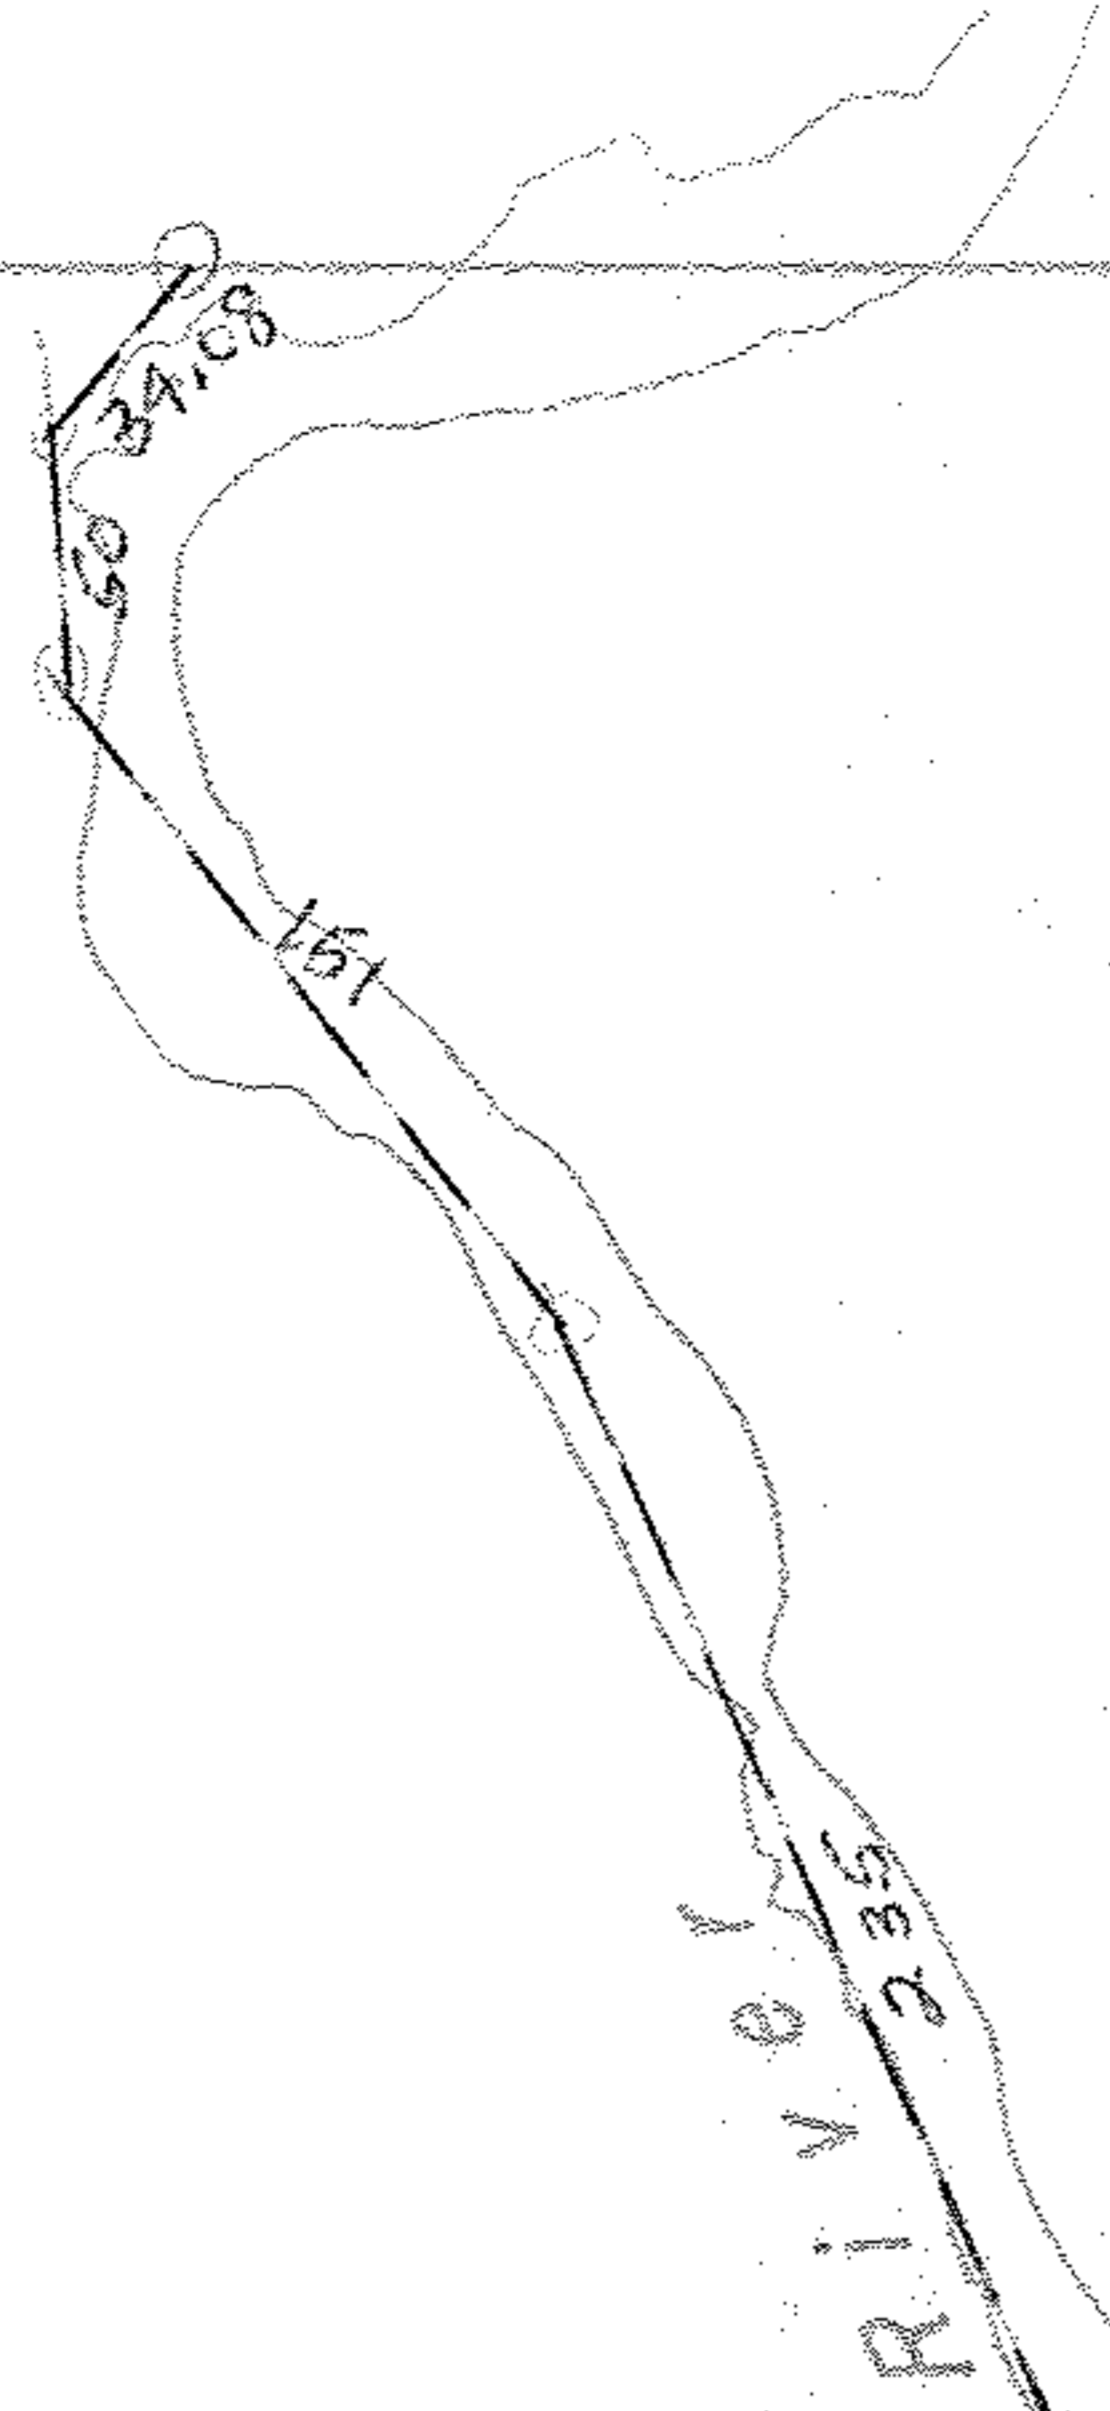


6624

APPROVED
 LORAIN CO.
 MAP DEPT.
 DATE 1-4-73
 13-11-005
 BY *R. D. ...*


1117.38

-013
11.33 AC

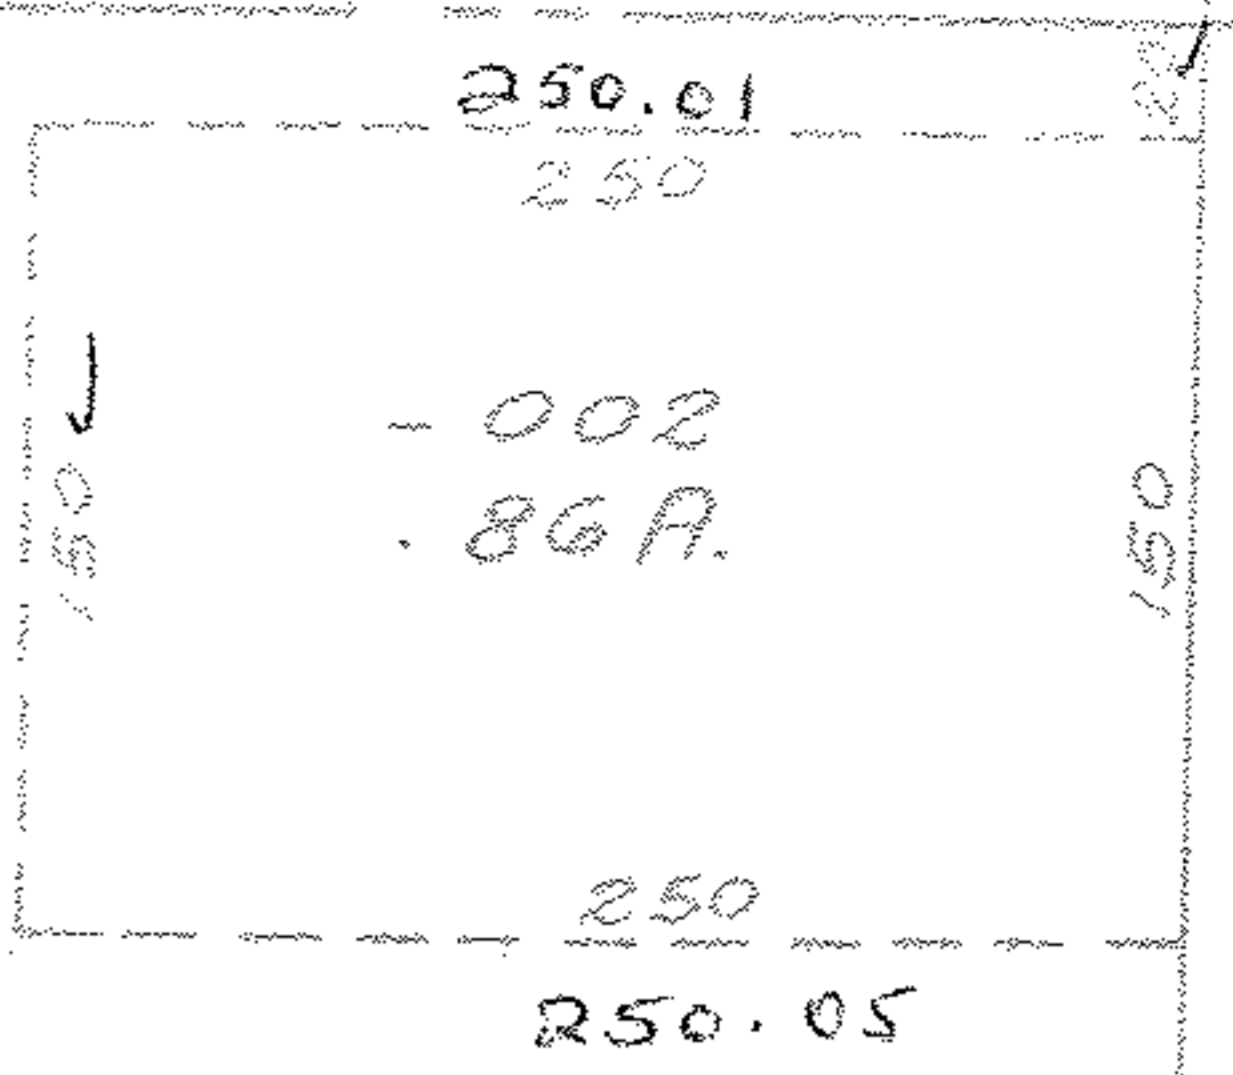

-014
~~-012~~
~~73.32 A.~~
61.99 AC.

73.32
11.33
61.99

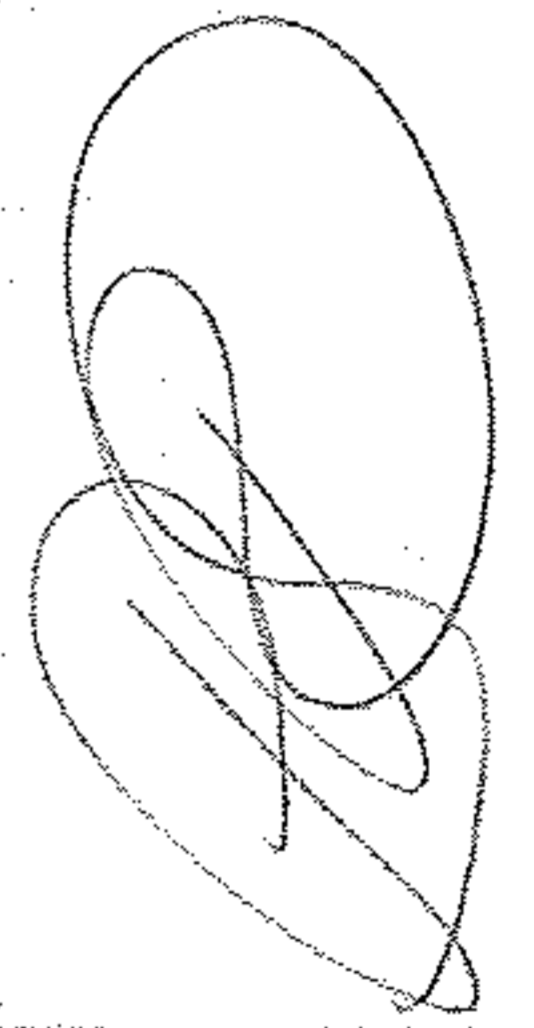

60
150
150
250
250.05
373
8320
5504
999.32
6624