

SEE 21-F FOR PARCEL NOS.

OBERLIN

ASHLAND

- 004
38.40 A.

6628

2556.41


16

TRACT

- 001
57.37 A.

1964.30

NEW LONDON - EASTERN

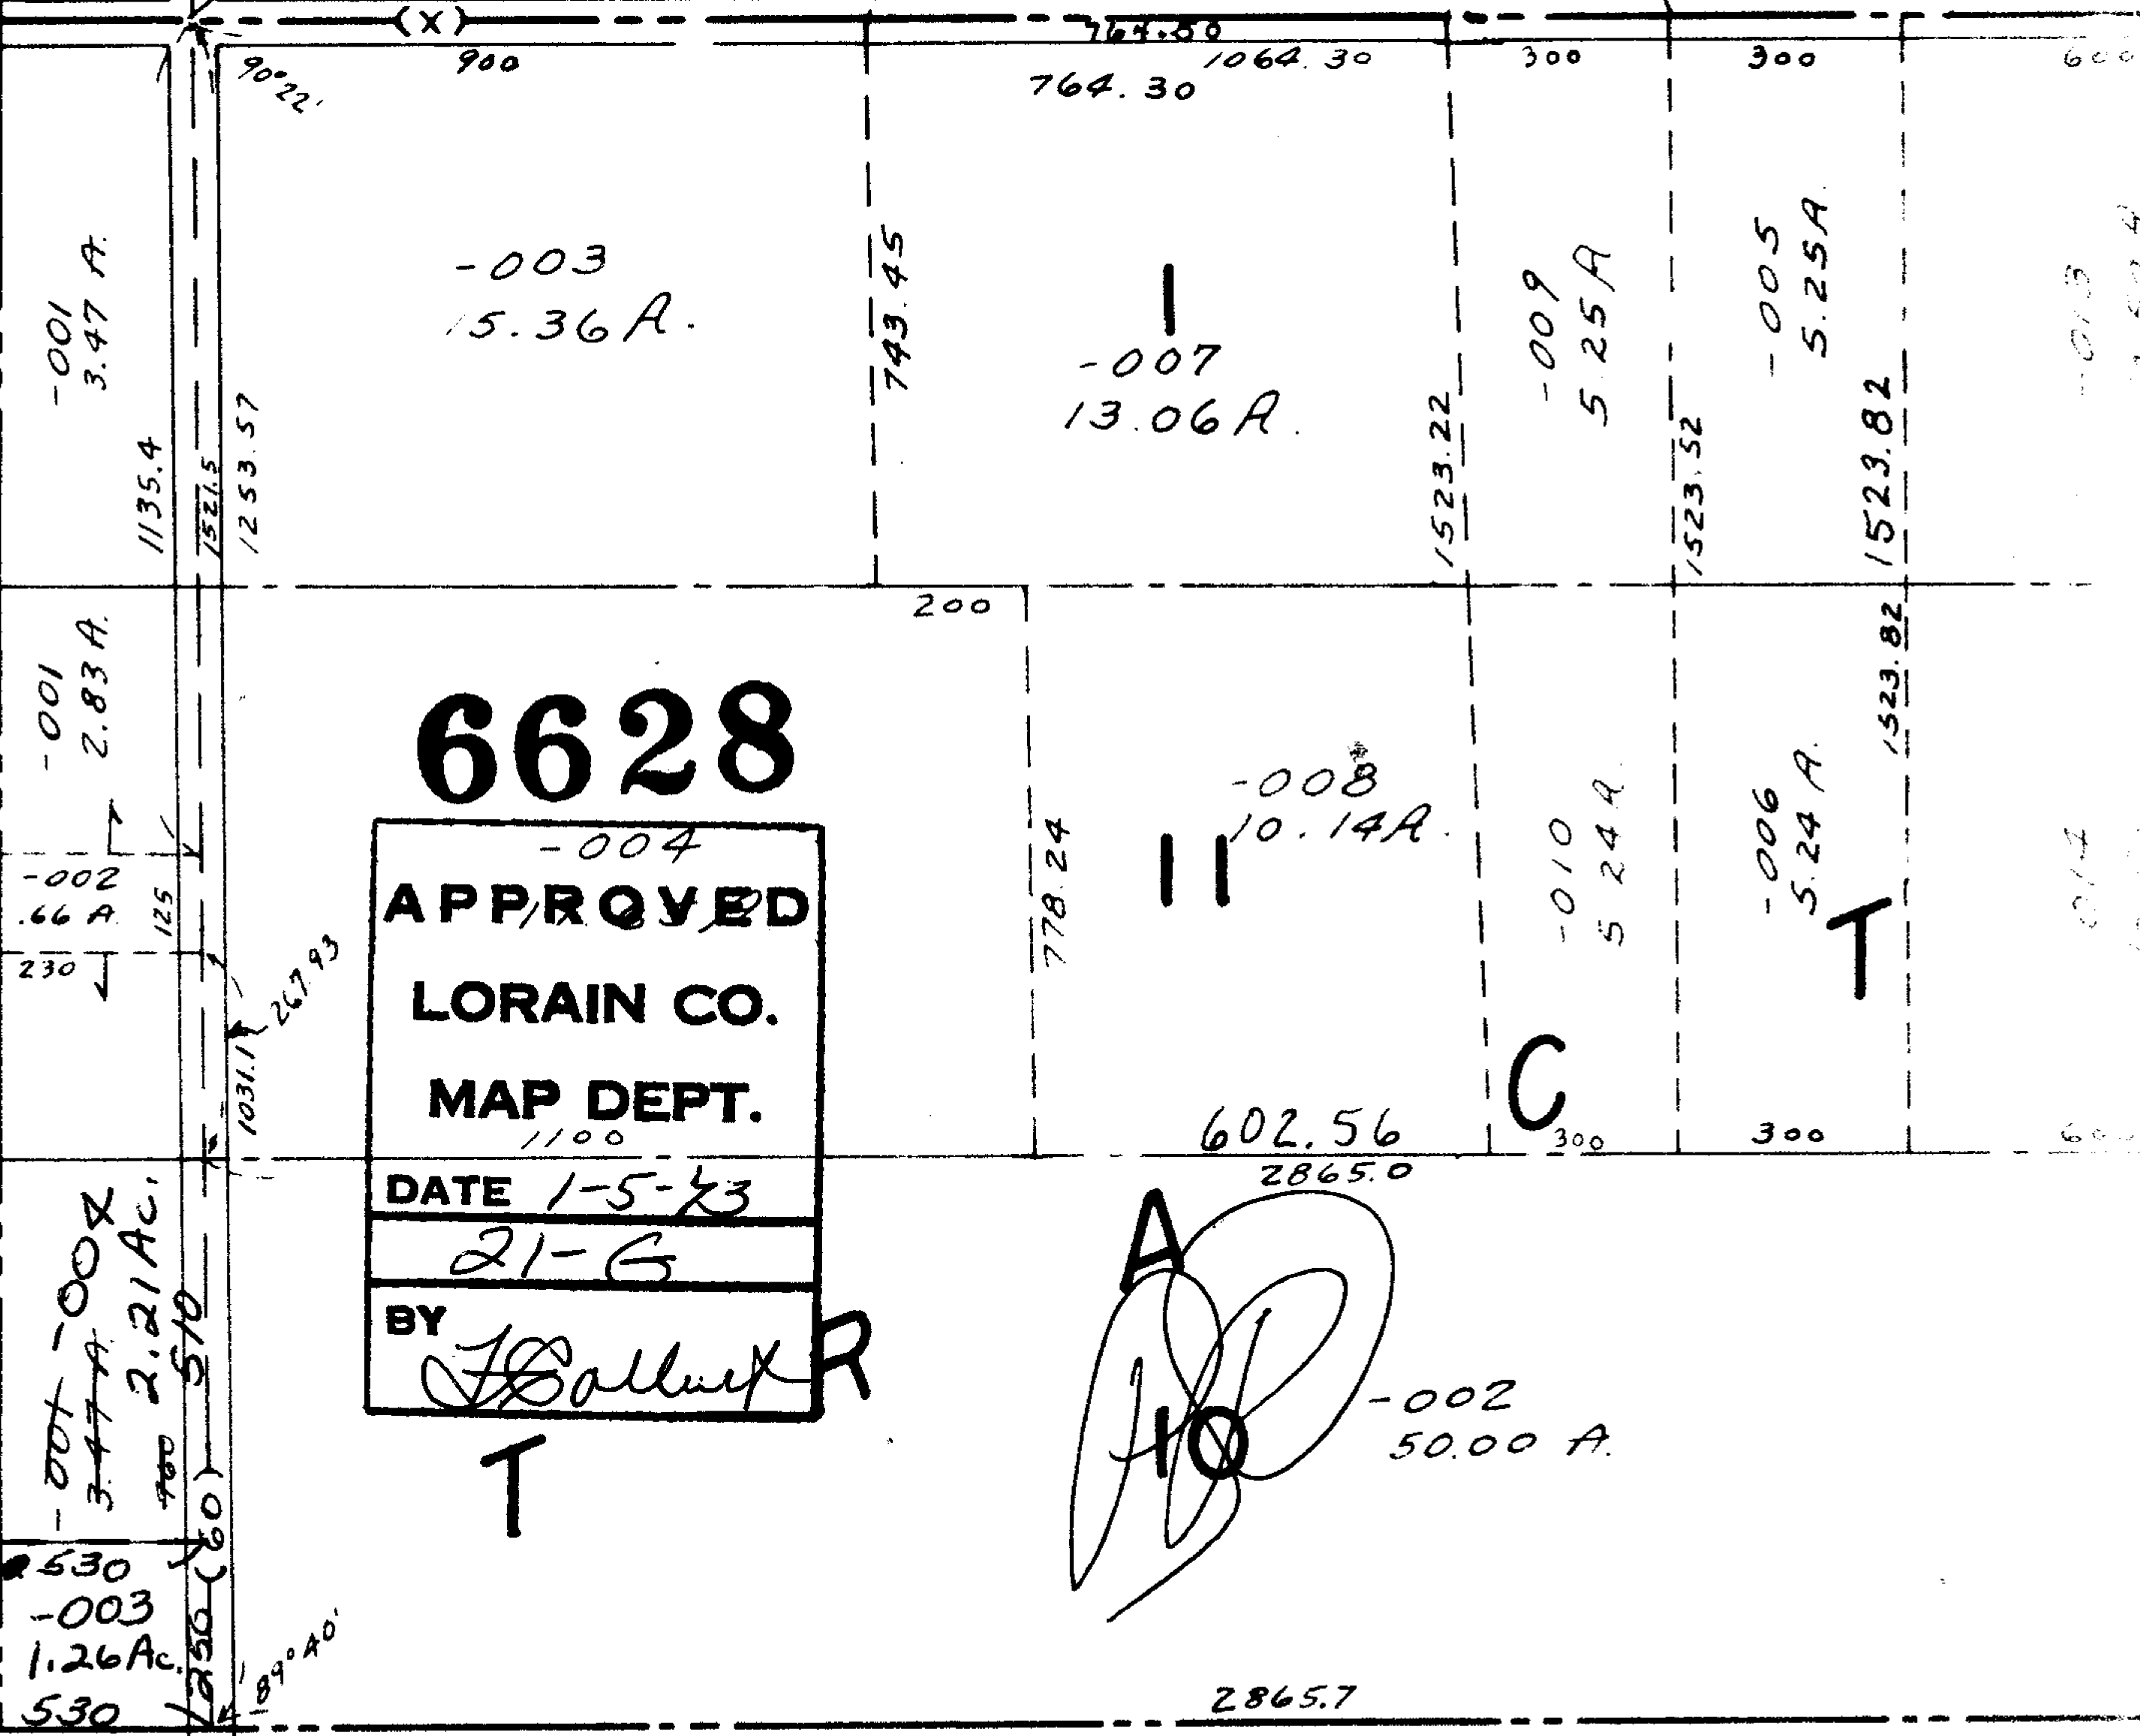

6628

- 004
APPROVED
LORAIN CO.
MAP DEPT.
 1100
DATE 1-5-23
21-G
BY
[Signature]

T

A
 10
 C

- 002
50.00 A.

3.47
 1.26
 2.21

58

HUNTINGTON TW

SCALE: 1" = 400'