


6644
 Dup
 Map
 Correct
 Copy

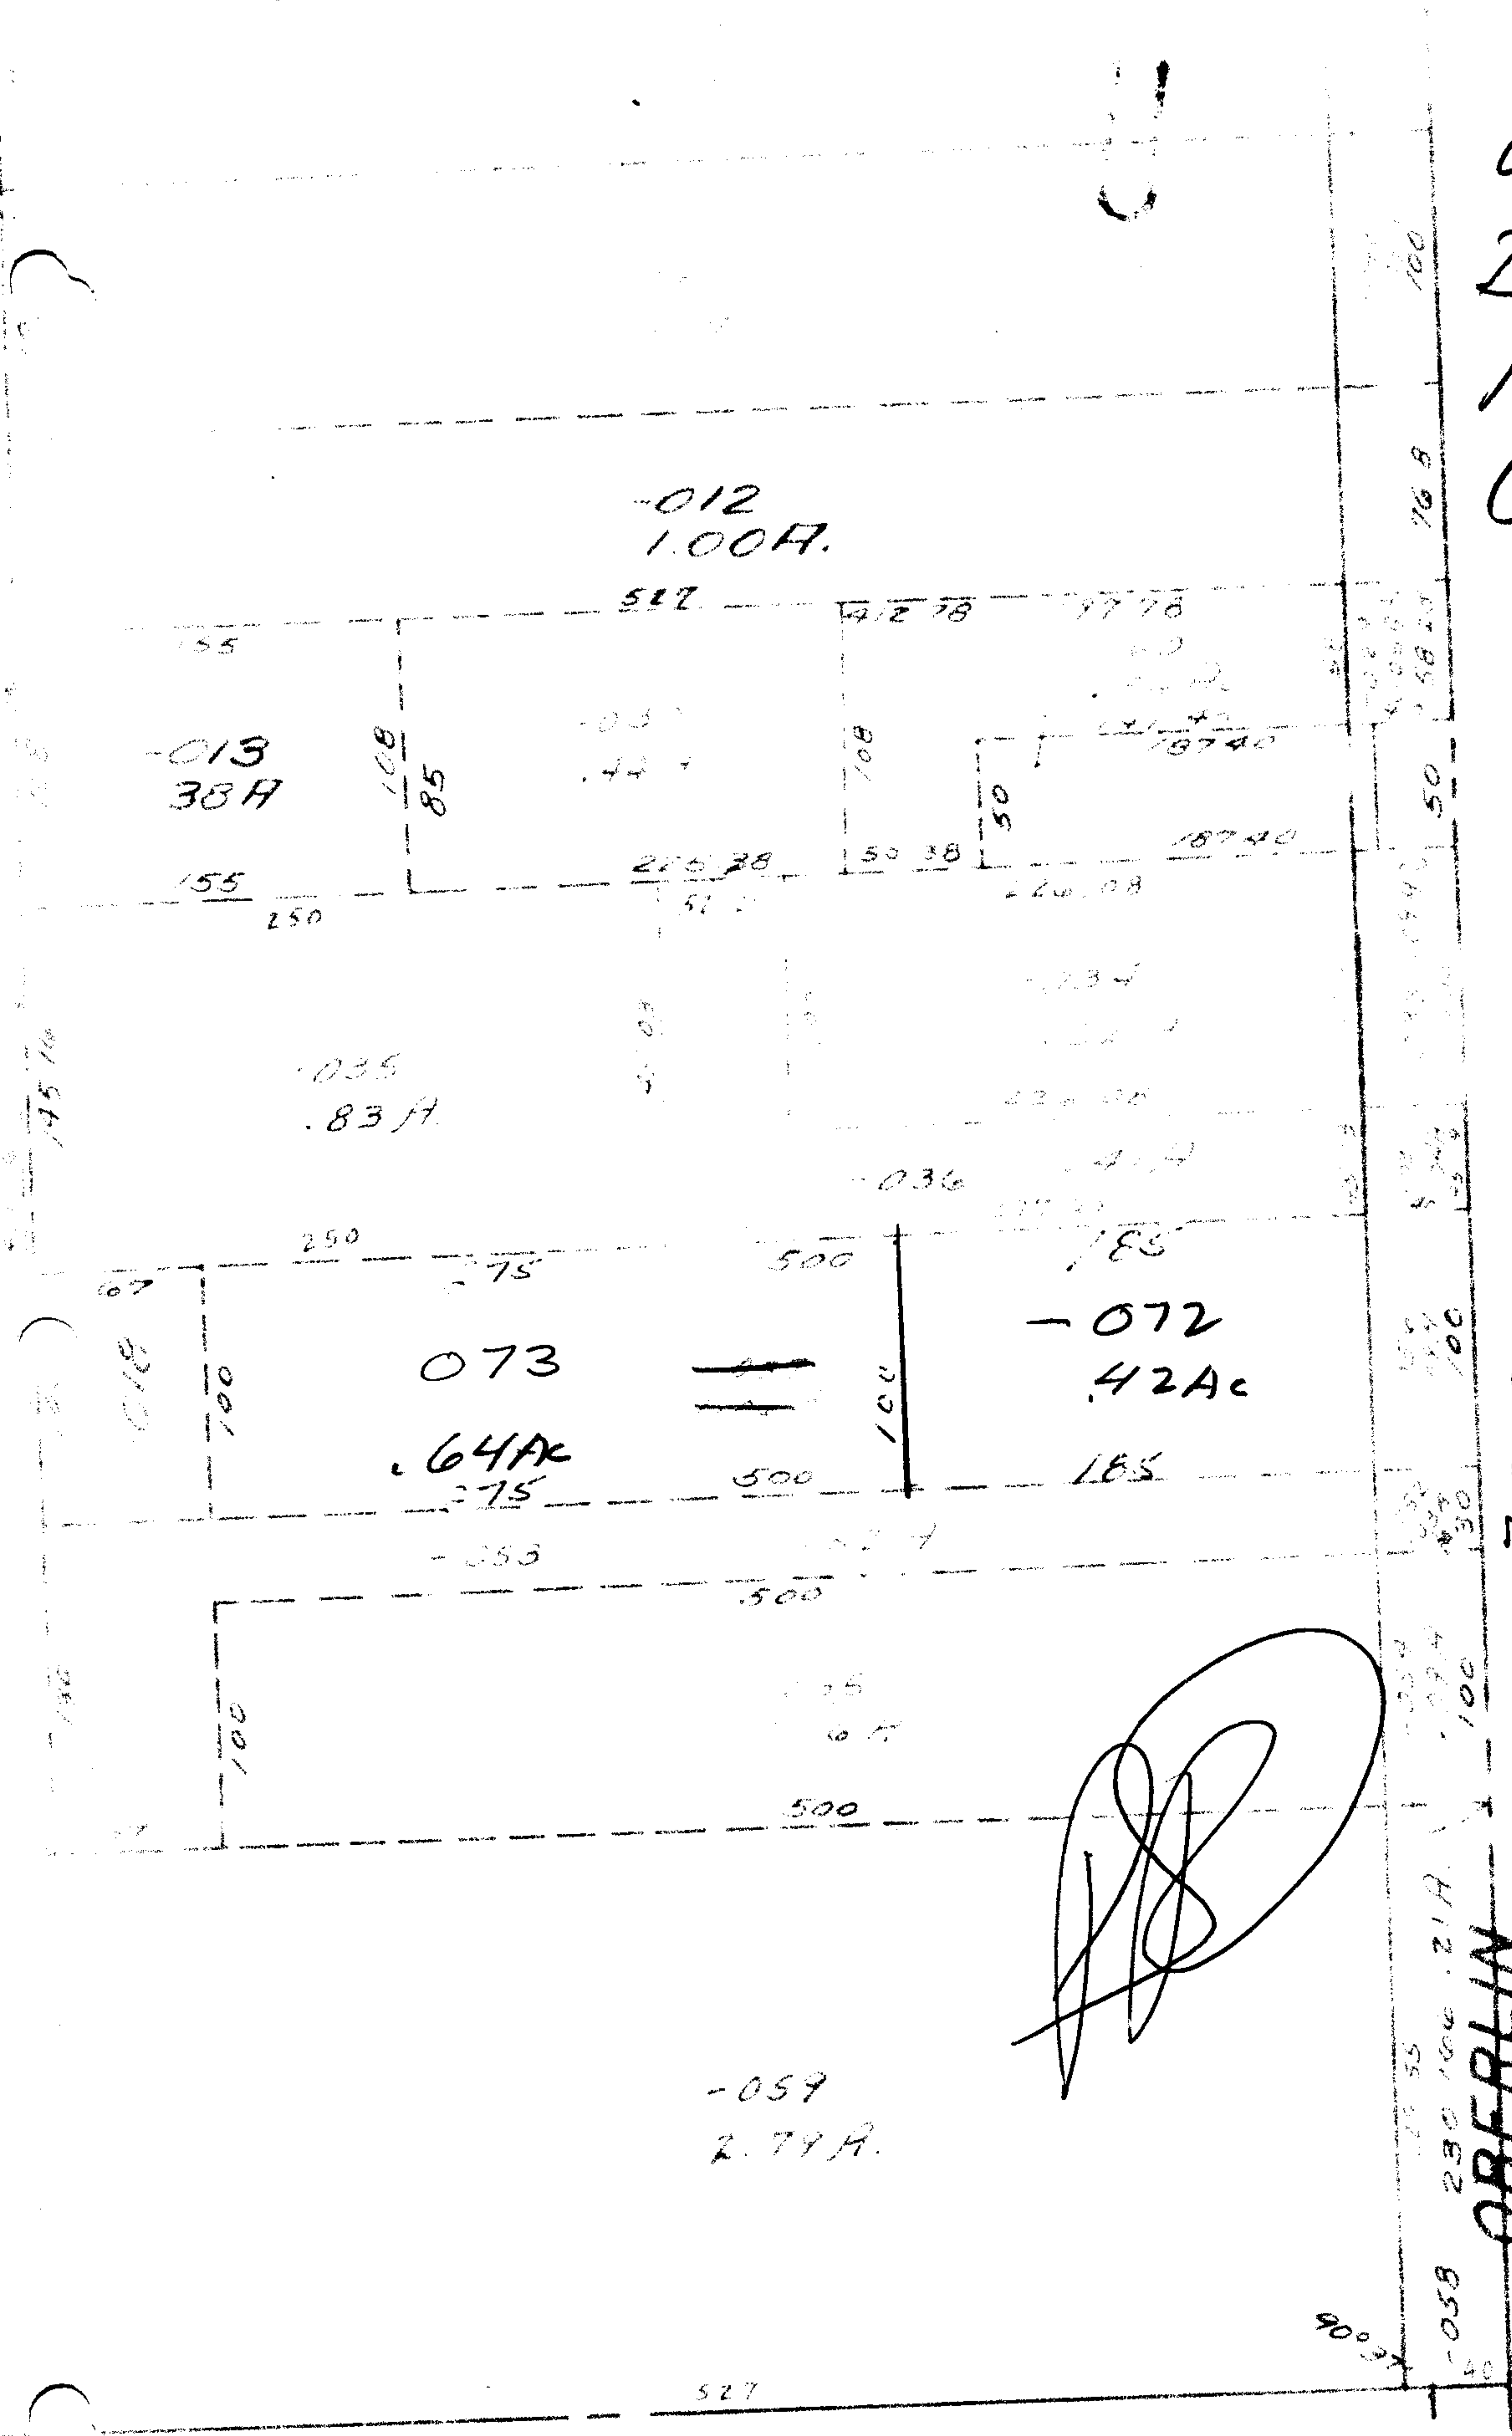

6644
APPROVED
LORAIN CO.
MAP DEPT.
 DATE 1-10-73
 02-02-006B
 BY L W Hall

7-21-86
 5.5

Map
 Correction
 1.06
 42
 64

500
 40
 460
 185
 275

005-B