

6651

6-64

See

PT 012
PT
20.51 AC

739.92

3066.93
7588.85

~~468.88~~
436.88

6651


APPROVED
LORAIN CO.
MAP DEPT.
DATE 1-18-73
6-65, 6-64
BY L.W. Hall

PT. ~~008~~
PT. ~~30.51 AC~~

- 011
10.00 A

691.19


2012.90

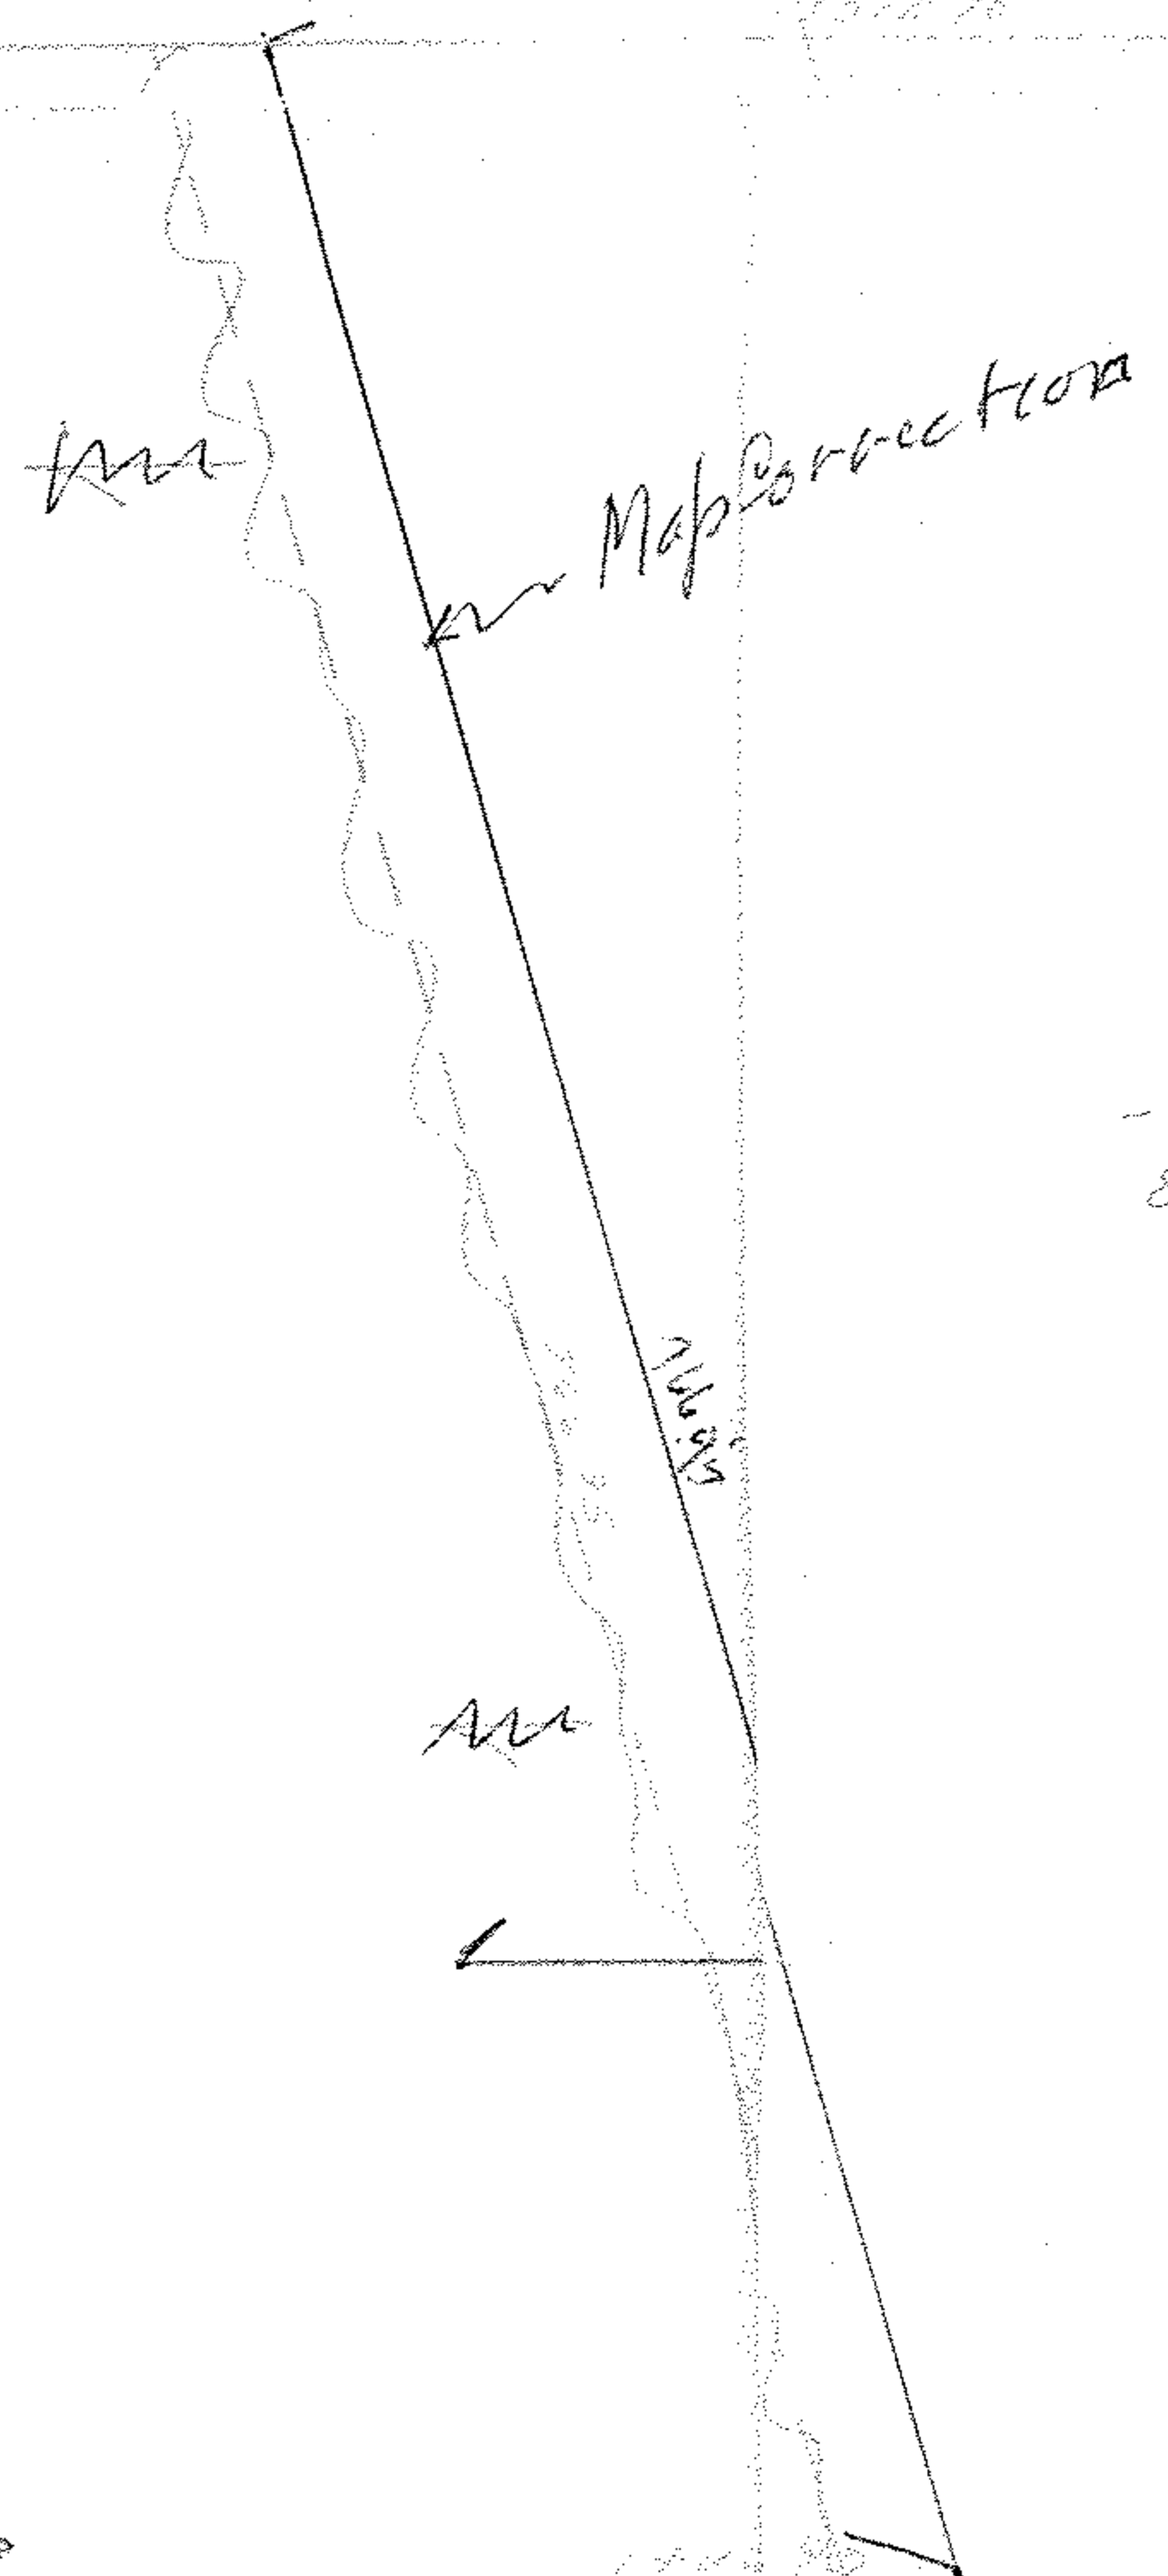

- 007
8.00 A

903.85

Note
Map Corre

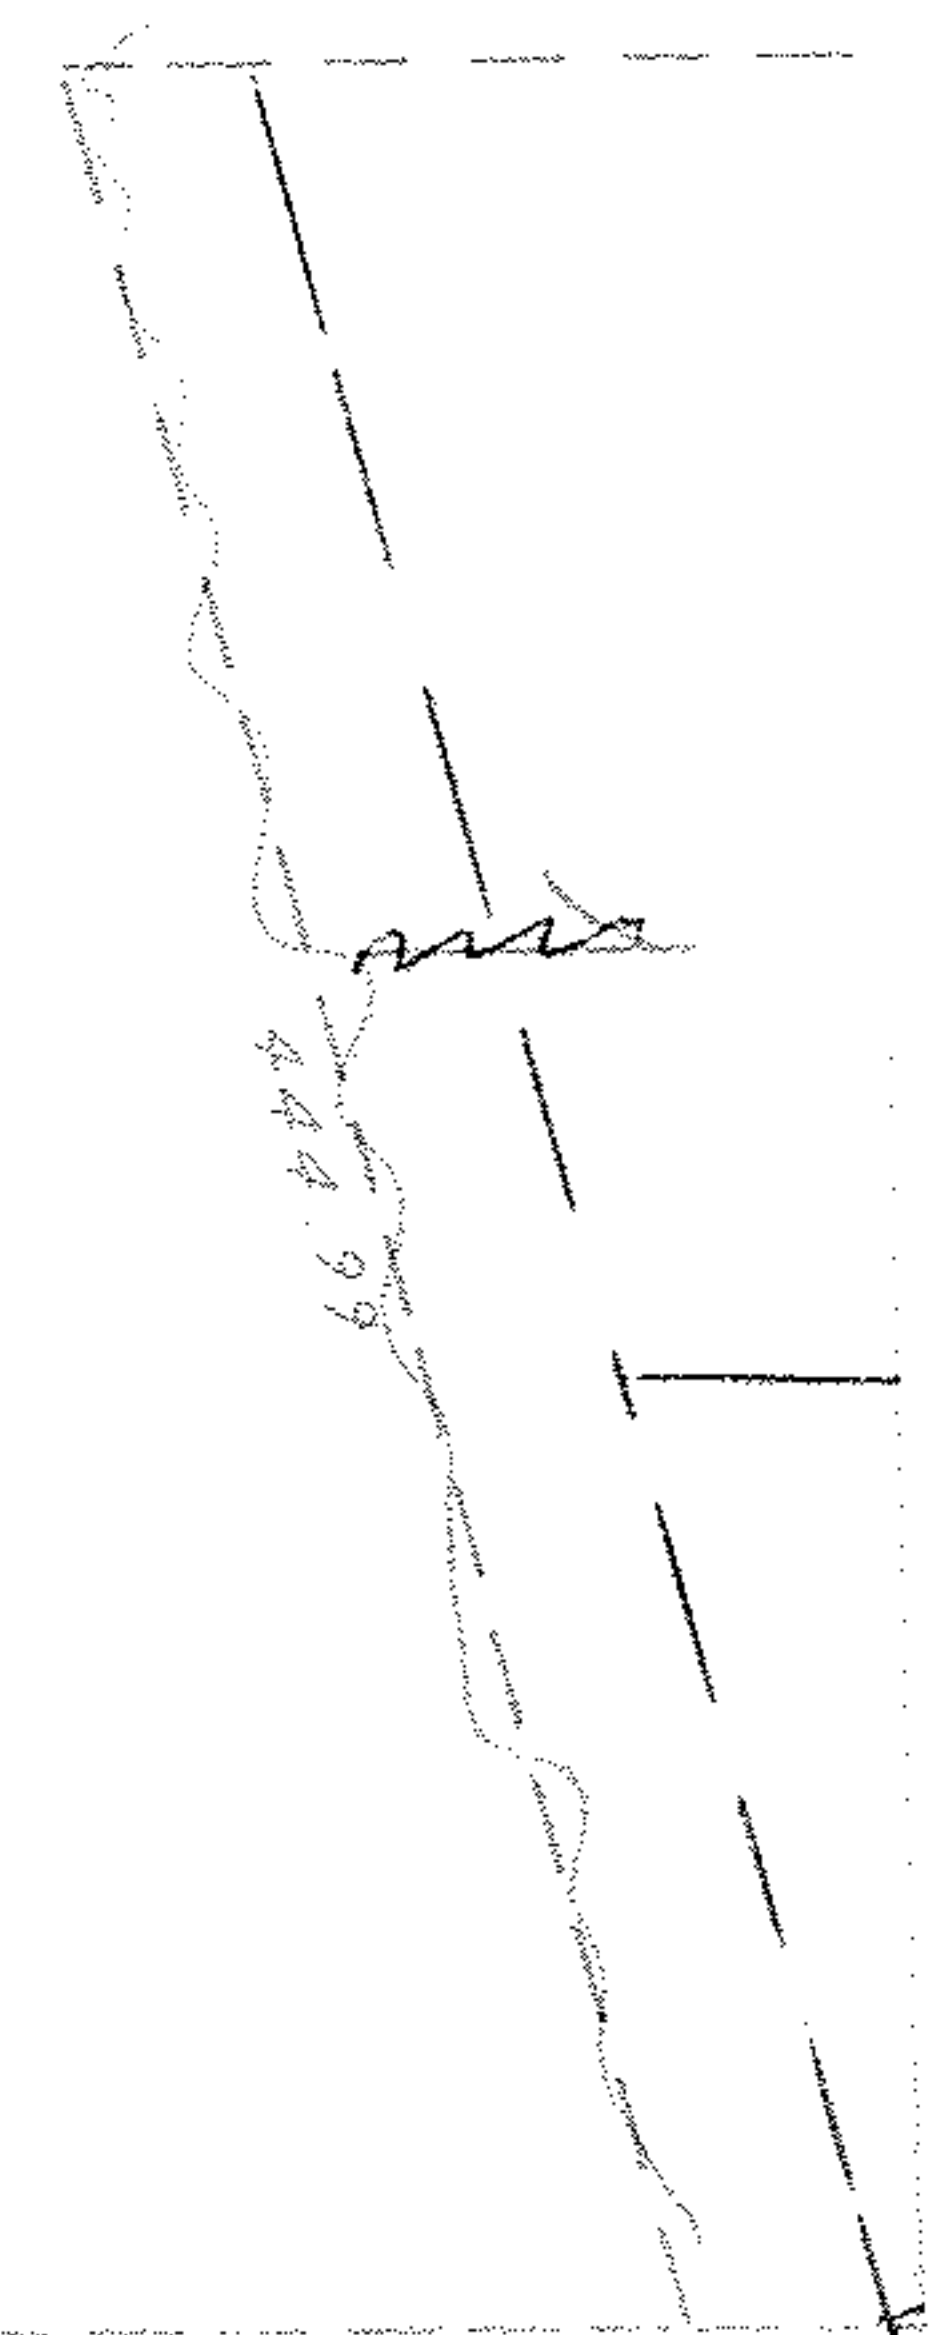

1889.96

456.34