


6657

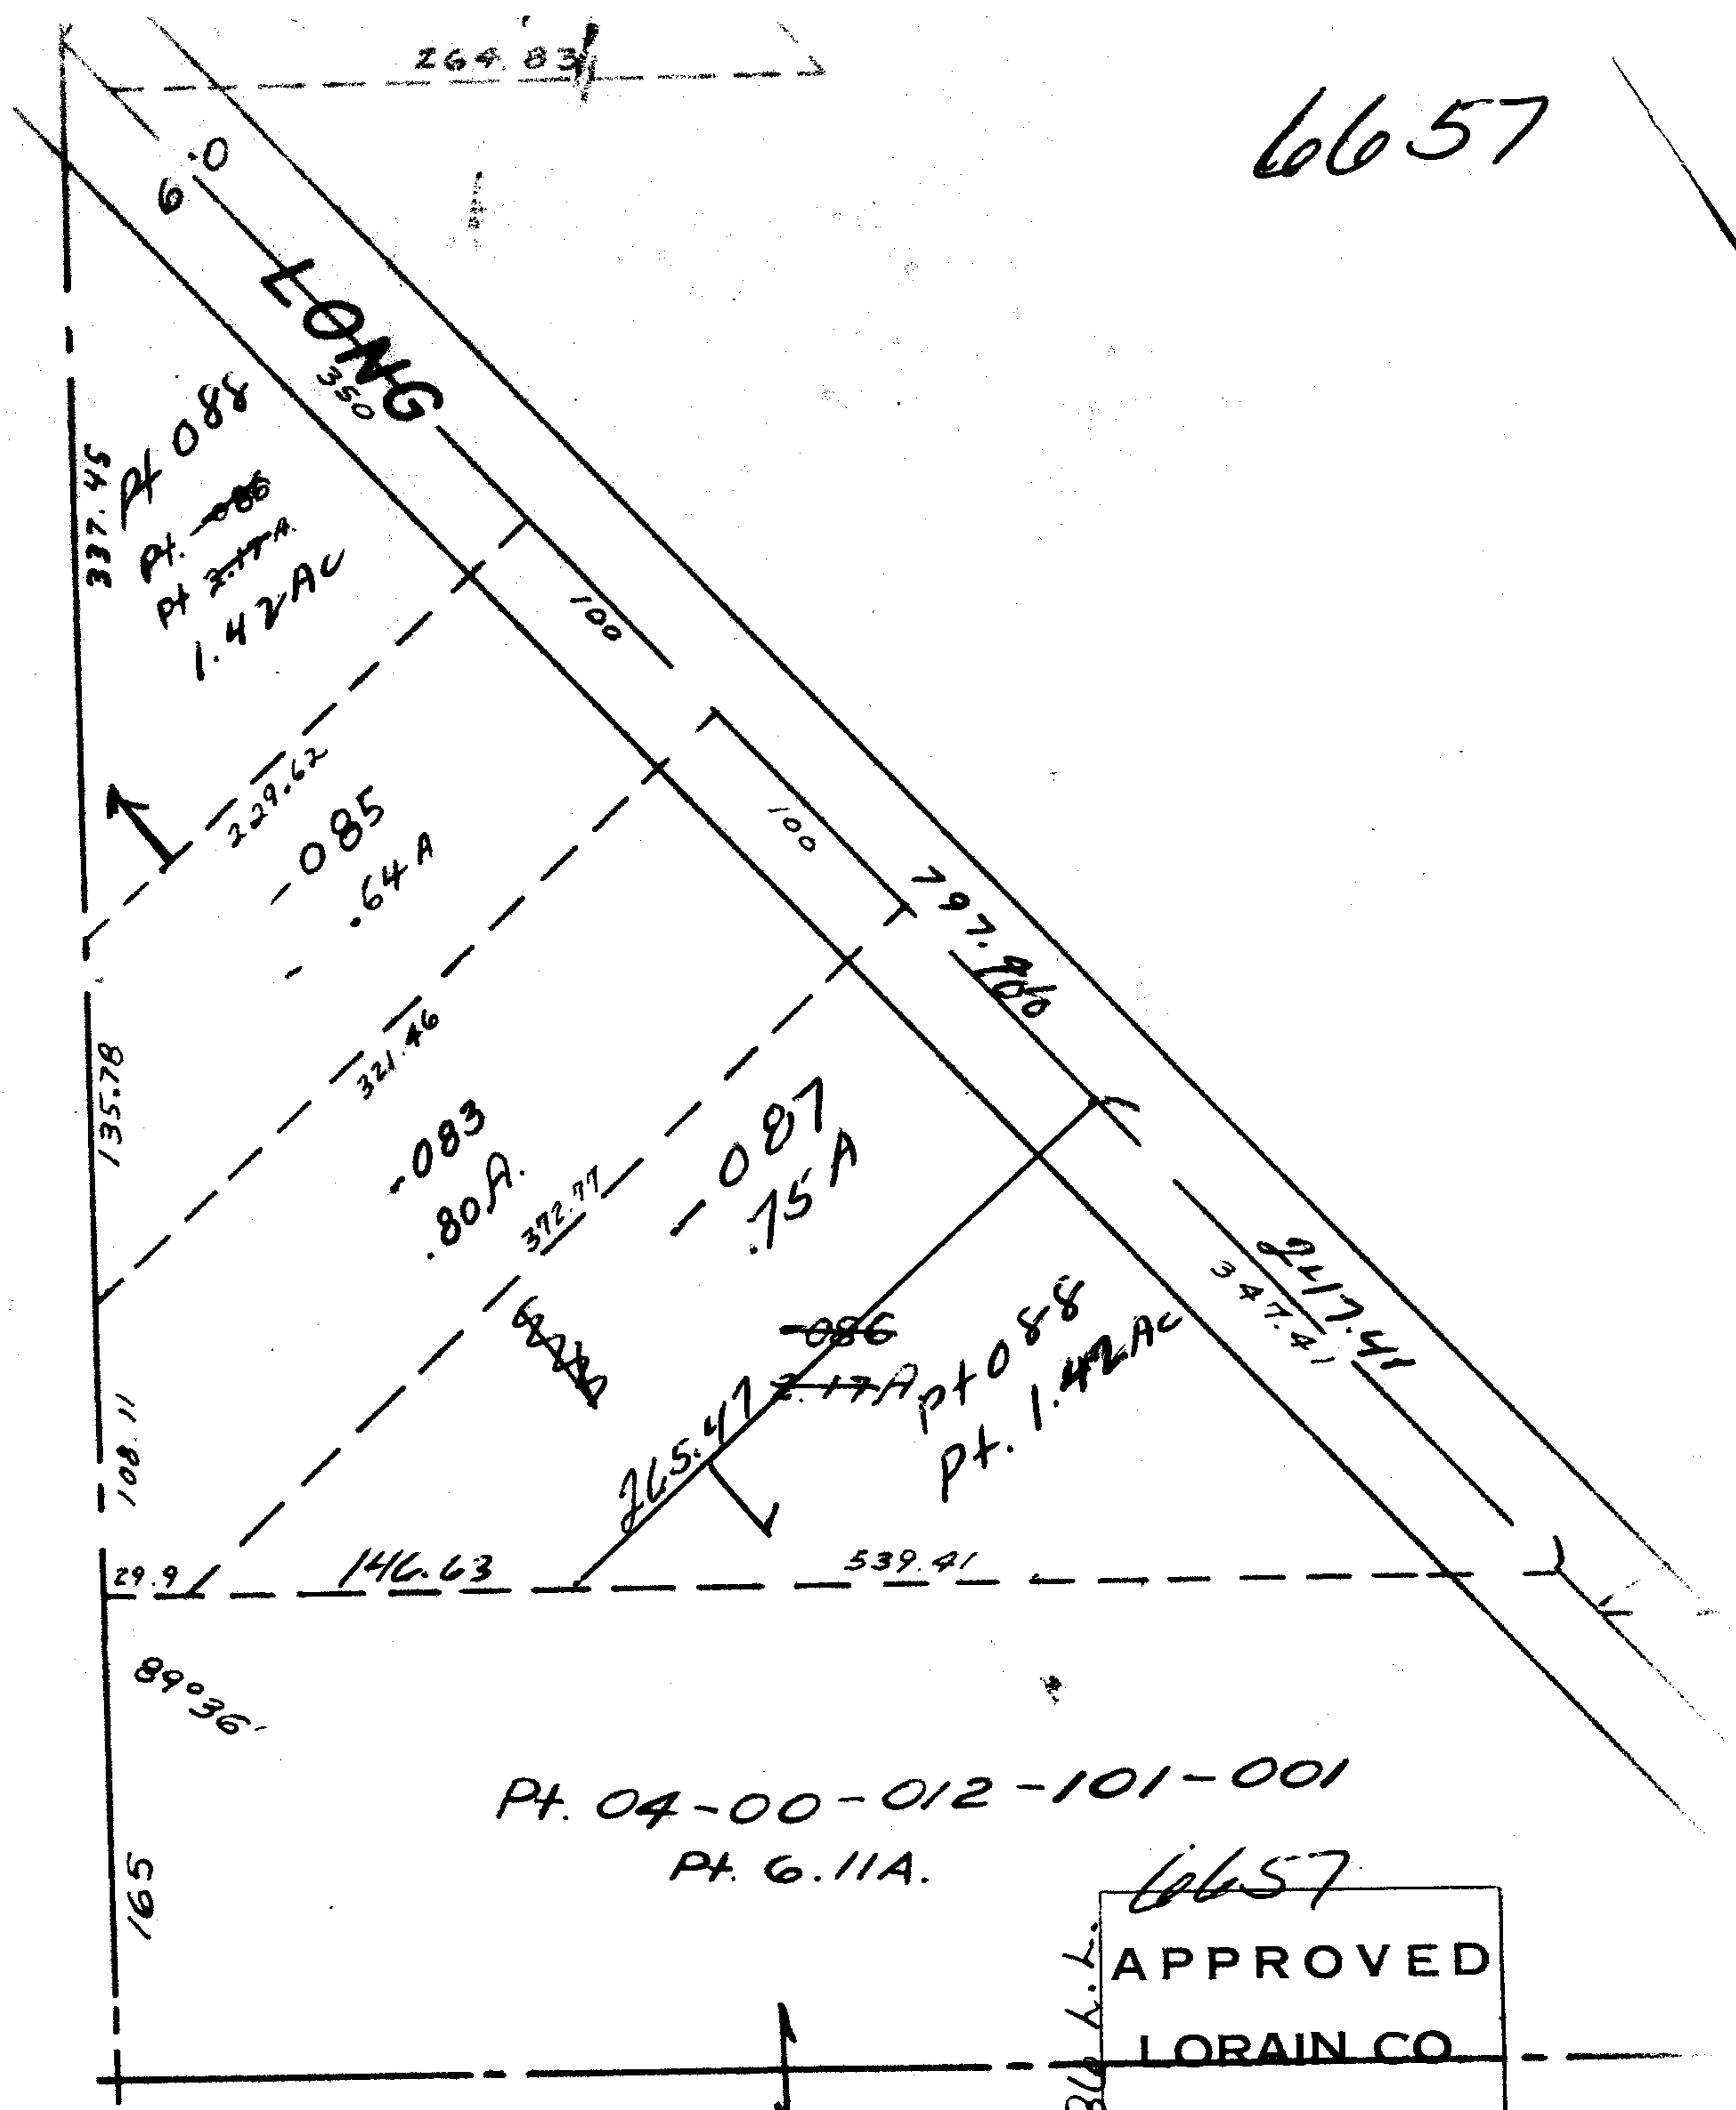

Pt. 04-00-012-101-001
 Pt. 6.11A.

6657
 APPROVED
 LORAIN CO.
 MAP DEPT.
 DATE 1-16-73
 4-00-011E
 BY L.W. Hall

AVON VILLAGE

SCALE: 1" = 100'

E