


6670



See # 6666

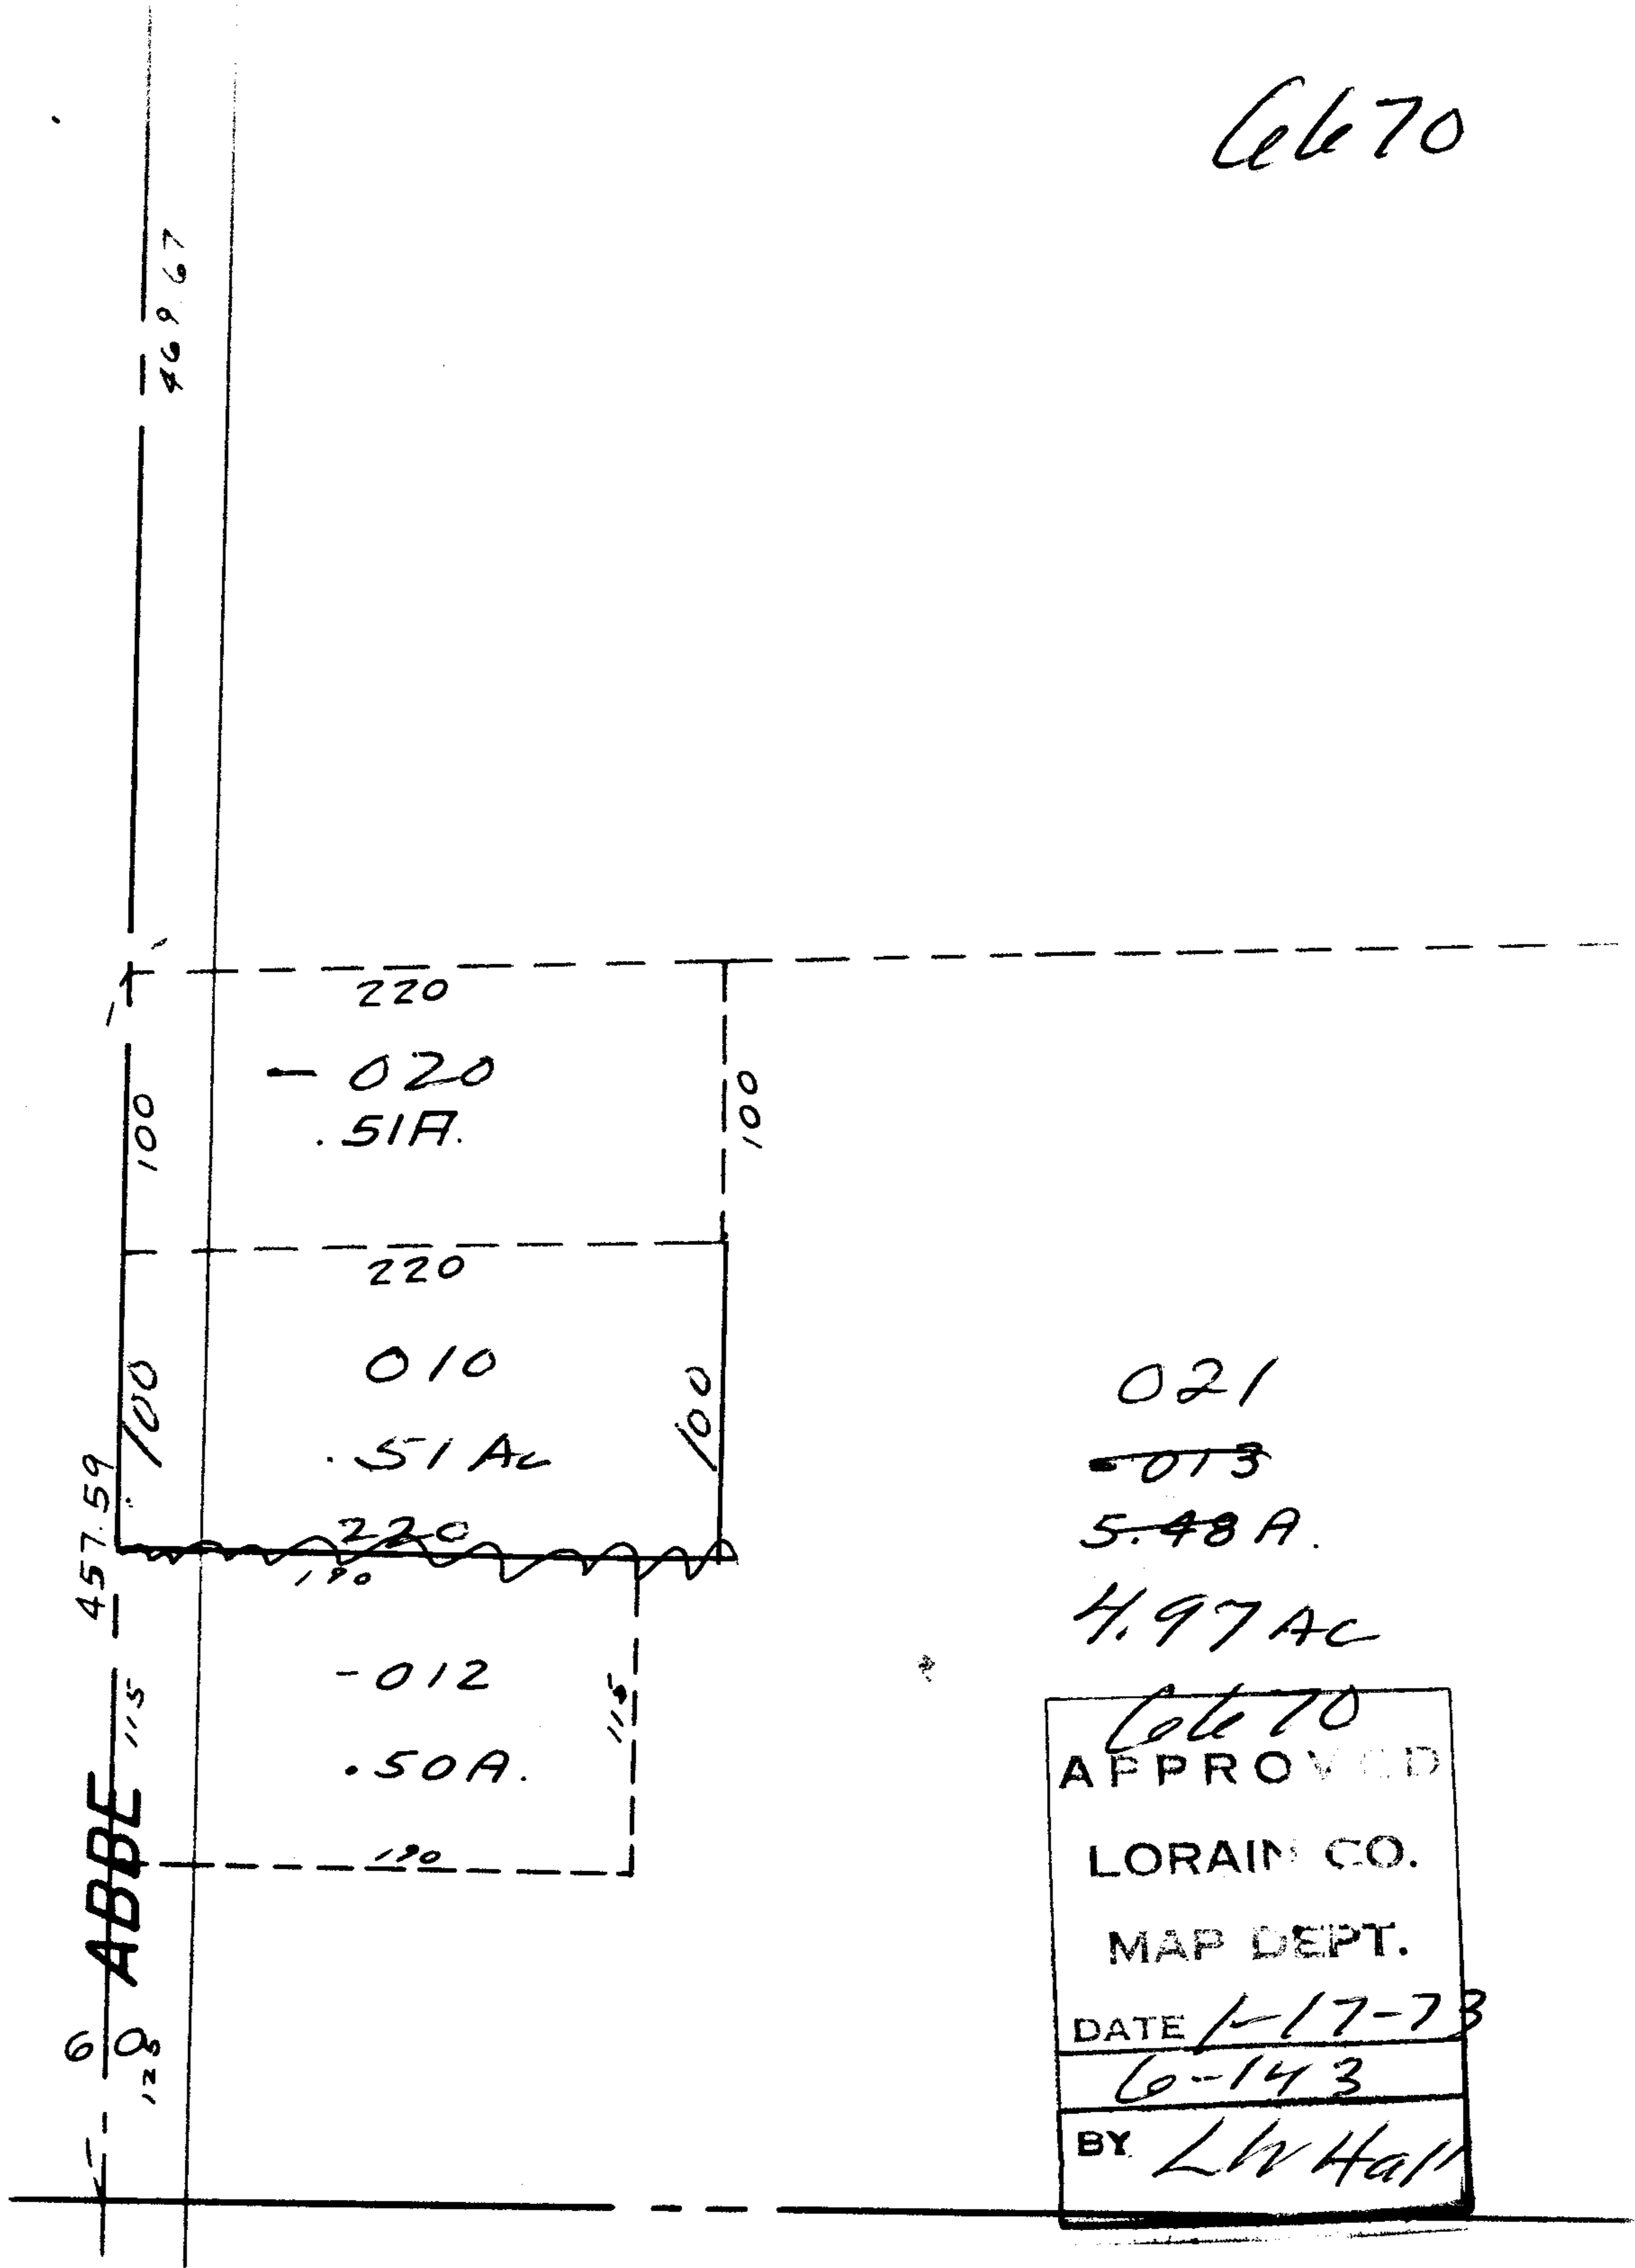

021  
~~013~~  
5.48 A.  
4.97 AC

6670	
APPROVED	
LORAIN CO.	
MAP DEPT.	
DATE	1-17-73
	6-143
BY	LW Hall

SEE

see also  
6666

# ELYRIA TWP.

SCALE: 1" = 100'