


6711

W.

8

438.15

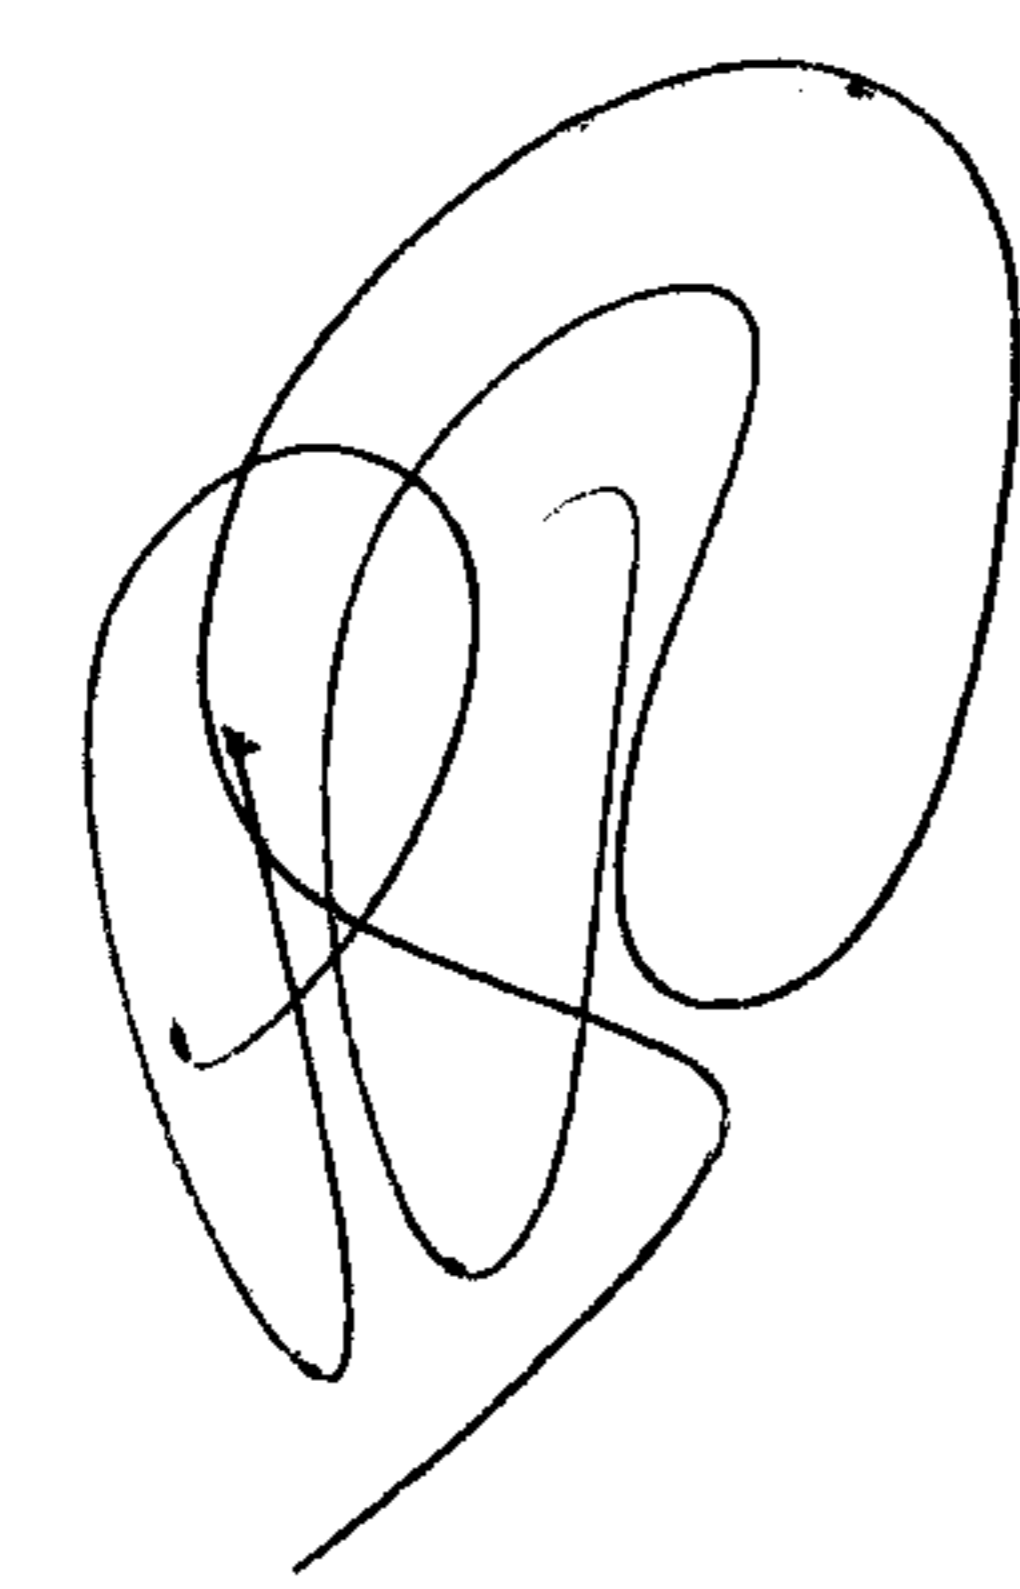

SE

L.

-006
3.70 A.

332.20

6711
 APPROX
 LORAIN
 MAP D.
 DATE 2-9-73
 6-20
 BY L.V. Hall

239.93
Z-035 1.65 AC

Z-028 AC

169.10
342.2

508.29

~~0.84 A.~~
-033
56 A.

210.20

.28
 $\frac{2.27}{2.55}$
 $\frac{1.65}{90}$

266
-003
0.49 A.
266.26607

-036
~~004~~
2.27 A.
.90 AC

512.70

-018
1.22 A.

514.74

-019

50

80

DELLEFIELD

98

103.60

7

15

94.88

108

"

"

6-20