


18A

6717

-004  
76.35 F.

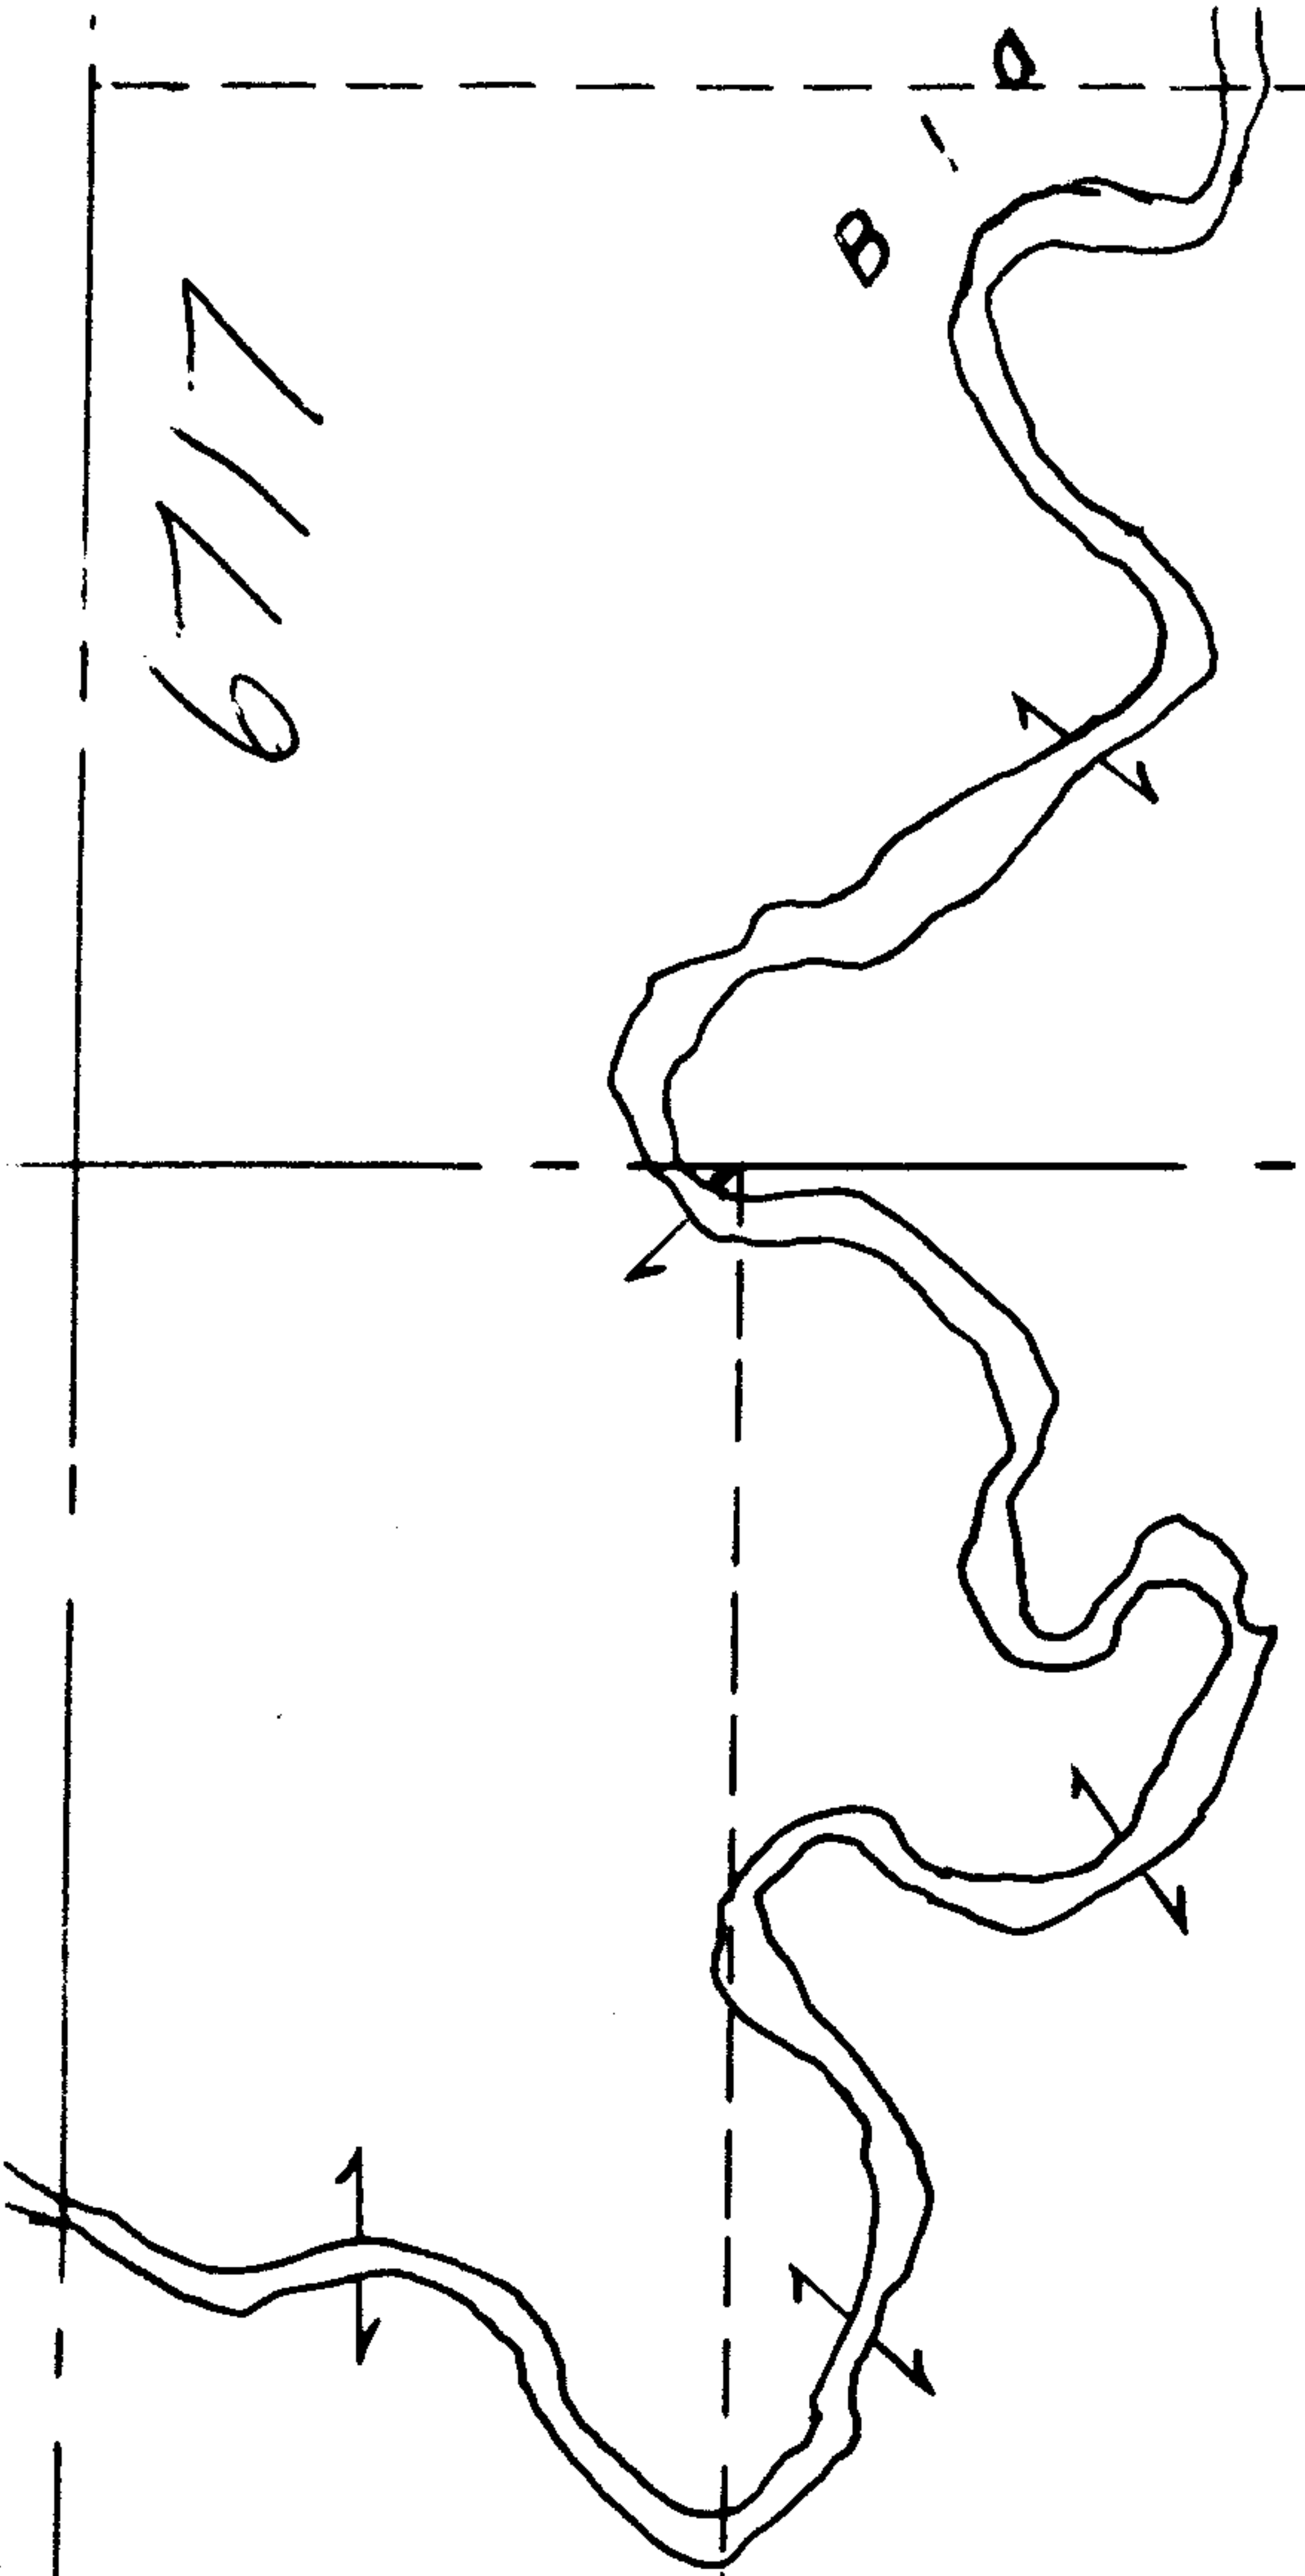

**6717**

**APPROVED**  
**LORAIN CO.**  
**MAP DEPT.**  
**DATE 2-8-73**  
 18-A  
**BY** *Hollert*

-010  
~~-004~~  
~~67.76.7~~  
 64.76 Ac.

*62.15 2.17.8*

653.49
-009 3.00 Ac.
653.49


-001  
50.50 F.

-002  
48.00 F.

675

358.42

40

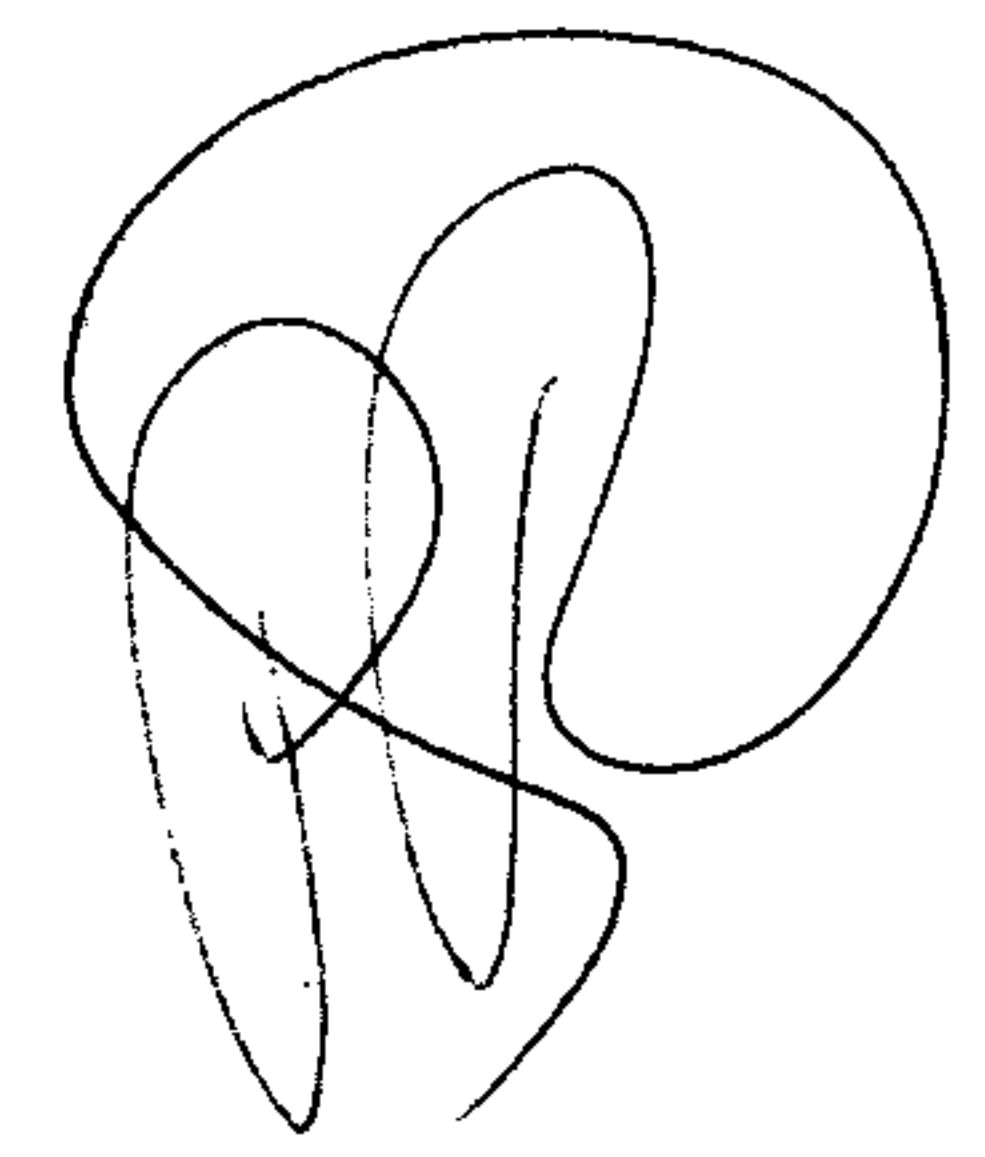

216.48

184.8 80288

5 F.

F.