

5736

848.80 2295.88 3117.87
783.42 1980.97 2349.60

- 001
31.88 R.

6736
APPROVED
LORAIN CO.
MAP DEPT.
DATE 2-20-73
BY L. W. [Signature]

- 002
70.72 A.


68

7-798-88-6

1963.50

- 003
15.50 A.

1859.88

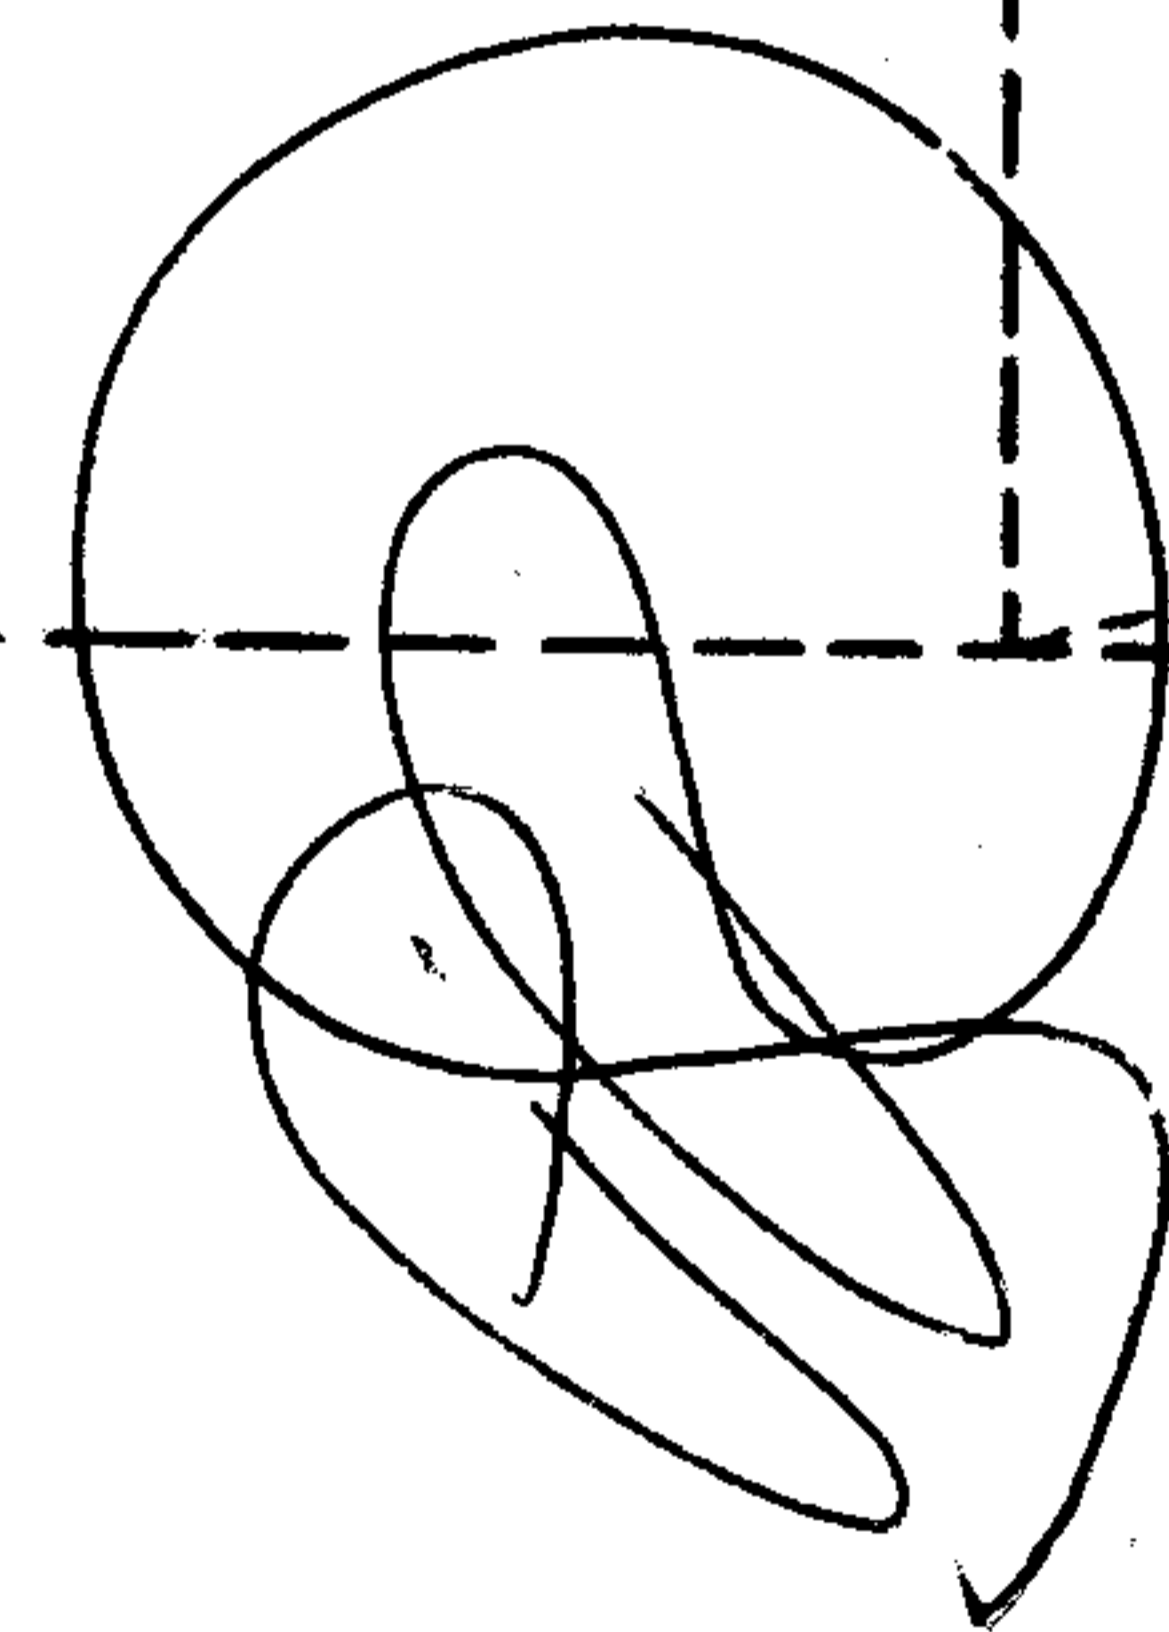

007
~~- 004~~
50.00 A.
1/5.00 Ac

600
006
5.00 Ac
RD.

WHITNEY

2405.10

934.5

1534.7

600

- 002
25.43 A.

781
291.68
30 A.

- 003
5.00 A.

15 A

- 016 2.98 A.

- 017 3.28 A.

252.40

1412.67

822.36

486.42

146.52

