

6743

Wakeman Belden Rd

RD.

(60?)

303

ST RT 303


-002
14.45 A.

RD. 663.90

(60)

-001
100.51 A.

58

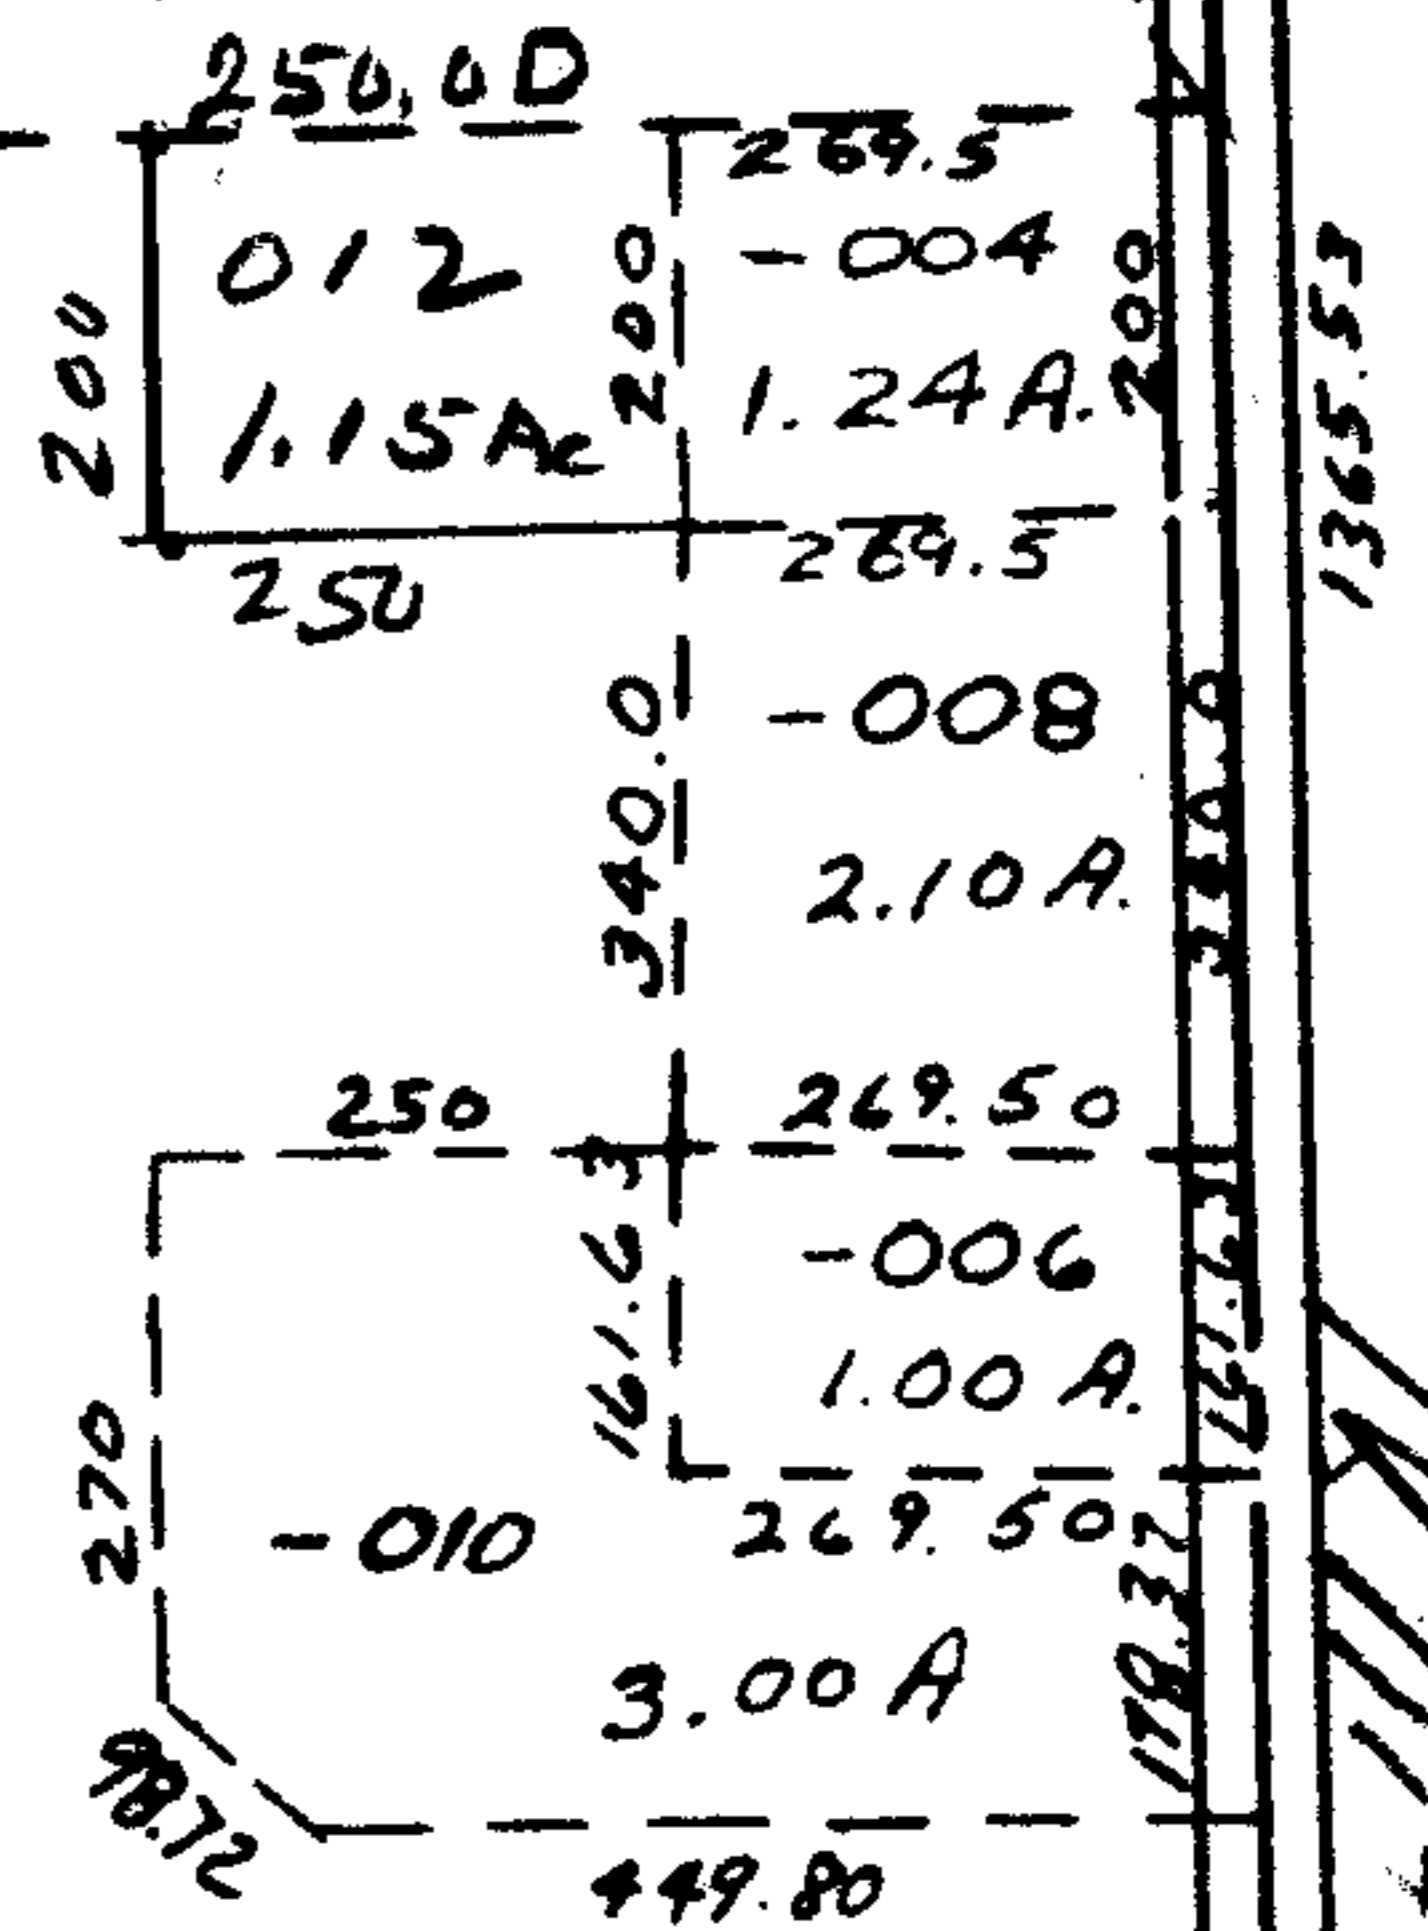

7-28-86
 6743
 APPROVED
 2-23-73
 15E
 L V Hall

013
~~011~~
36.66 A.
35.51

Whitehead Rd

-001
10.00 A.

-002
6.00 A.

-003
50.57 A. DUP.
50.75 A. MAP

70

496

895