


6765

6765
APPROVED
LORAIN CO.
MAP DEPT.
DATE 2-28-73
01-00-002D
BY L W Hall

-004
3.50A.

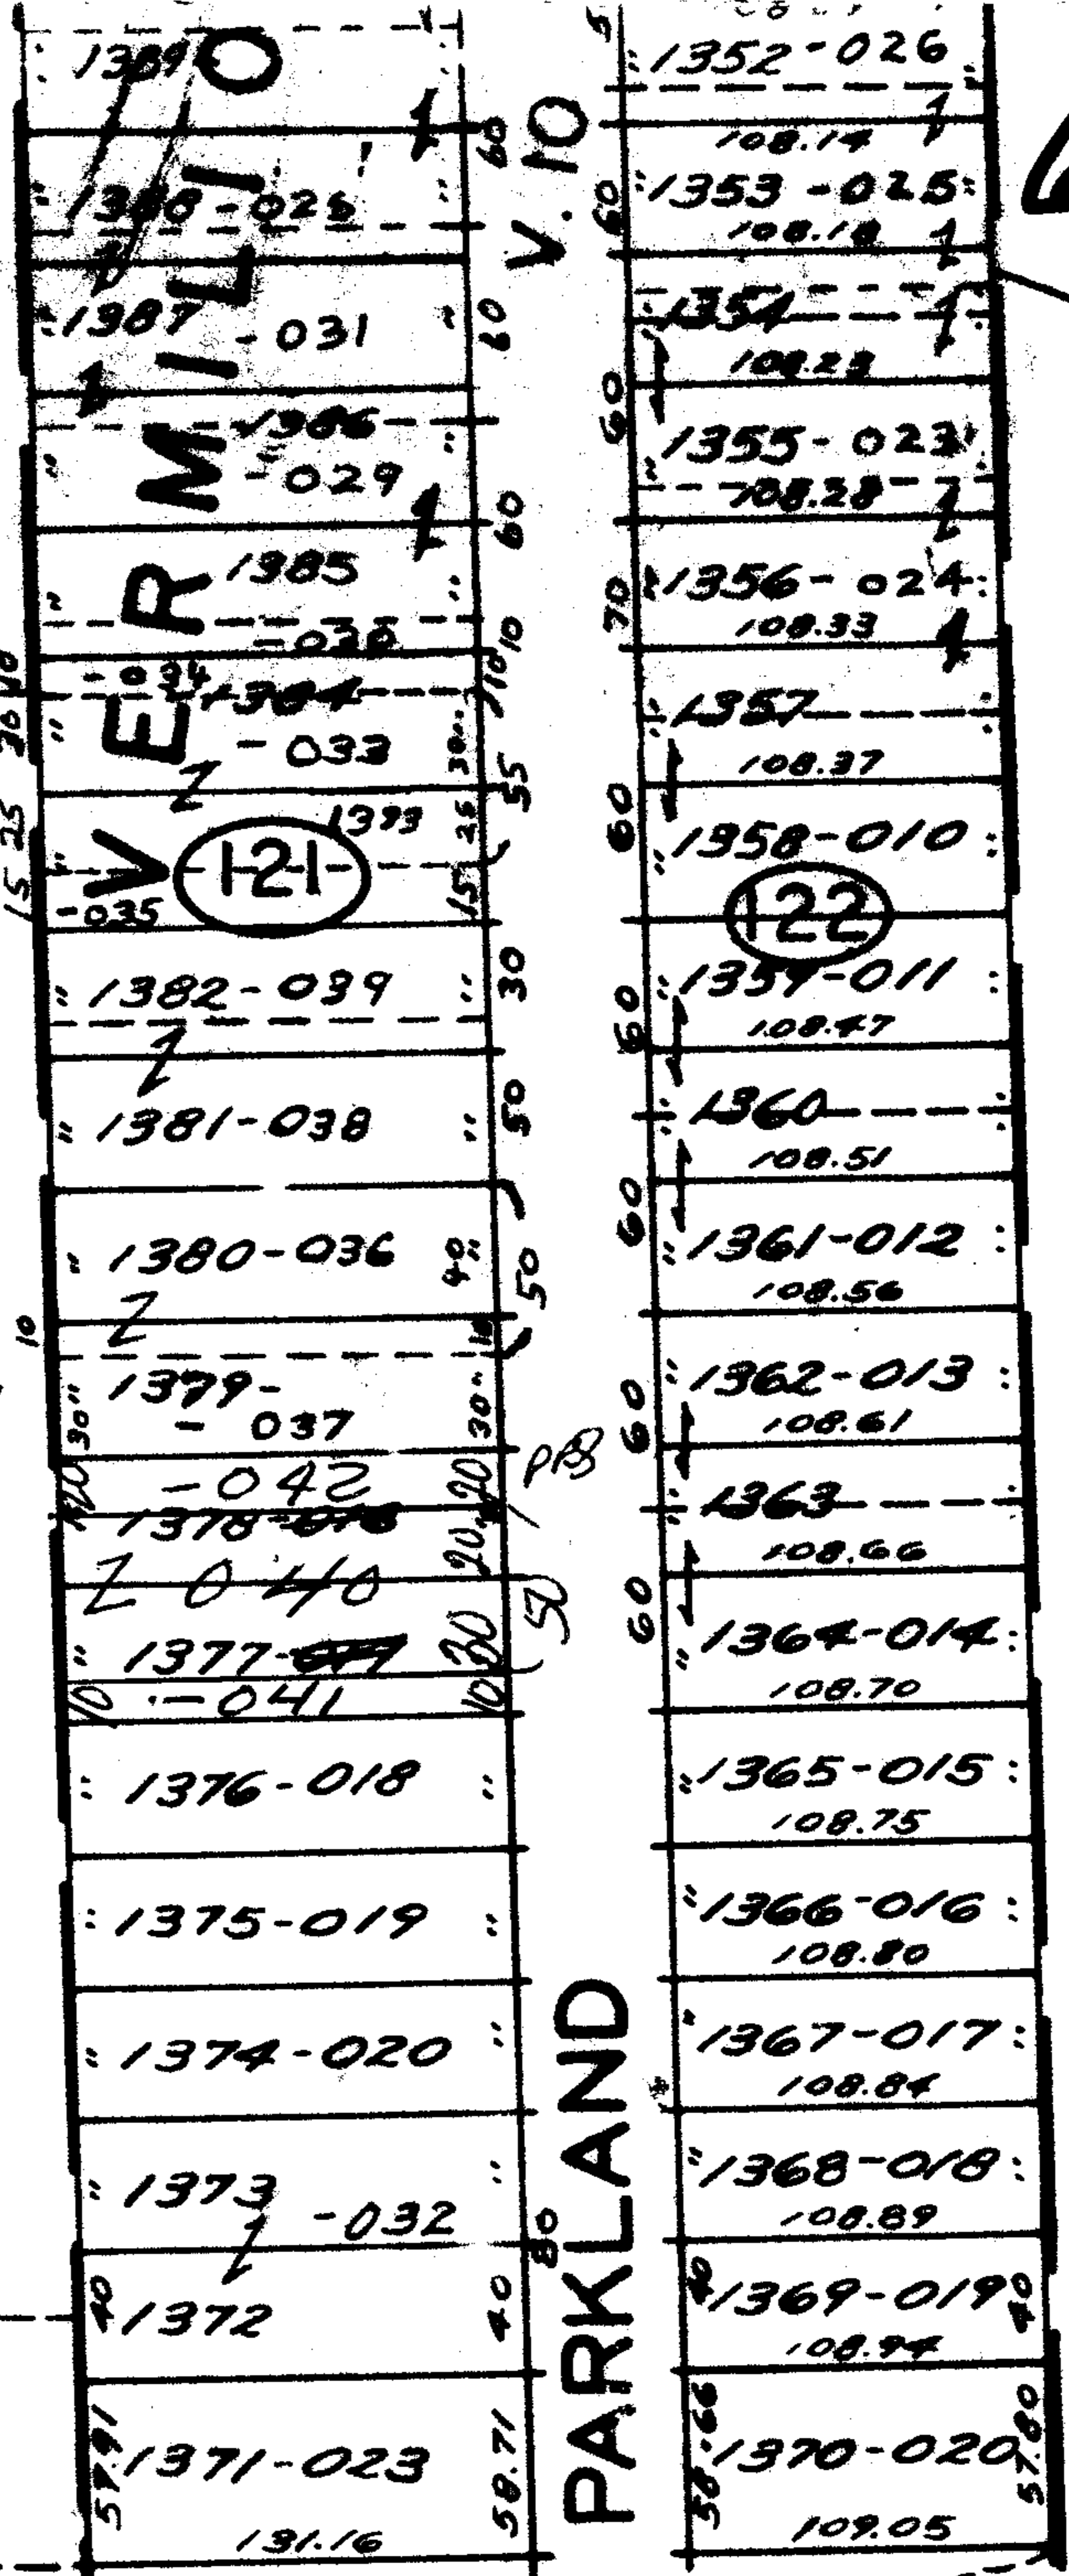

945

Pt. BOYNTON ROAD VAC. 421.16
-006 29A.

BOYNTON RD.

SEE 1-A

1-00-002D

OWNHELM

TWP.

C-M-OK

= 100'

SE P