

6780


929.5

Separation
For Tax Purpose

SDAC

2113560
21780

9.60
50
910

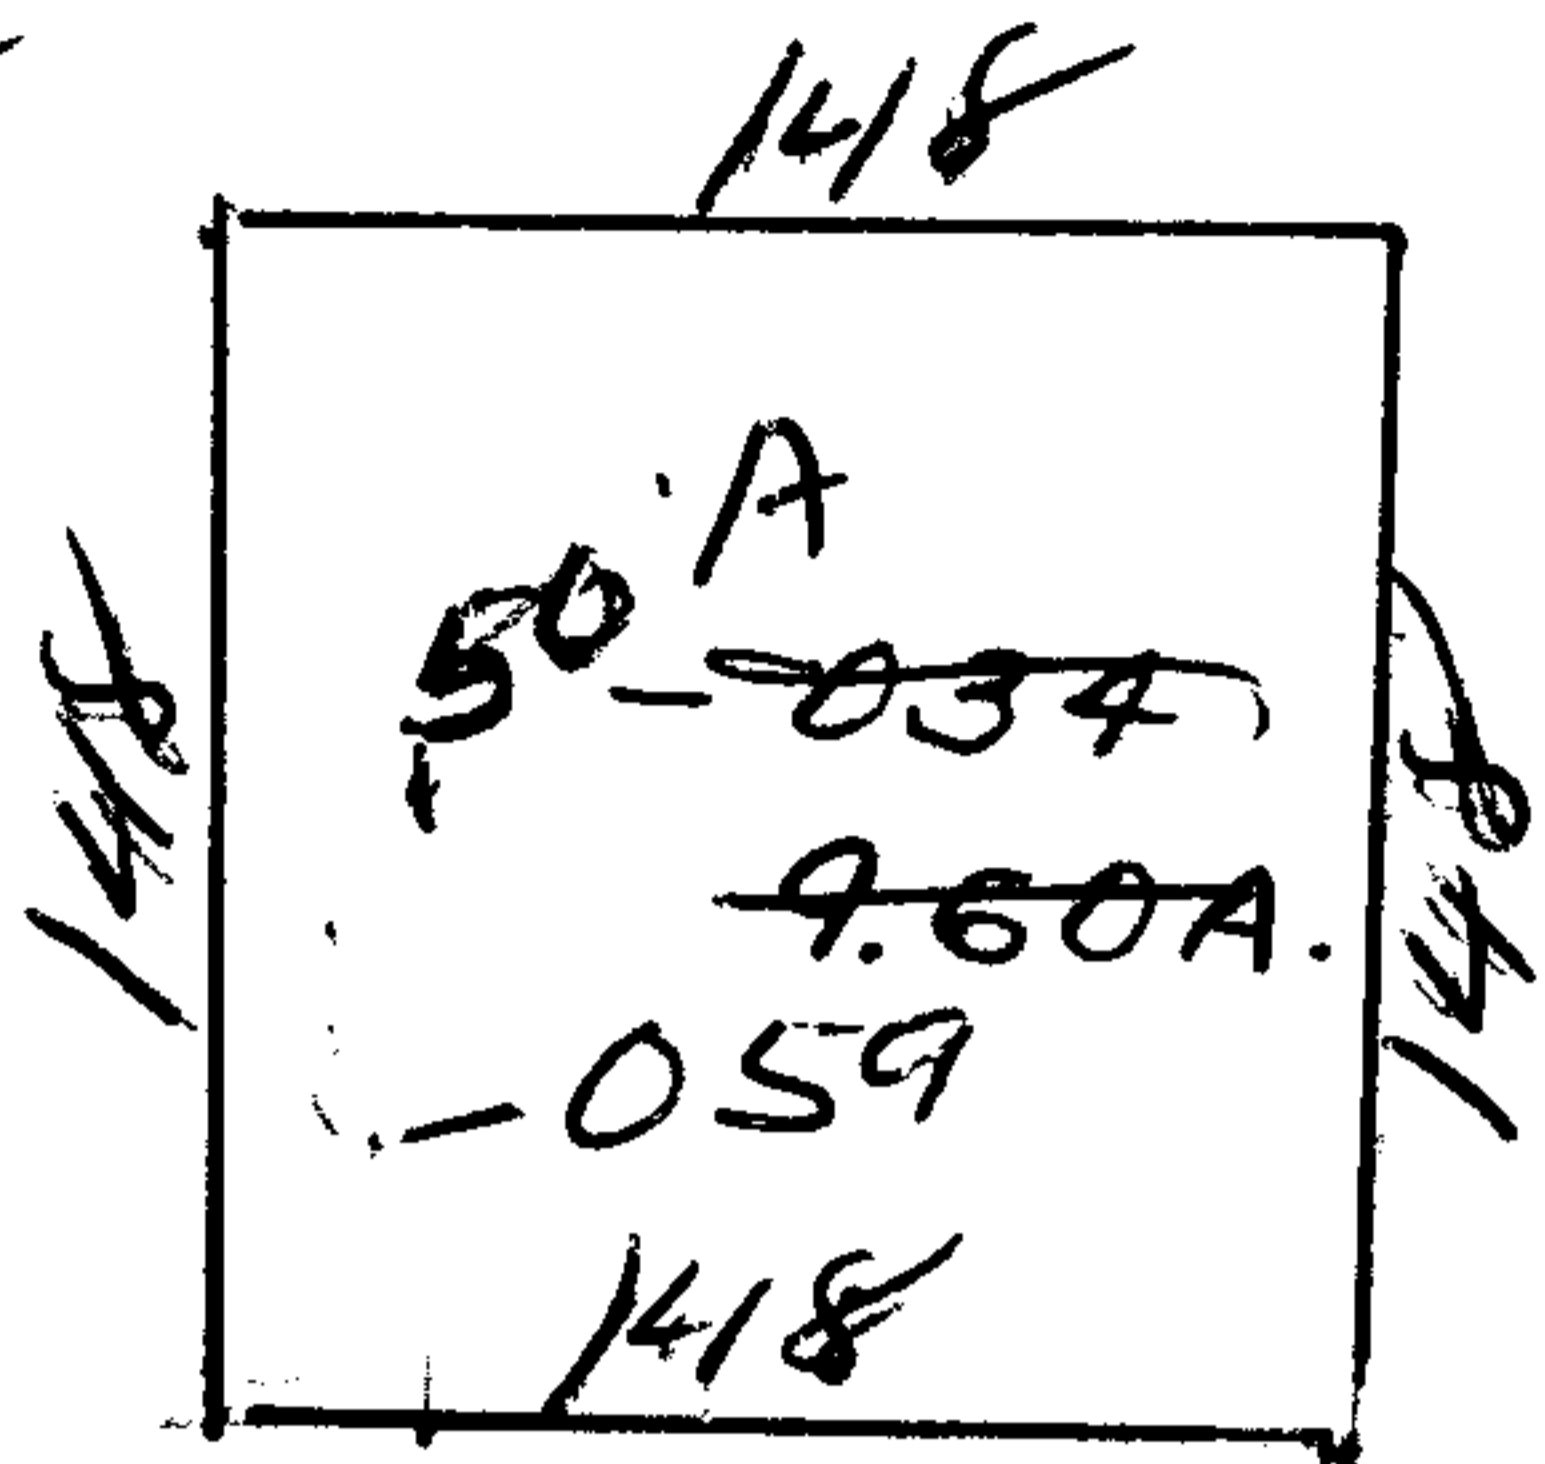

200
148
148
21964
113560
503
24
288
108
21750
1600
148
2204

APPROVED
LORAIN C
MAP D.
DATE 3-7-73
4-00-019L
BY LWHall

-060
9.10Ac


203

889.80

470.14

CM-OK

LEAR-NAGLE

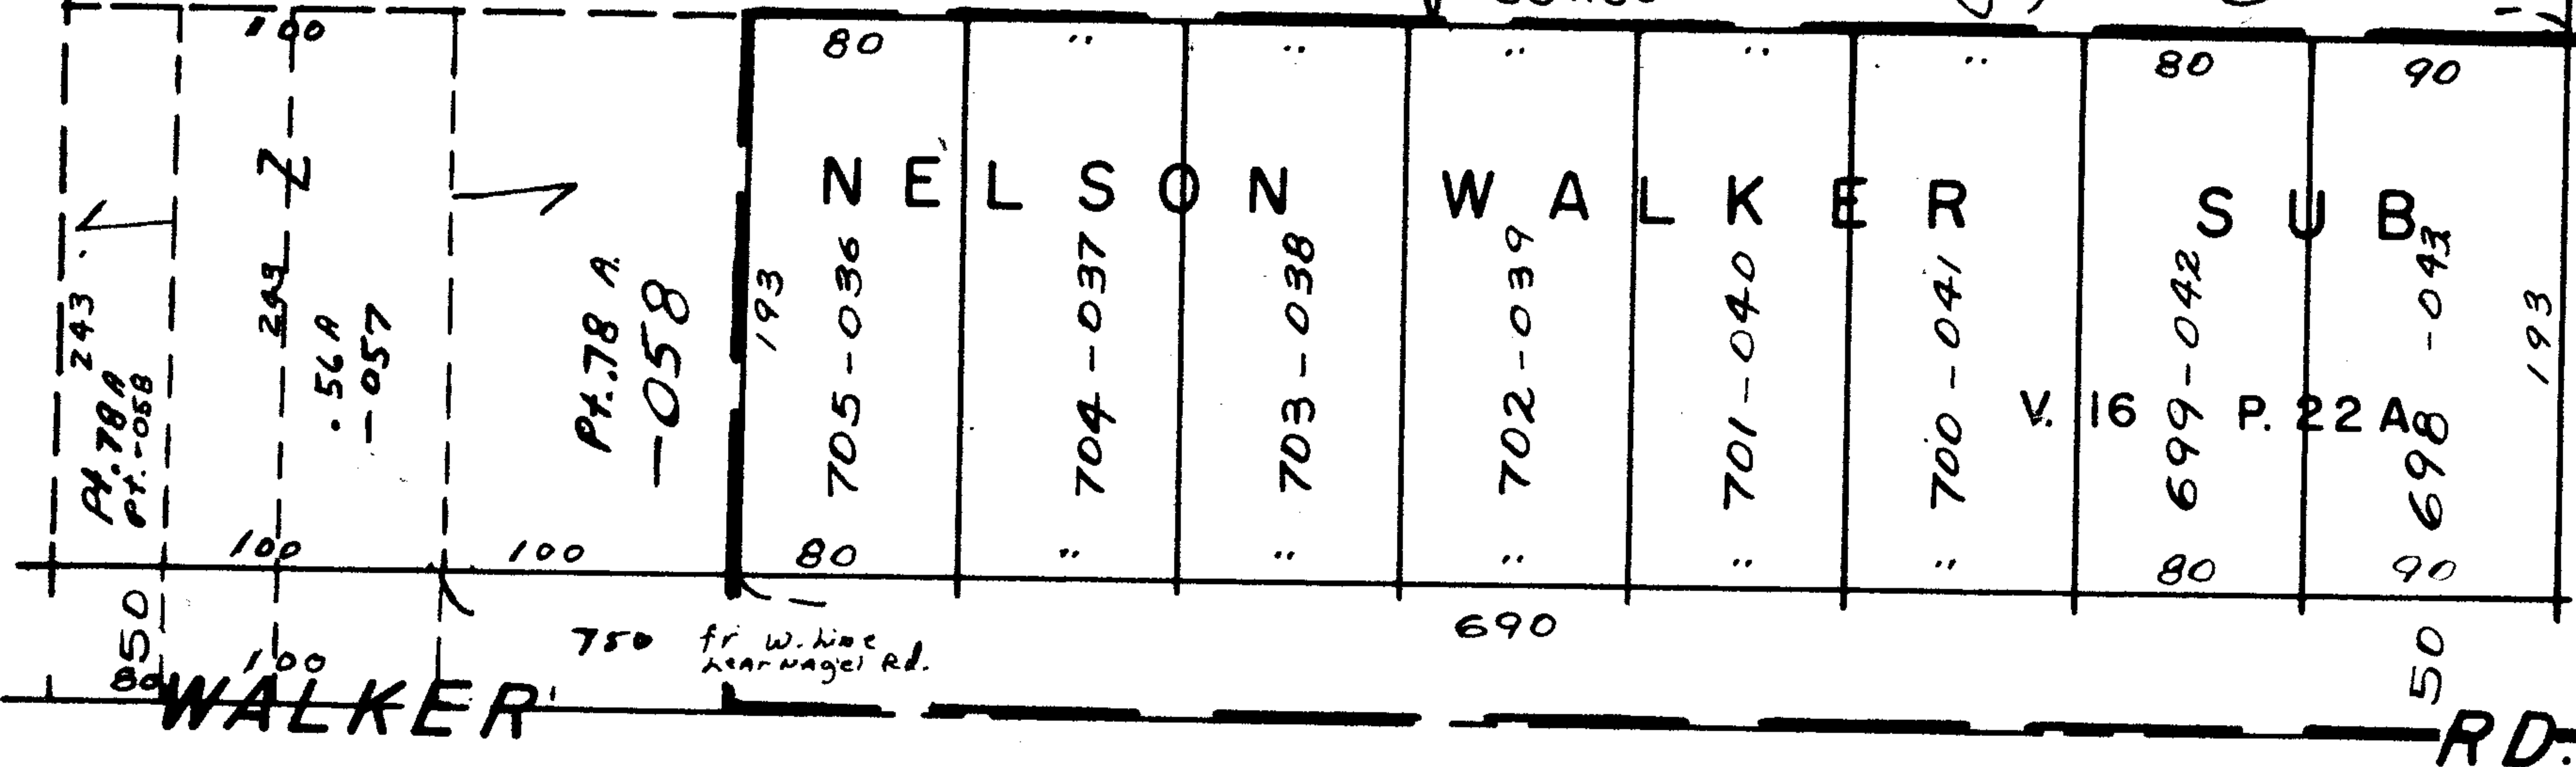

SEE 4-C