

6797

6797
APPROVED
LORAIN CO.
MAP DEPT.
DATE 3-12-73
11-00-077B
BY L W Hall

11-00-077-000-064


45.10 066

44.64 AC

PRS

D. S.

7-24-86

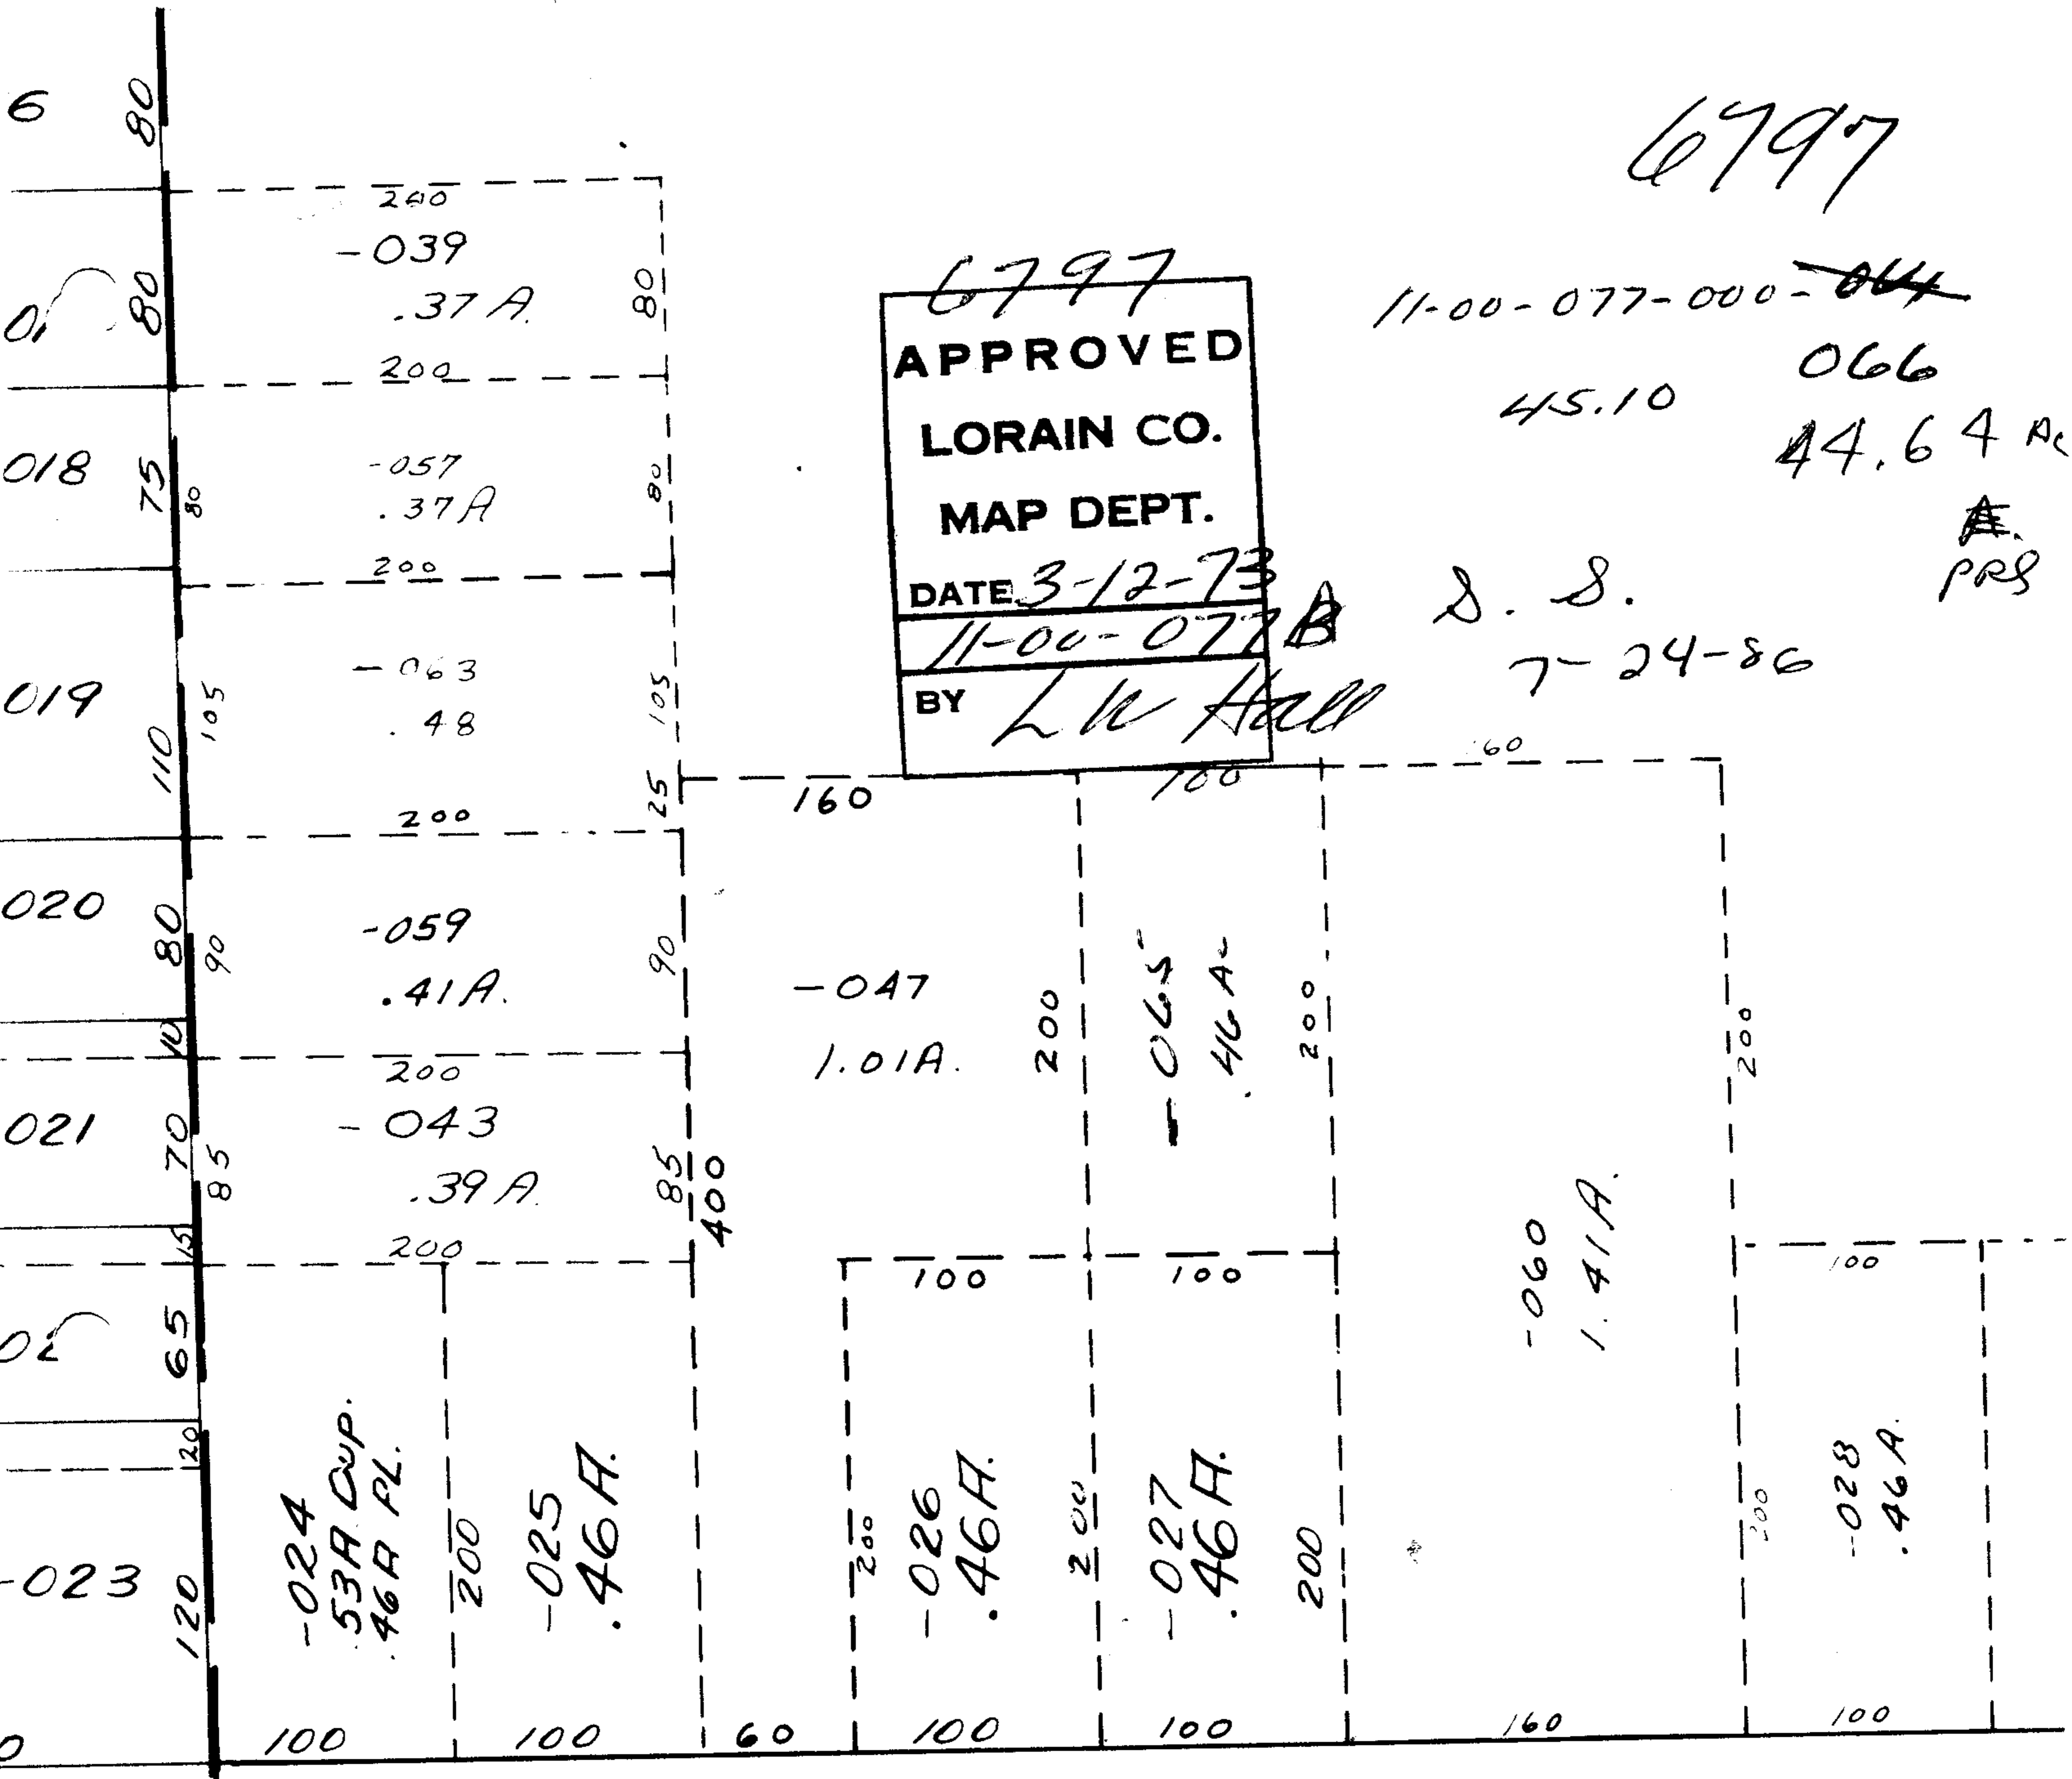

CAPEL

SEE II

C-M-OK

11-00-077B

PRS

EATON TWP.

SCALE: 1" = 100'