


6801

C-M-OK

SFR 830476

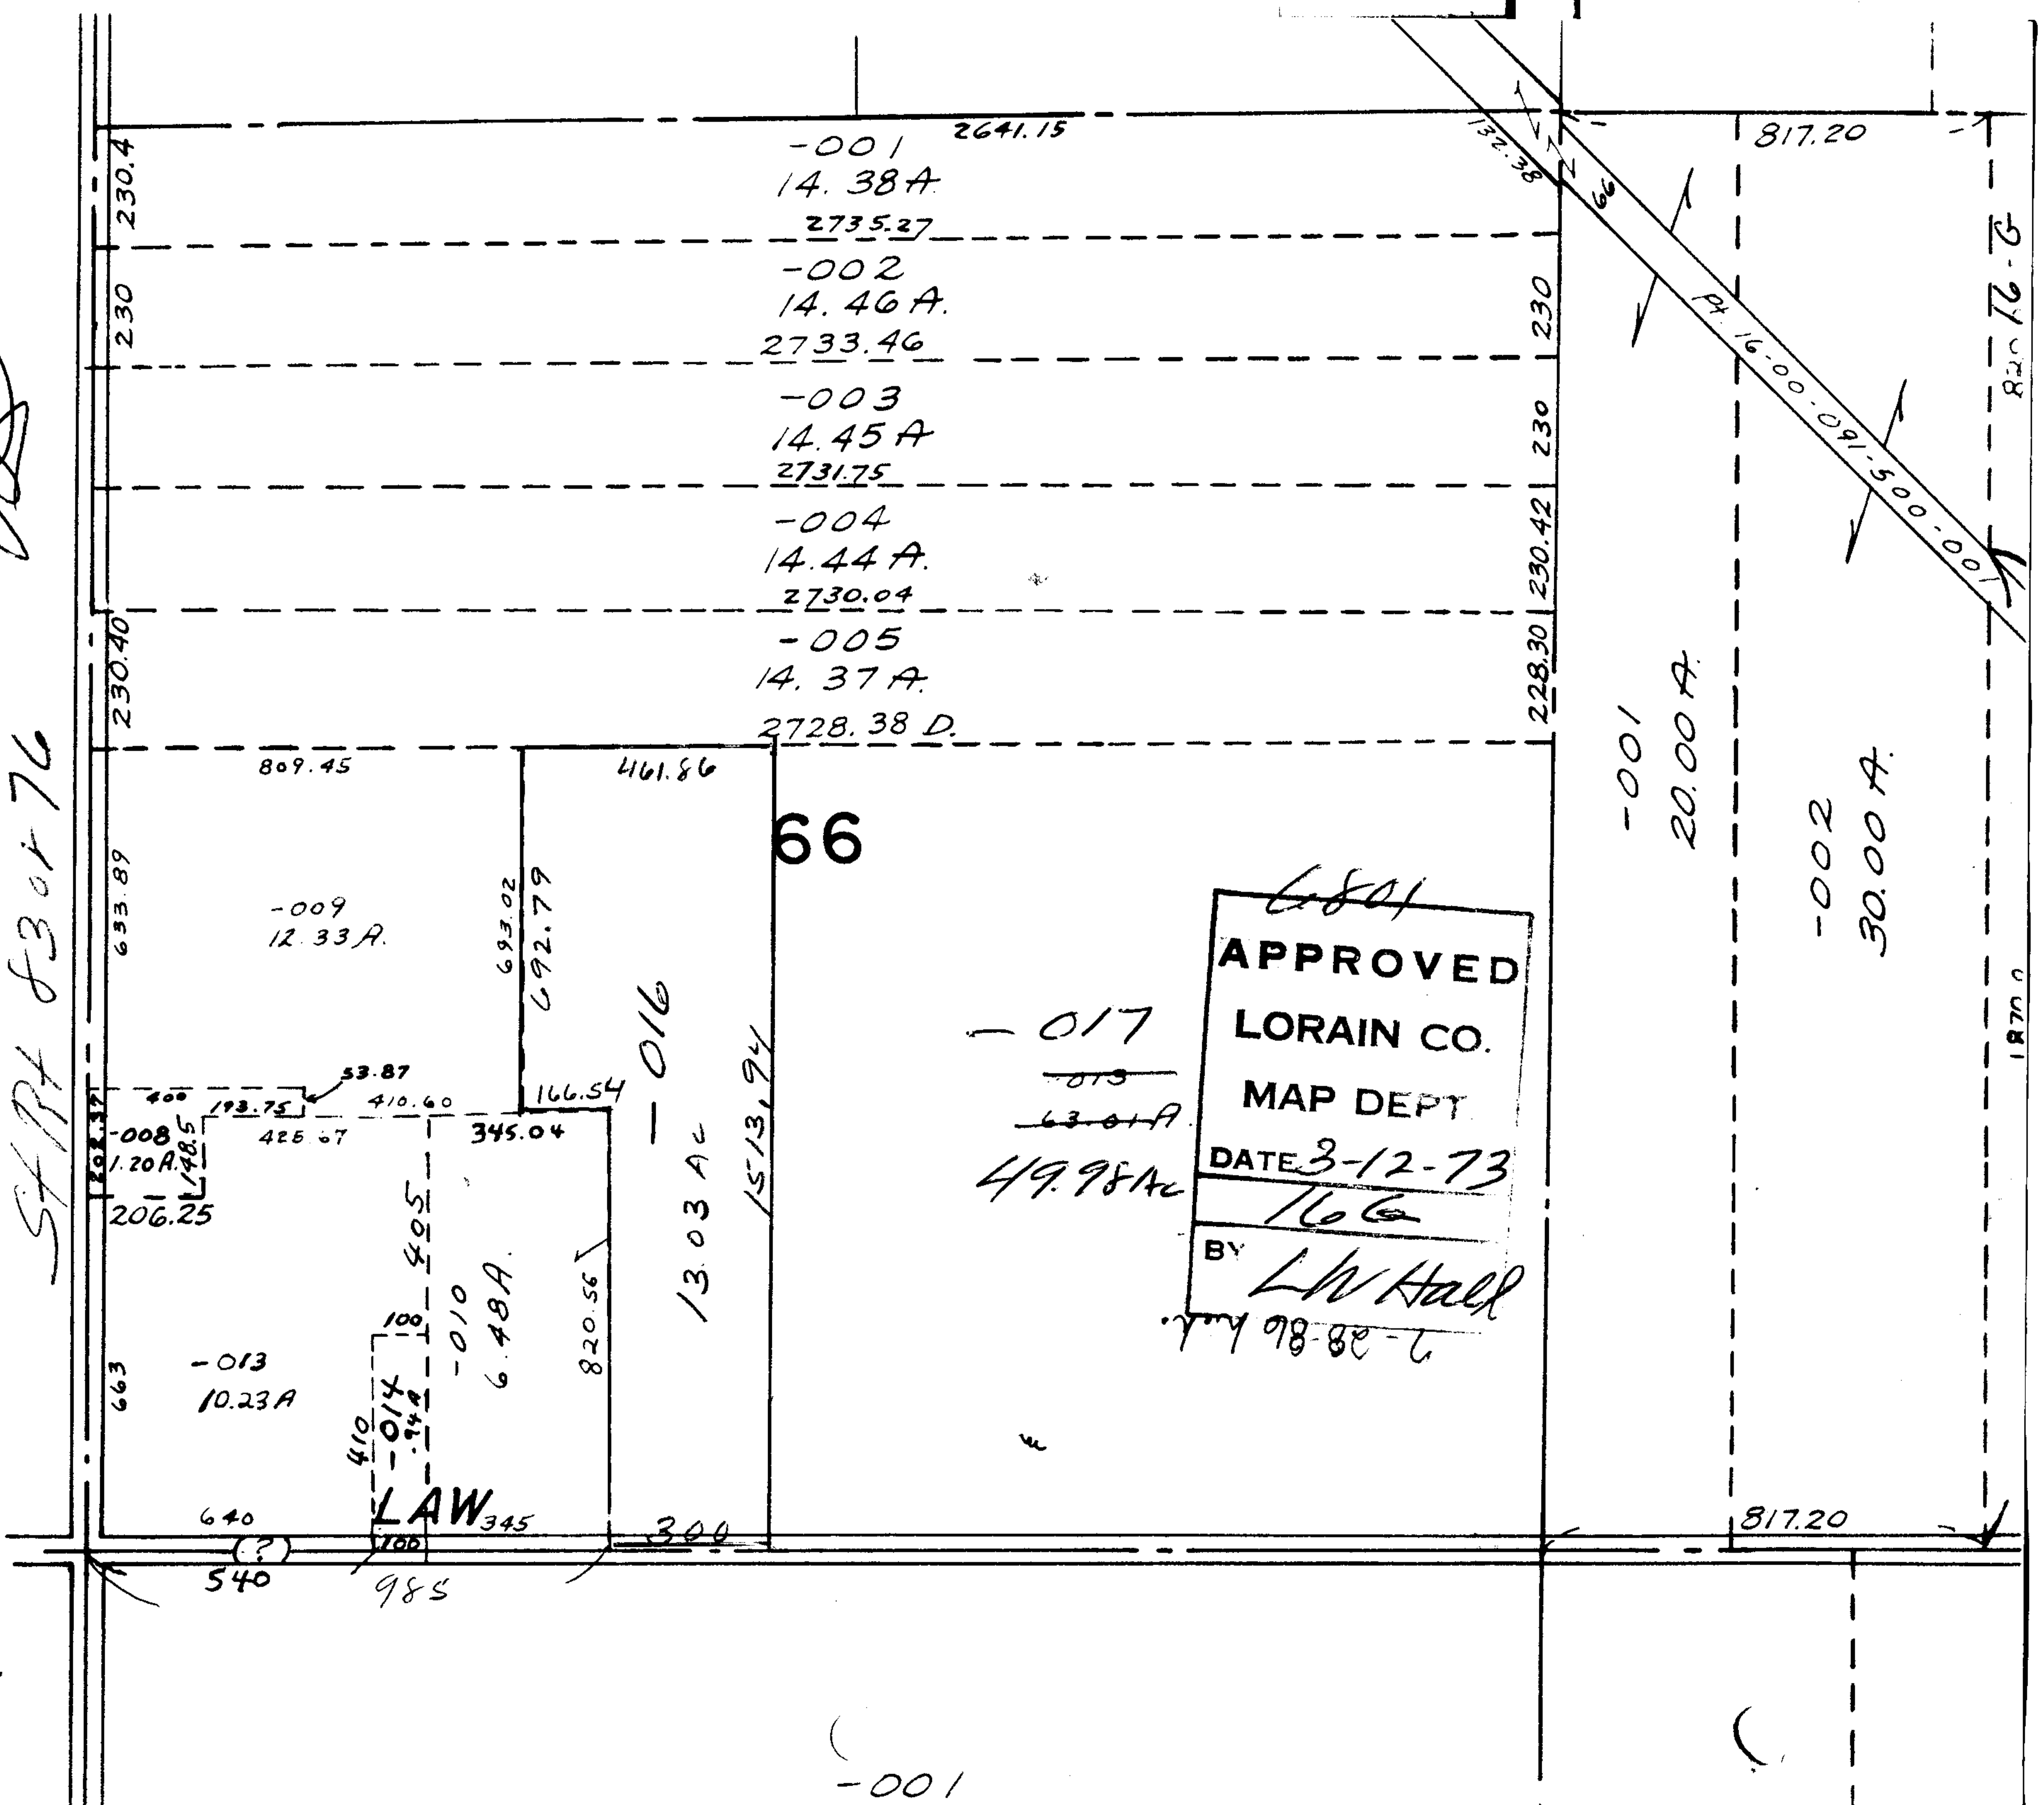

-001 2641.15
14.38 A.
2735.27

-002
14.46 A.
2733.46

-003
14.45 A.
2731.75

-004
14.44 A.
2730.04

-005
14.37 A.
2728.38 D.

-009
12.33 A.

-008
12.20 A.
206.25

193.75
425.67
53.87
410.60

-013
10.23 A

-014
100
410
100
405
LAW
345

-010
6.48 A.

-016
13.03 AC

1513.94

-017
~~015~~
~~63.01 A~~
49.98 AC

6801
APPROVED
LORAIN CO.
MAP DEPT.
DATE 3-12-73
166
BY L.W. Hall
7-28-86 L.W.H.

-001
20.00 A.

-002
30.00 A.

-001

18700

82076-6