



C-111-011 6802

RD.

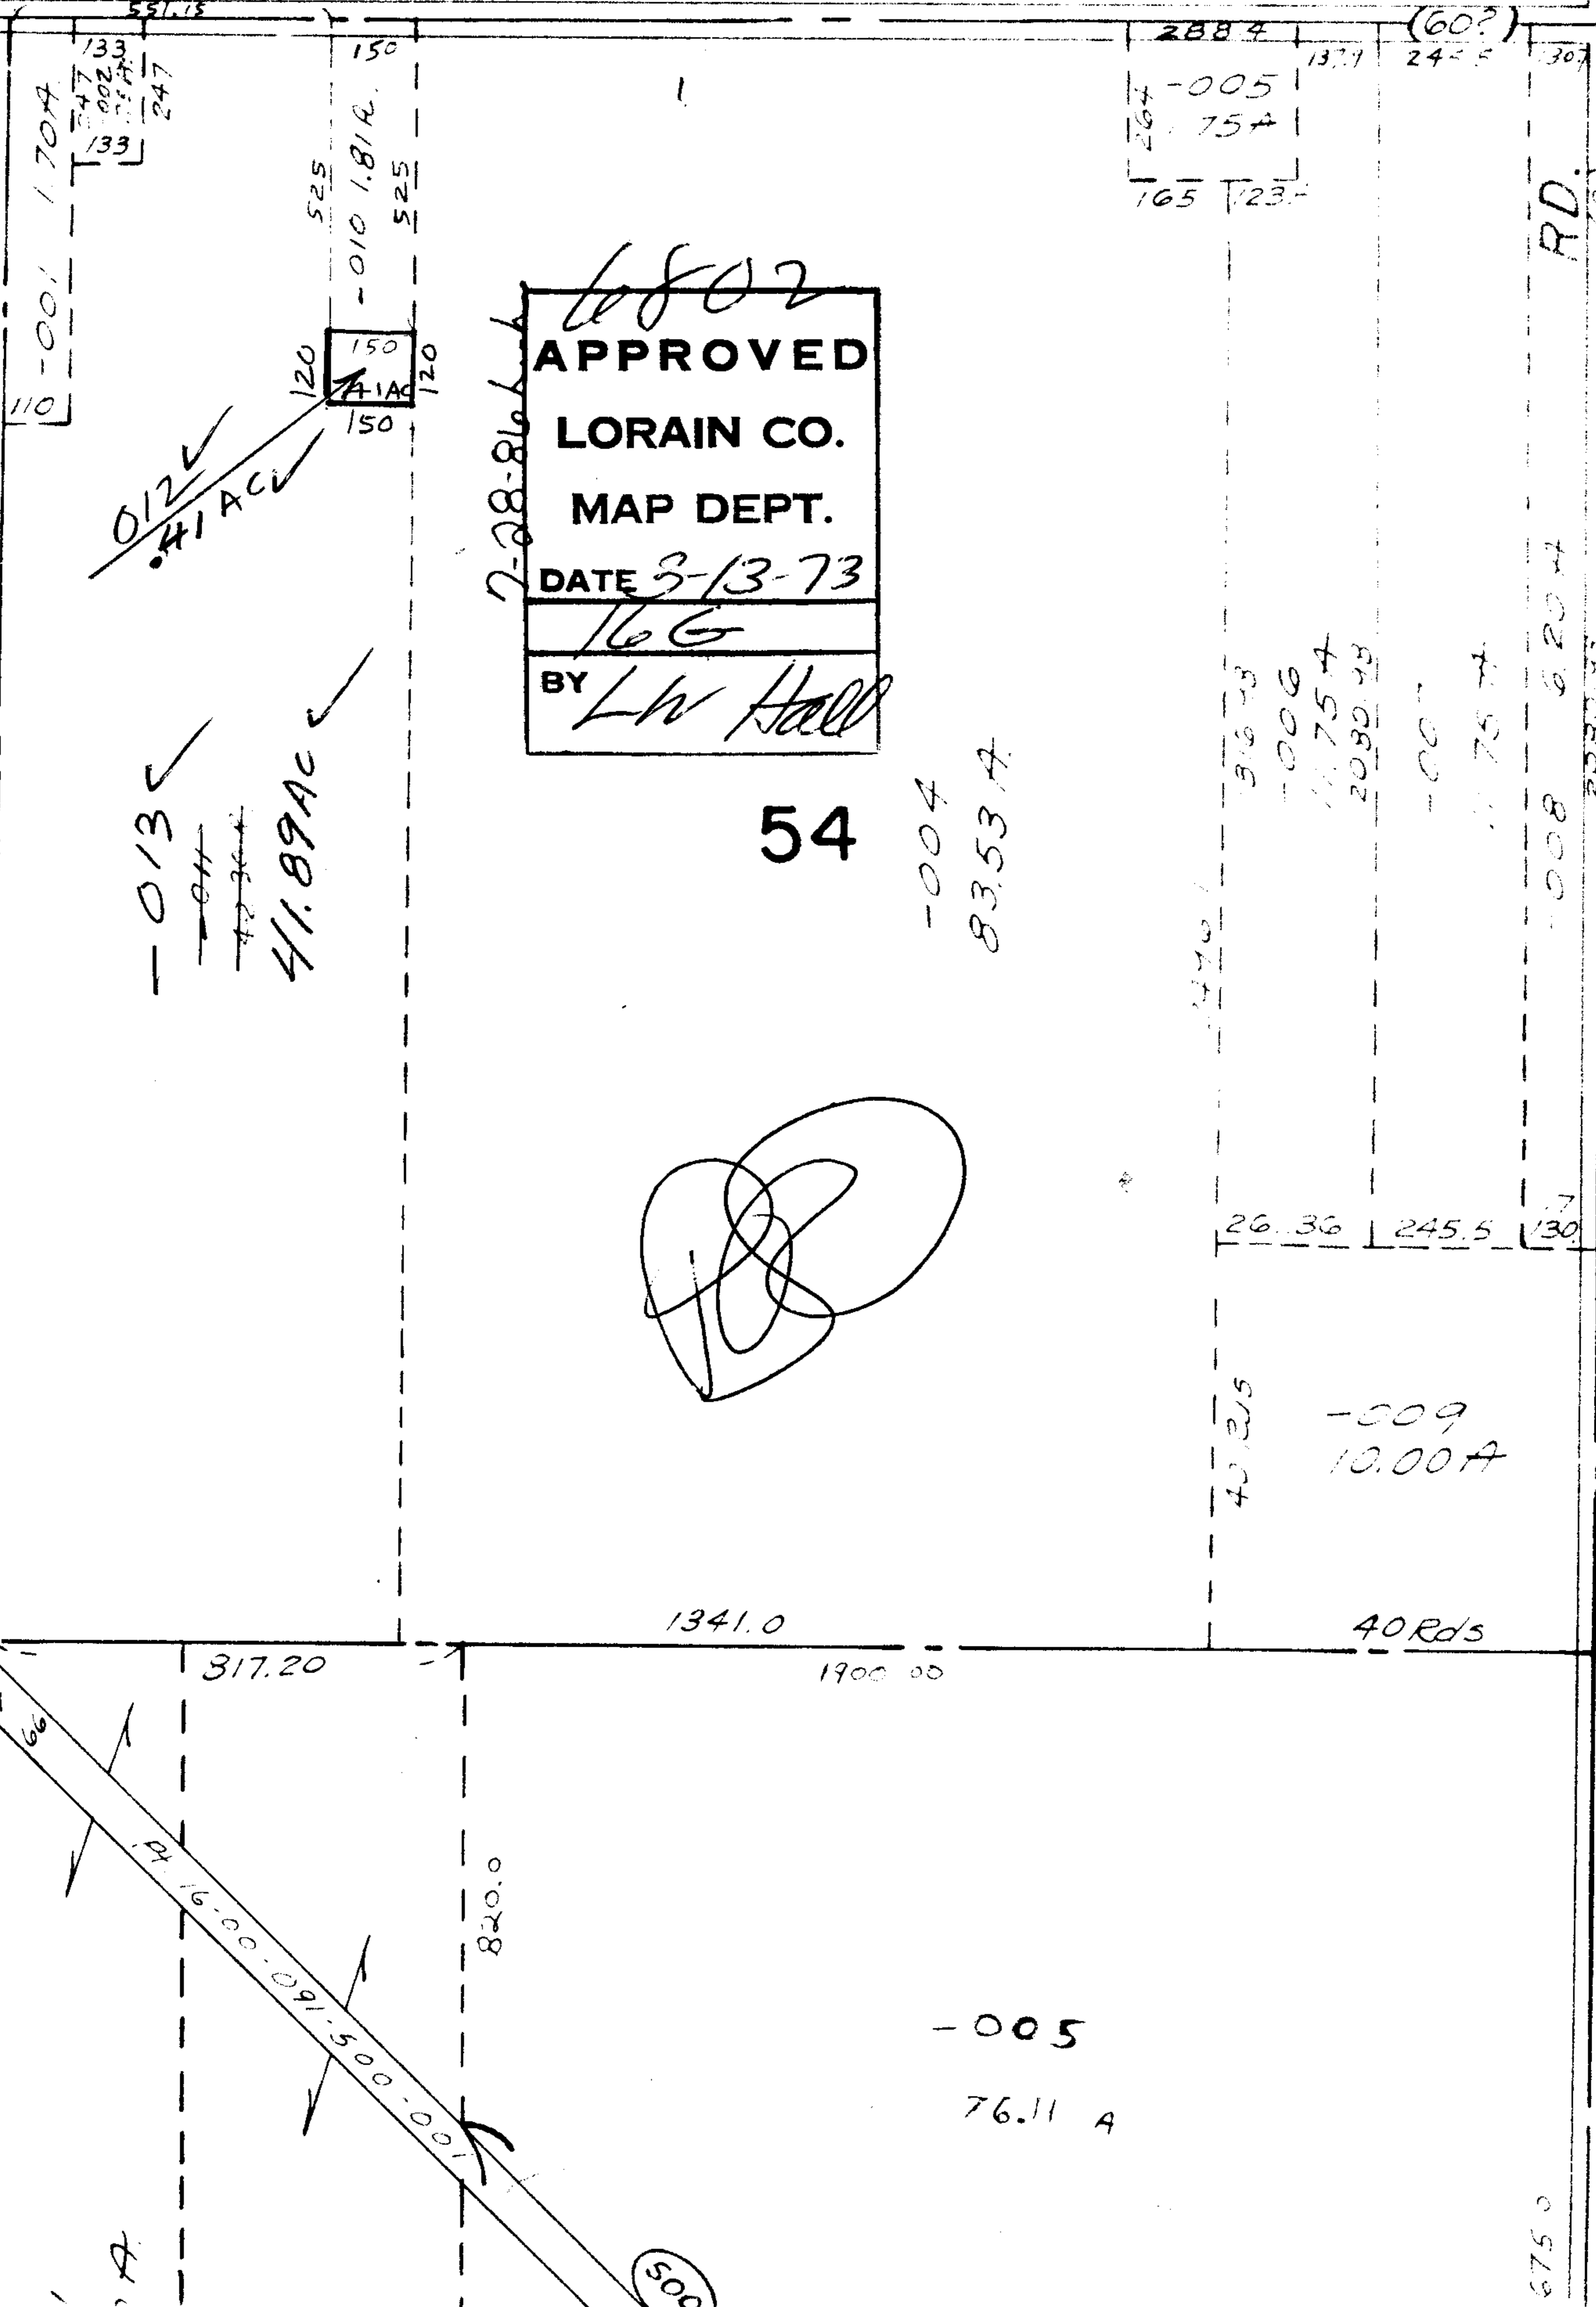

6802
APPROVED
LORAIN CO.
MAP DEPT.
DATE 3-13-73
 166
 BY *LW Hall*

54

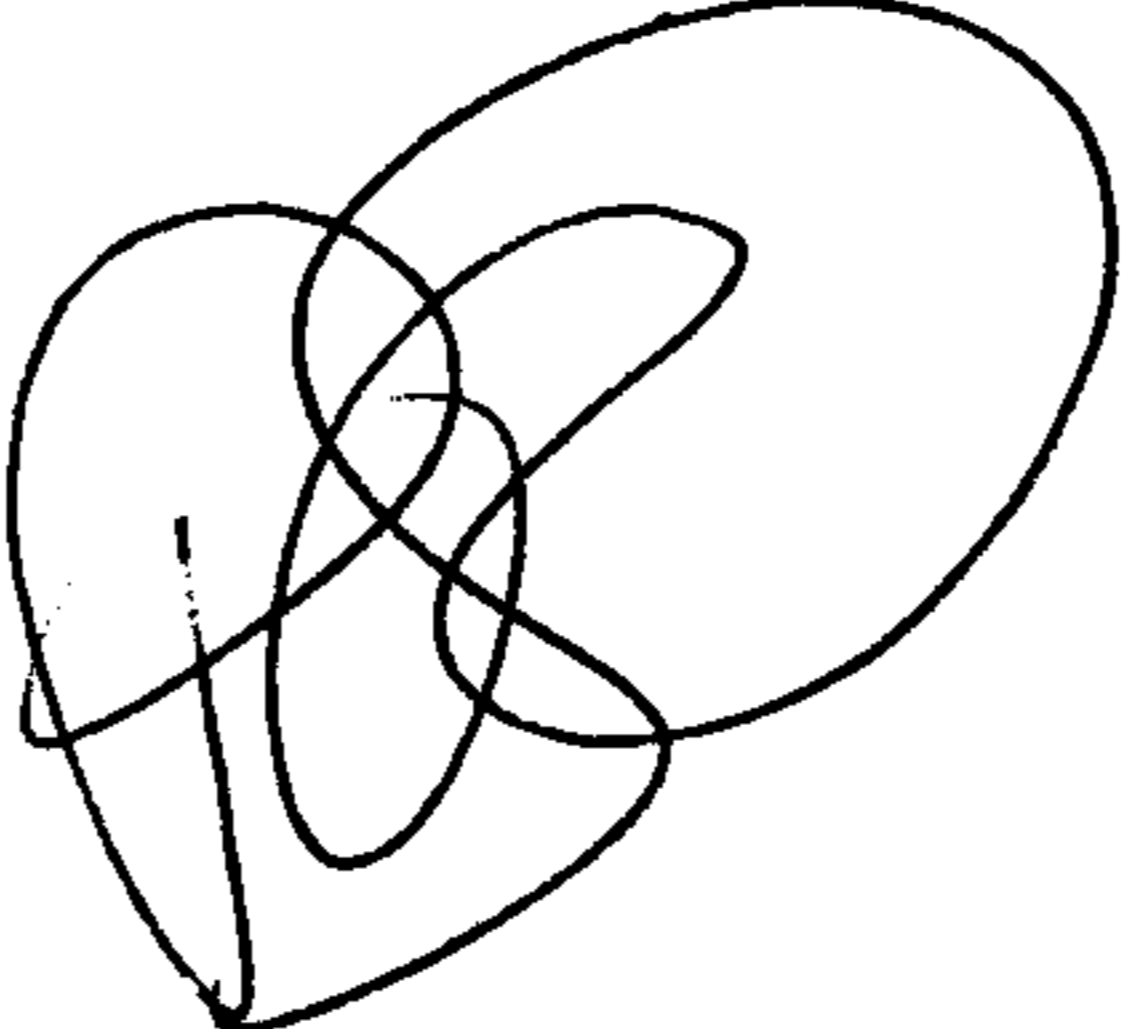

133 247 133

110-001 170A

012V
41 ACV

-013V

41.89 ACV

525 150 -010 1.81A 525 120 150 120

2-28-86

2884 -005 75A 165 123

(60?)

-004 83.53 A

916.73 -006 11.75 A 2090.43

-007 11.75 A

26.36 245.5 17 130

40.25 -009 10.00 A

40 Rds

1341.0

1900.00

820.0

-005 76.11 A

228.30 230.42 230 230

A

500

6750

RD.

RD.

RD.