

-043
10.31A

6826

059
~~057~~
~~16.32A~~
14.79A 6826


C-M-OX

PRS

6-109

6826
APPROVED
LORAIN CO.
MAP DEPT.
DATE 3-19-73
6-110
BY LW Hall

6-110

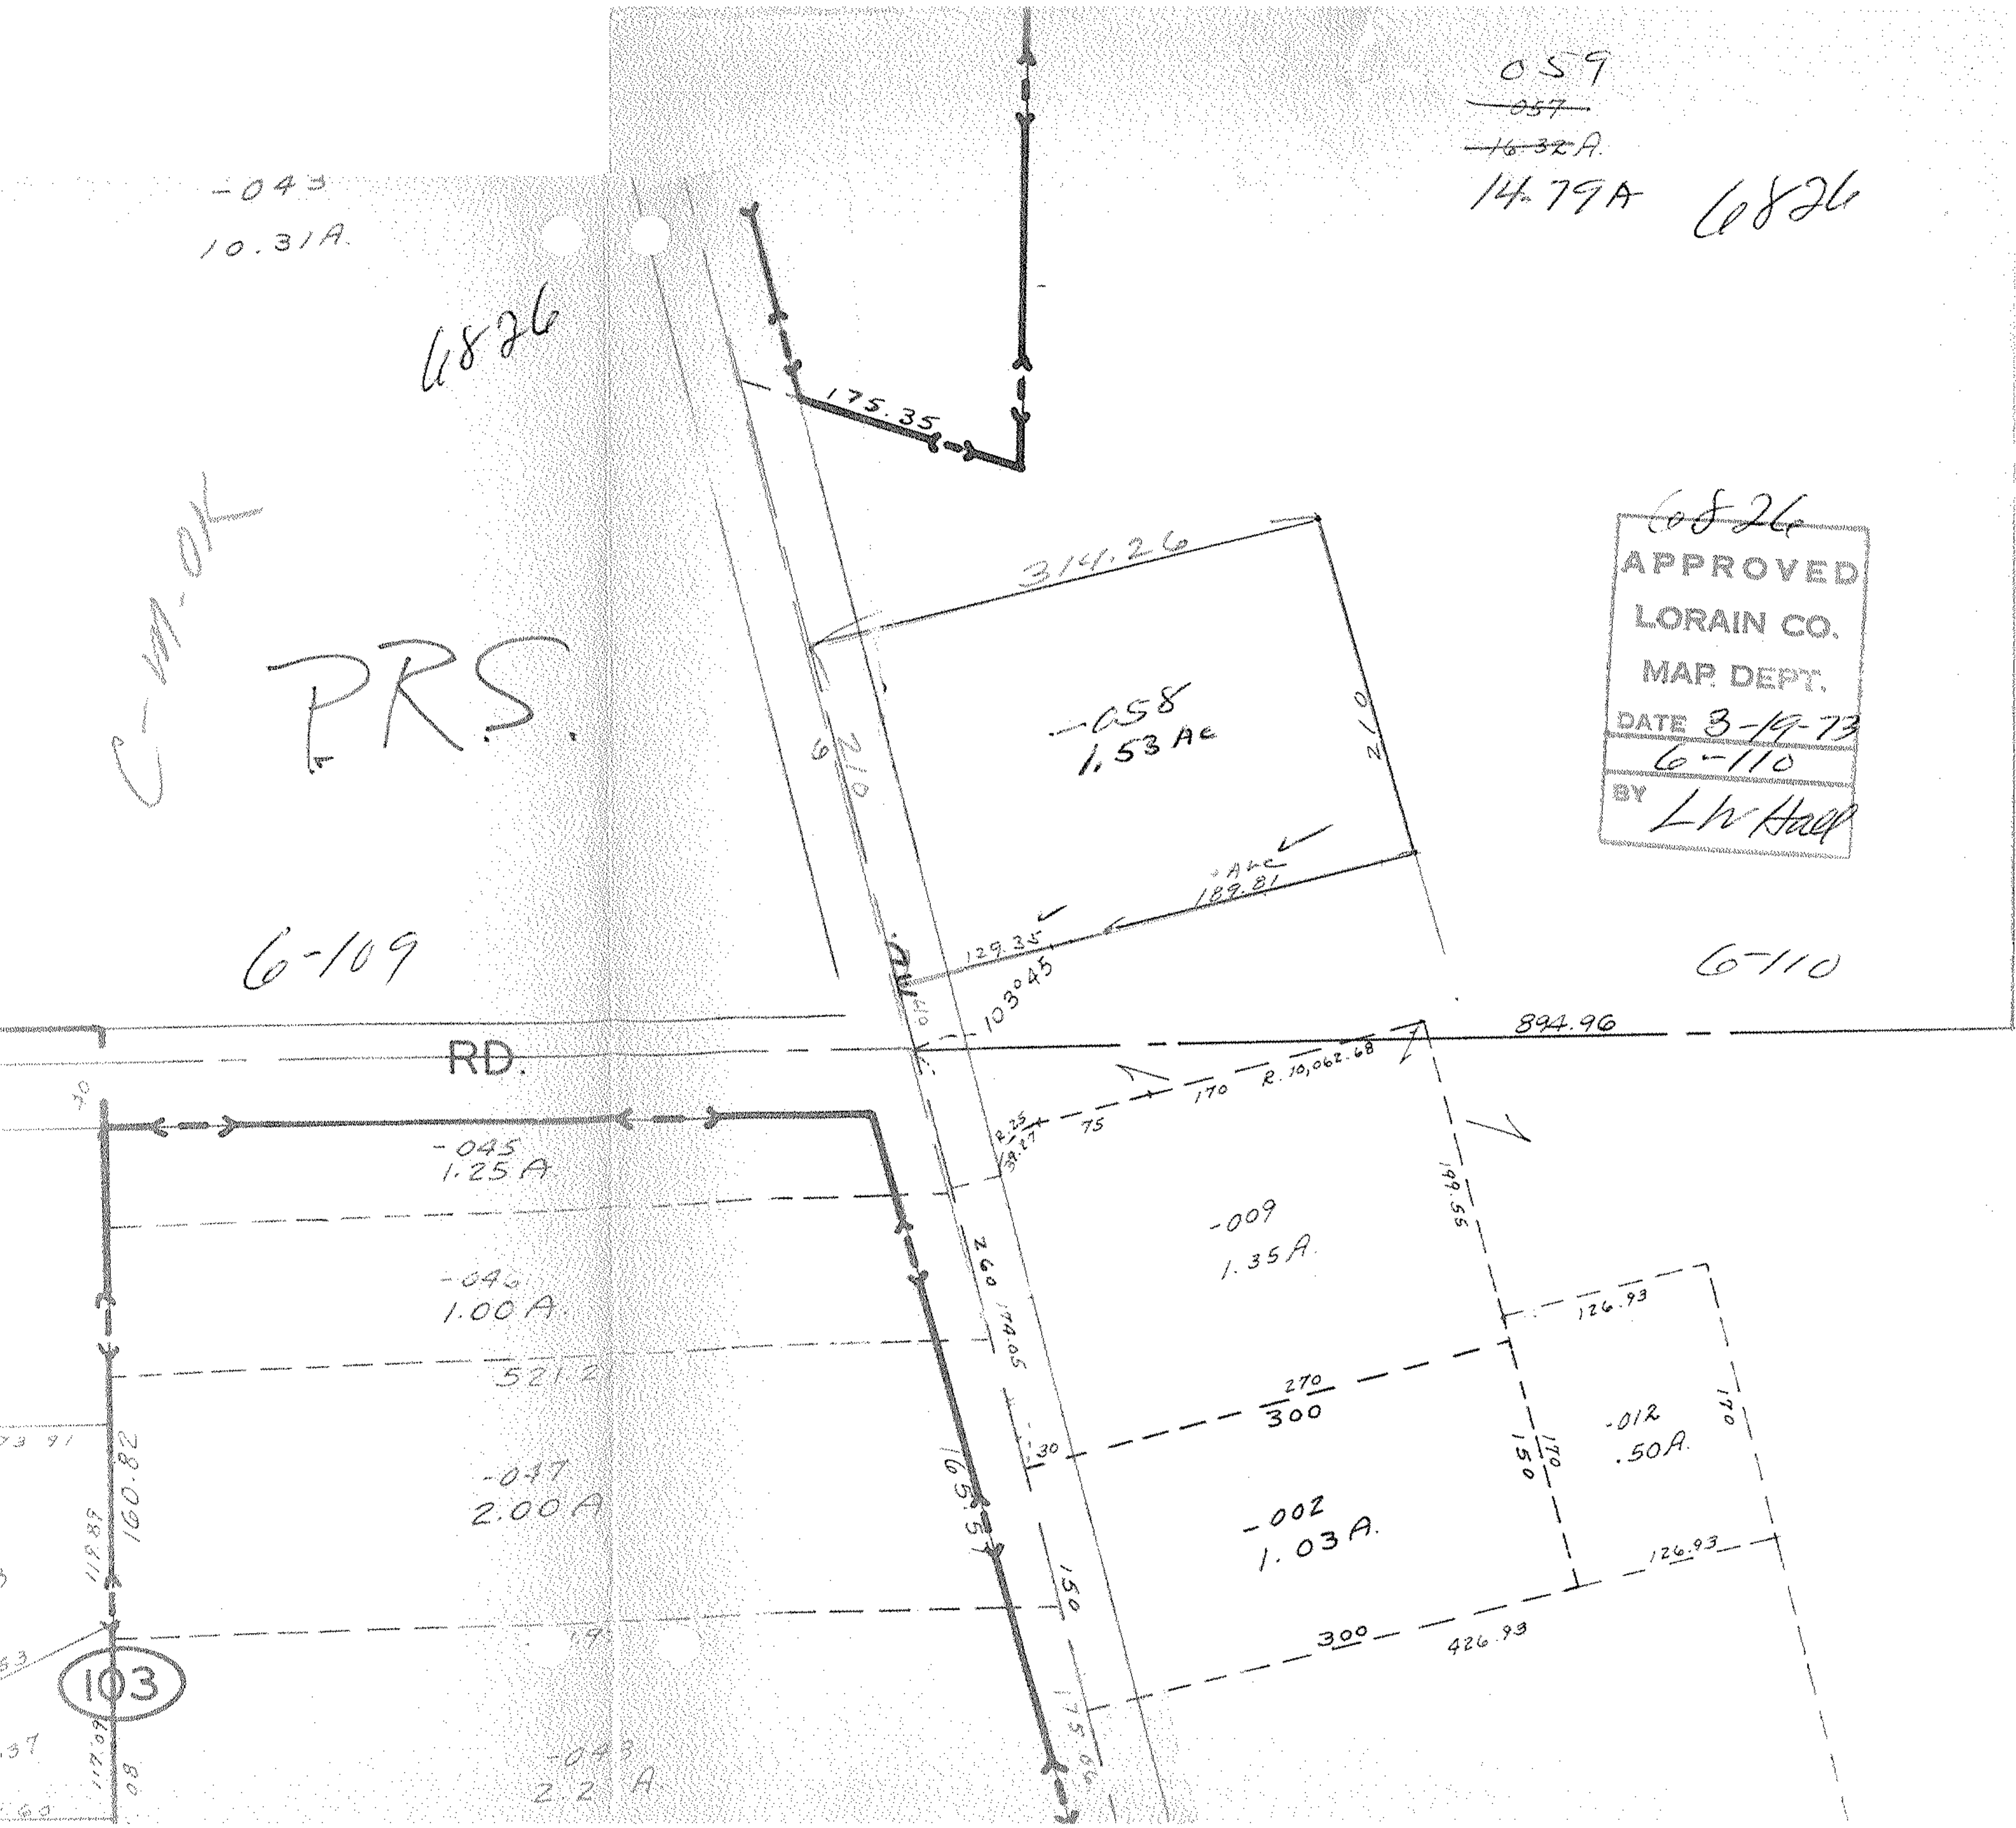

-045
1.25 A

-046
1.00 A

-047
2.00 A

-048
2.2 A

-058
1.53 Ae

-009
1.35 A

-002
1.03 A

-012
.50 A

RD.

103

175.35

314.26

210

210

129.35

103.45

894.96

260
174.05

165.57

150

175.66

R. 25
S. 27
75
170
R. 10,062.68

199.55

126.93

270
300

150

170

300

426.93

126.93