


6873

C.M. OF T.P.S.

192.08
100
92.05

SEE 2-02-0

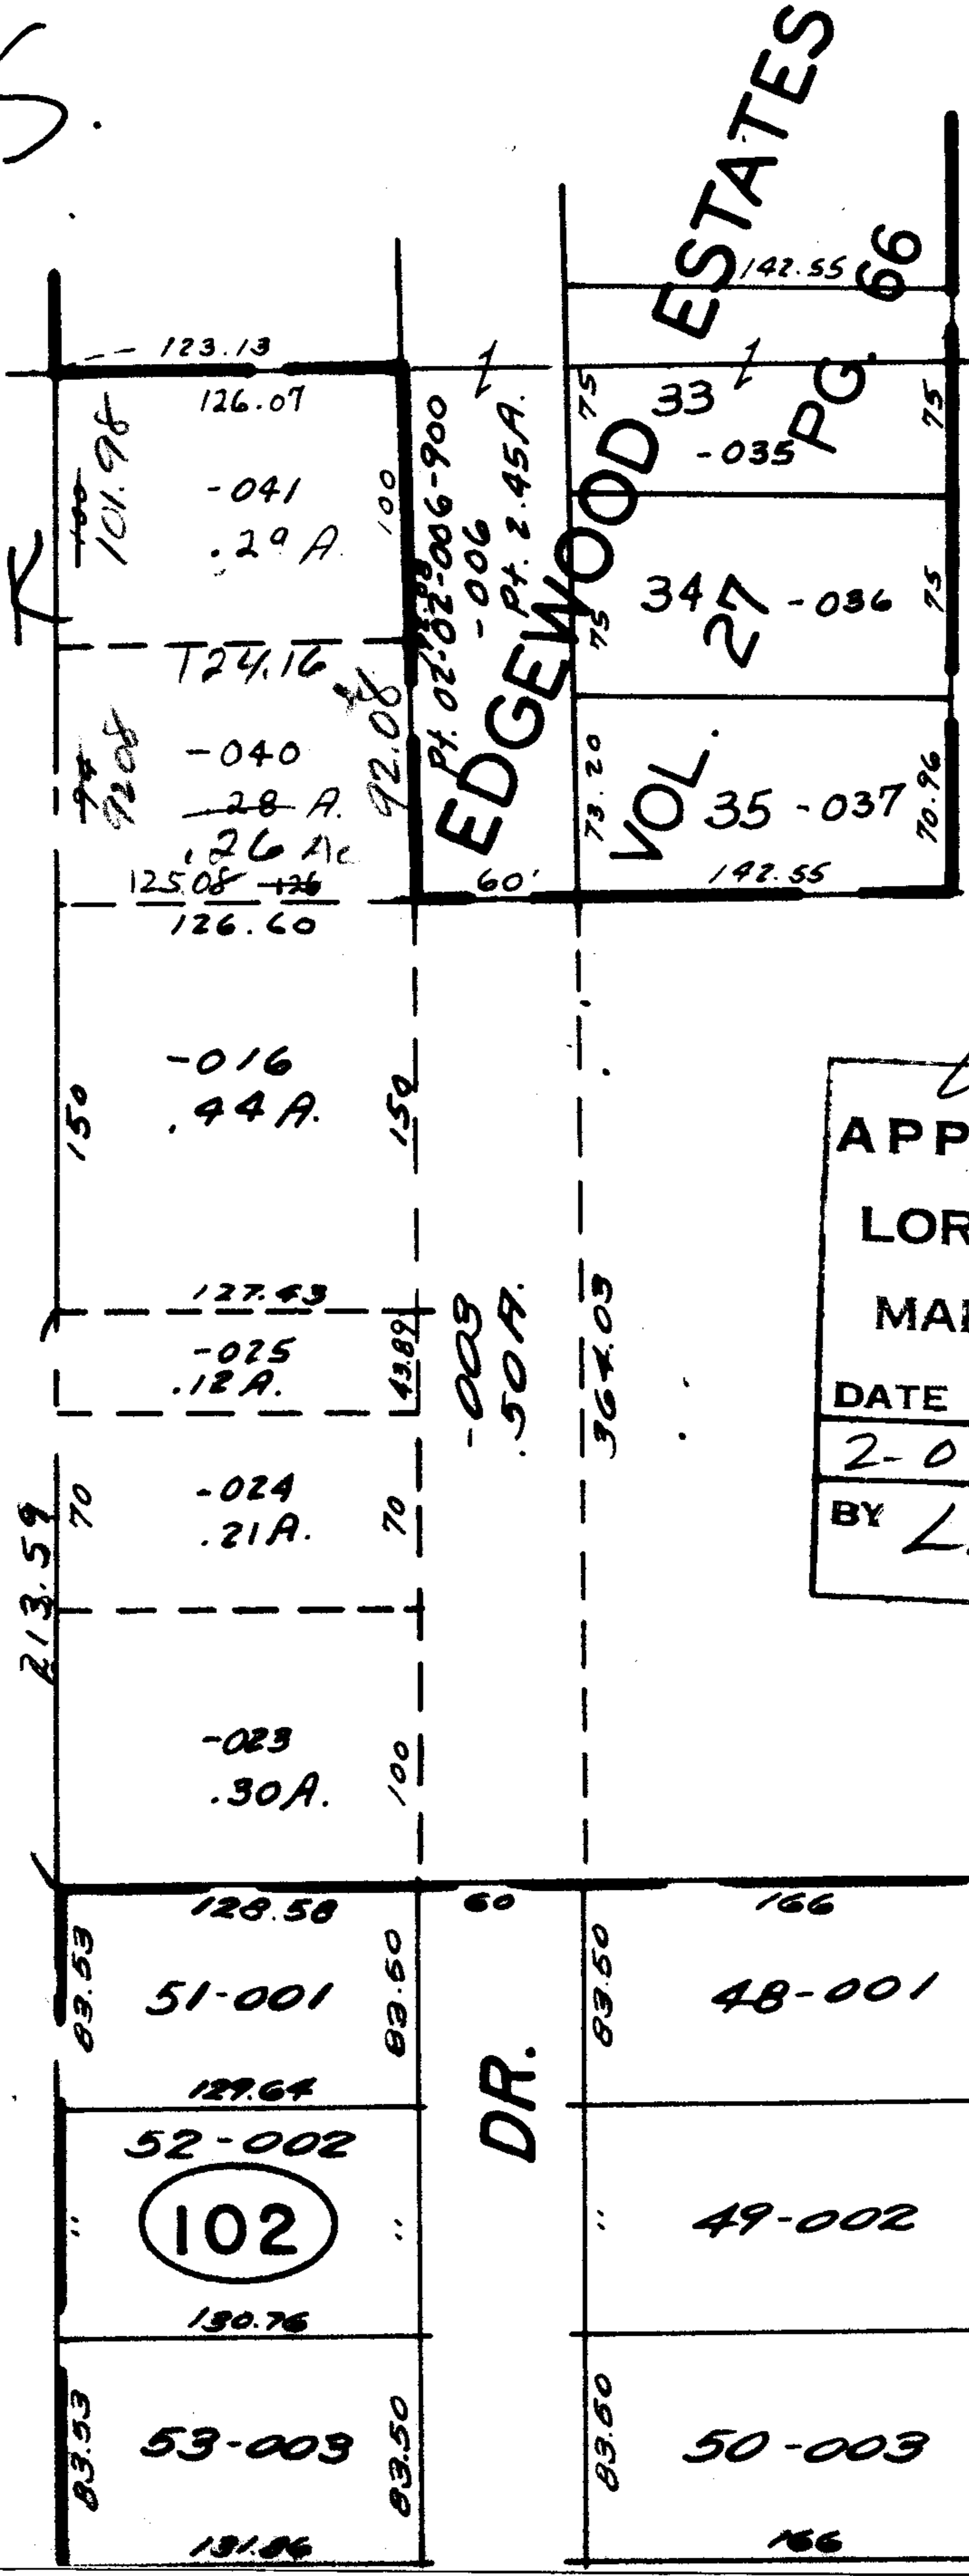

6873
 APPROVED
 LORAIN CO.
 MAP DEPT.
 DATE 4-4-73
 2-02-005A
 BY L.V. HALL

2-02-005-A

817

45 (10)