


6880

1/1

09

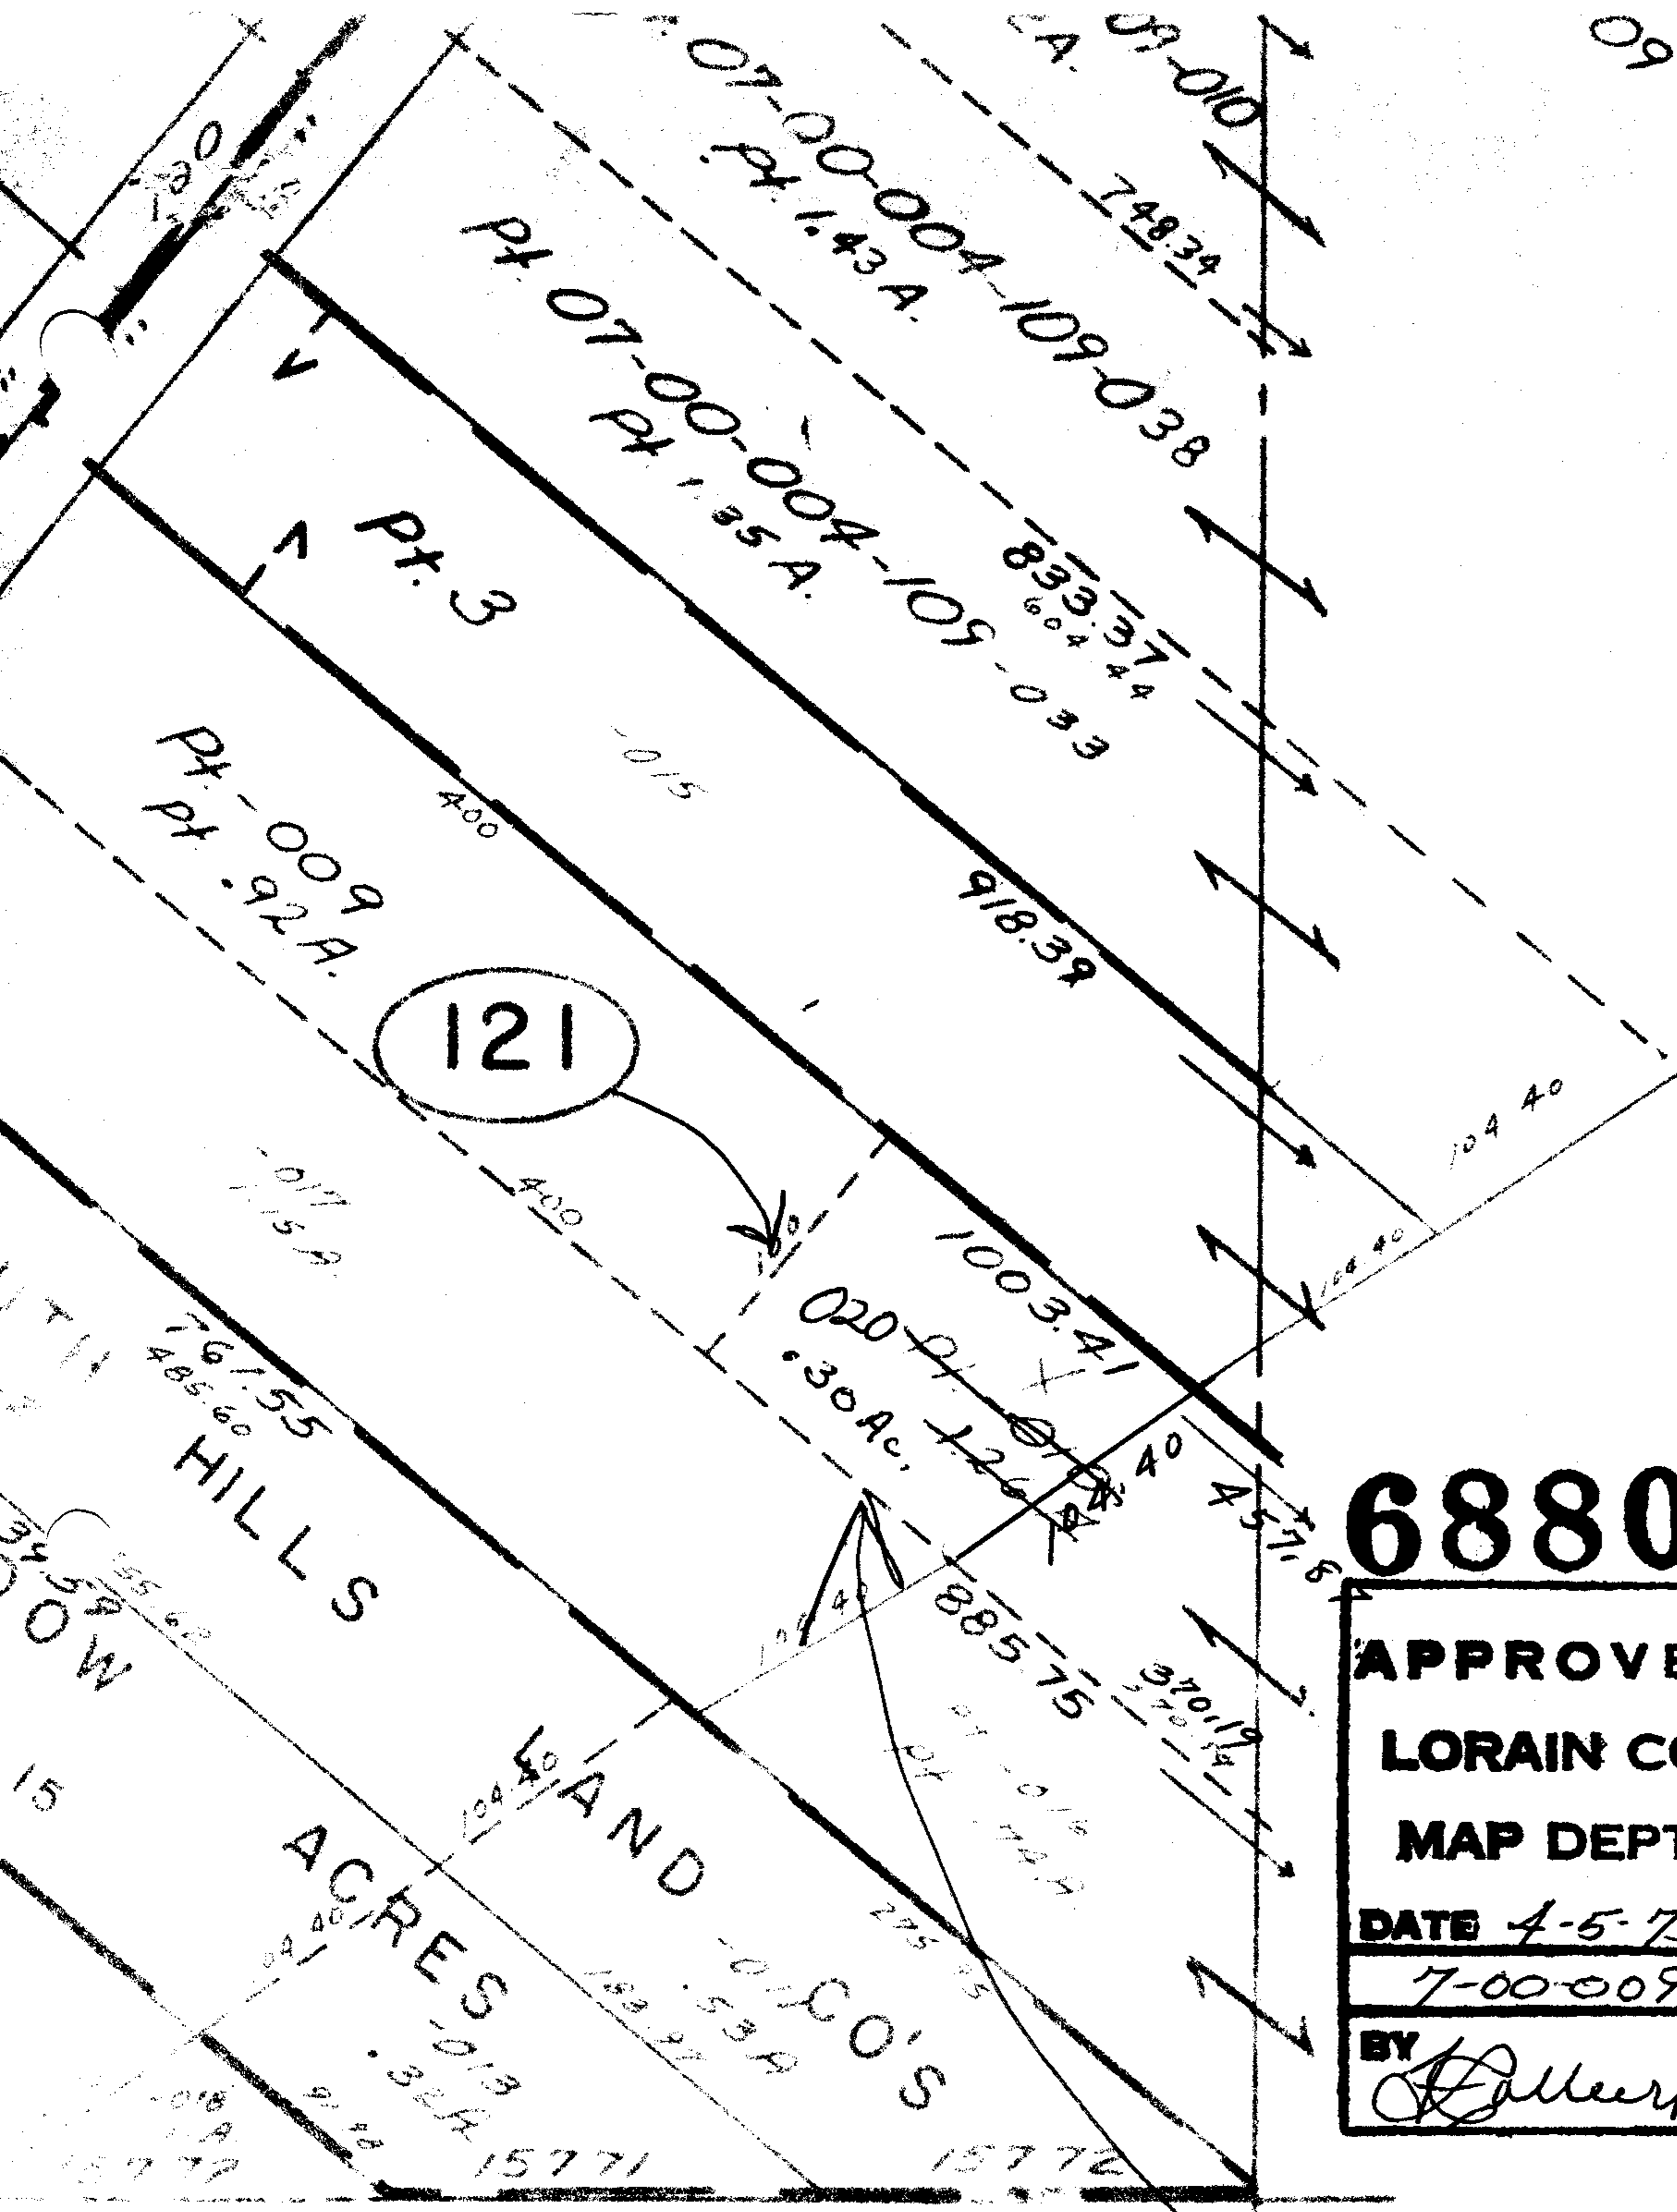

6880

APPROVED
LORAIN CO.
MAP DEPT.
DATE 4-5-73
7-00-009-D
BY <i>Ballert</i>

7-21-86
K.Y.

P.R.S. C-M-OK

LOT 9

7-00-009-

Copyright 1964
Revised 3-1-75