


PRS

6889
APPROVED
LORAIN CO.
MAP DEPT.
DATE 4-9-73
05-00-012A
BY LW Hall

50x218
V 989 Pg 722

148x218
DV 169 Pg 329

C-M-OK

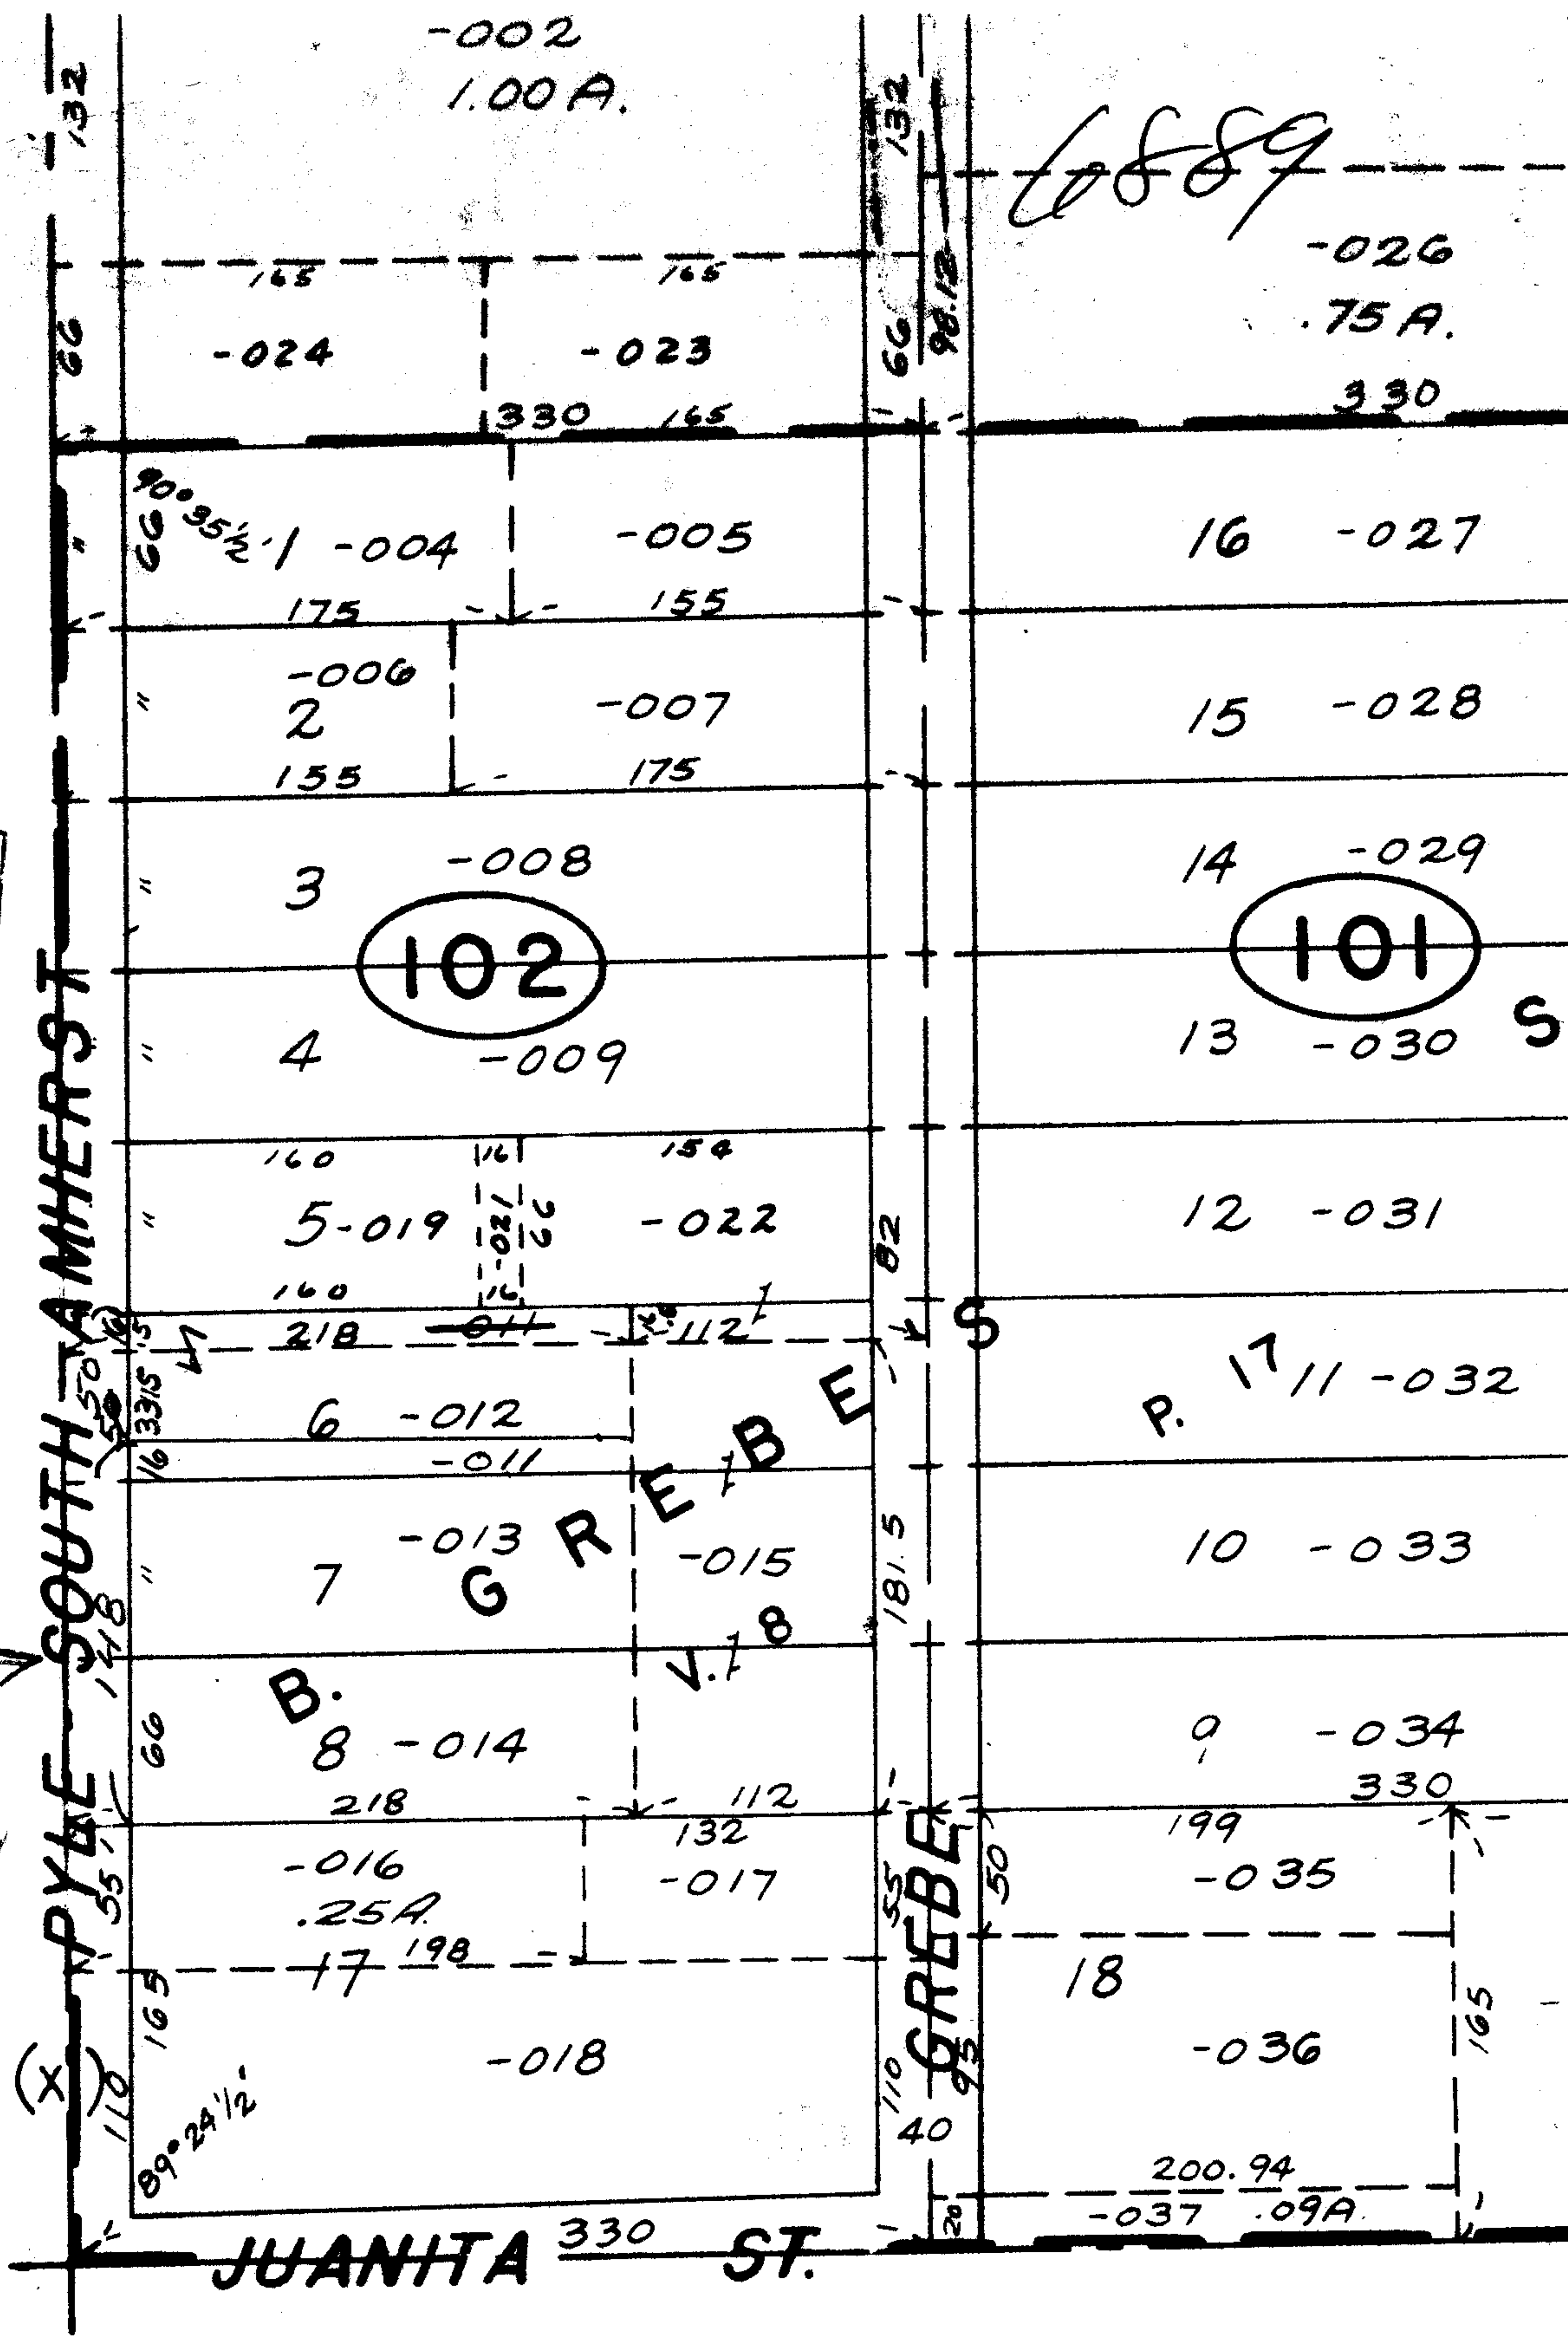

Copyright 1963 by
Revised 9-11-72

5-00-012-A

AMHERST
SCALE: 1" = 100'